



02-02-023-107-016
02-07-023-B

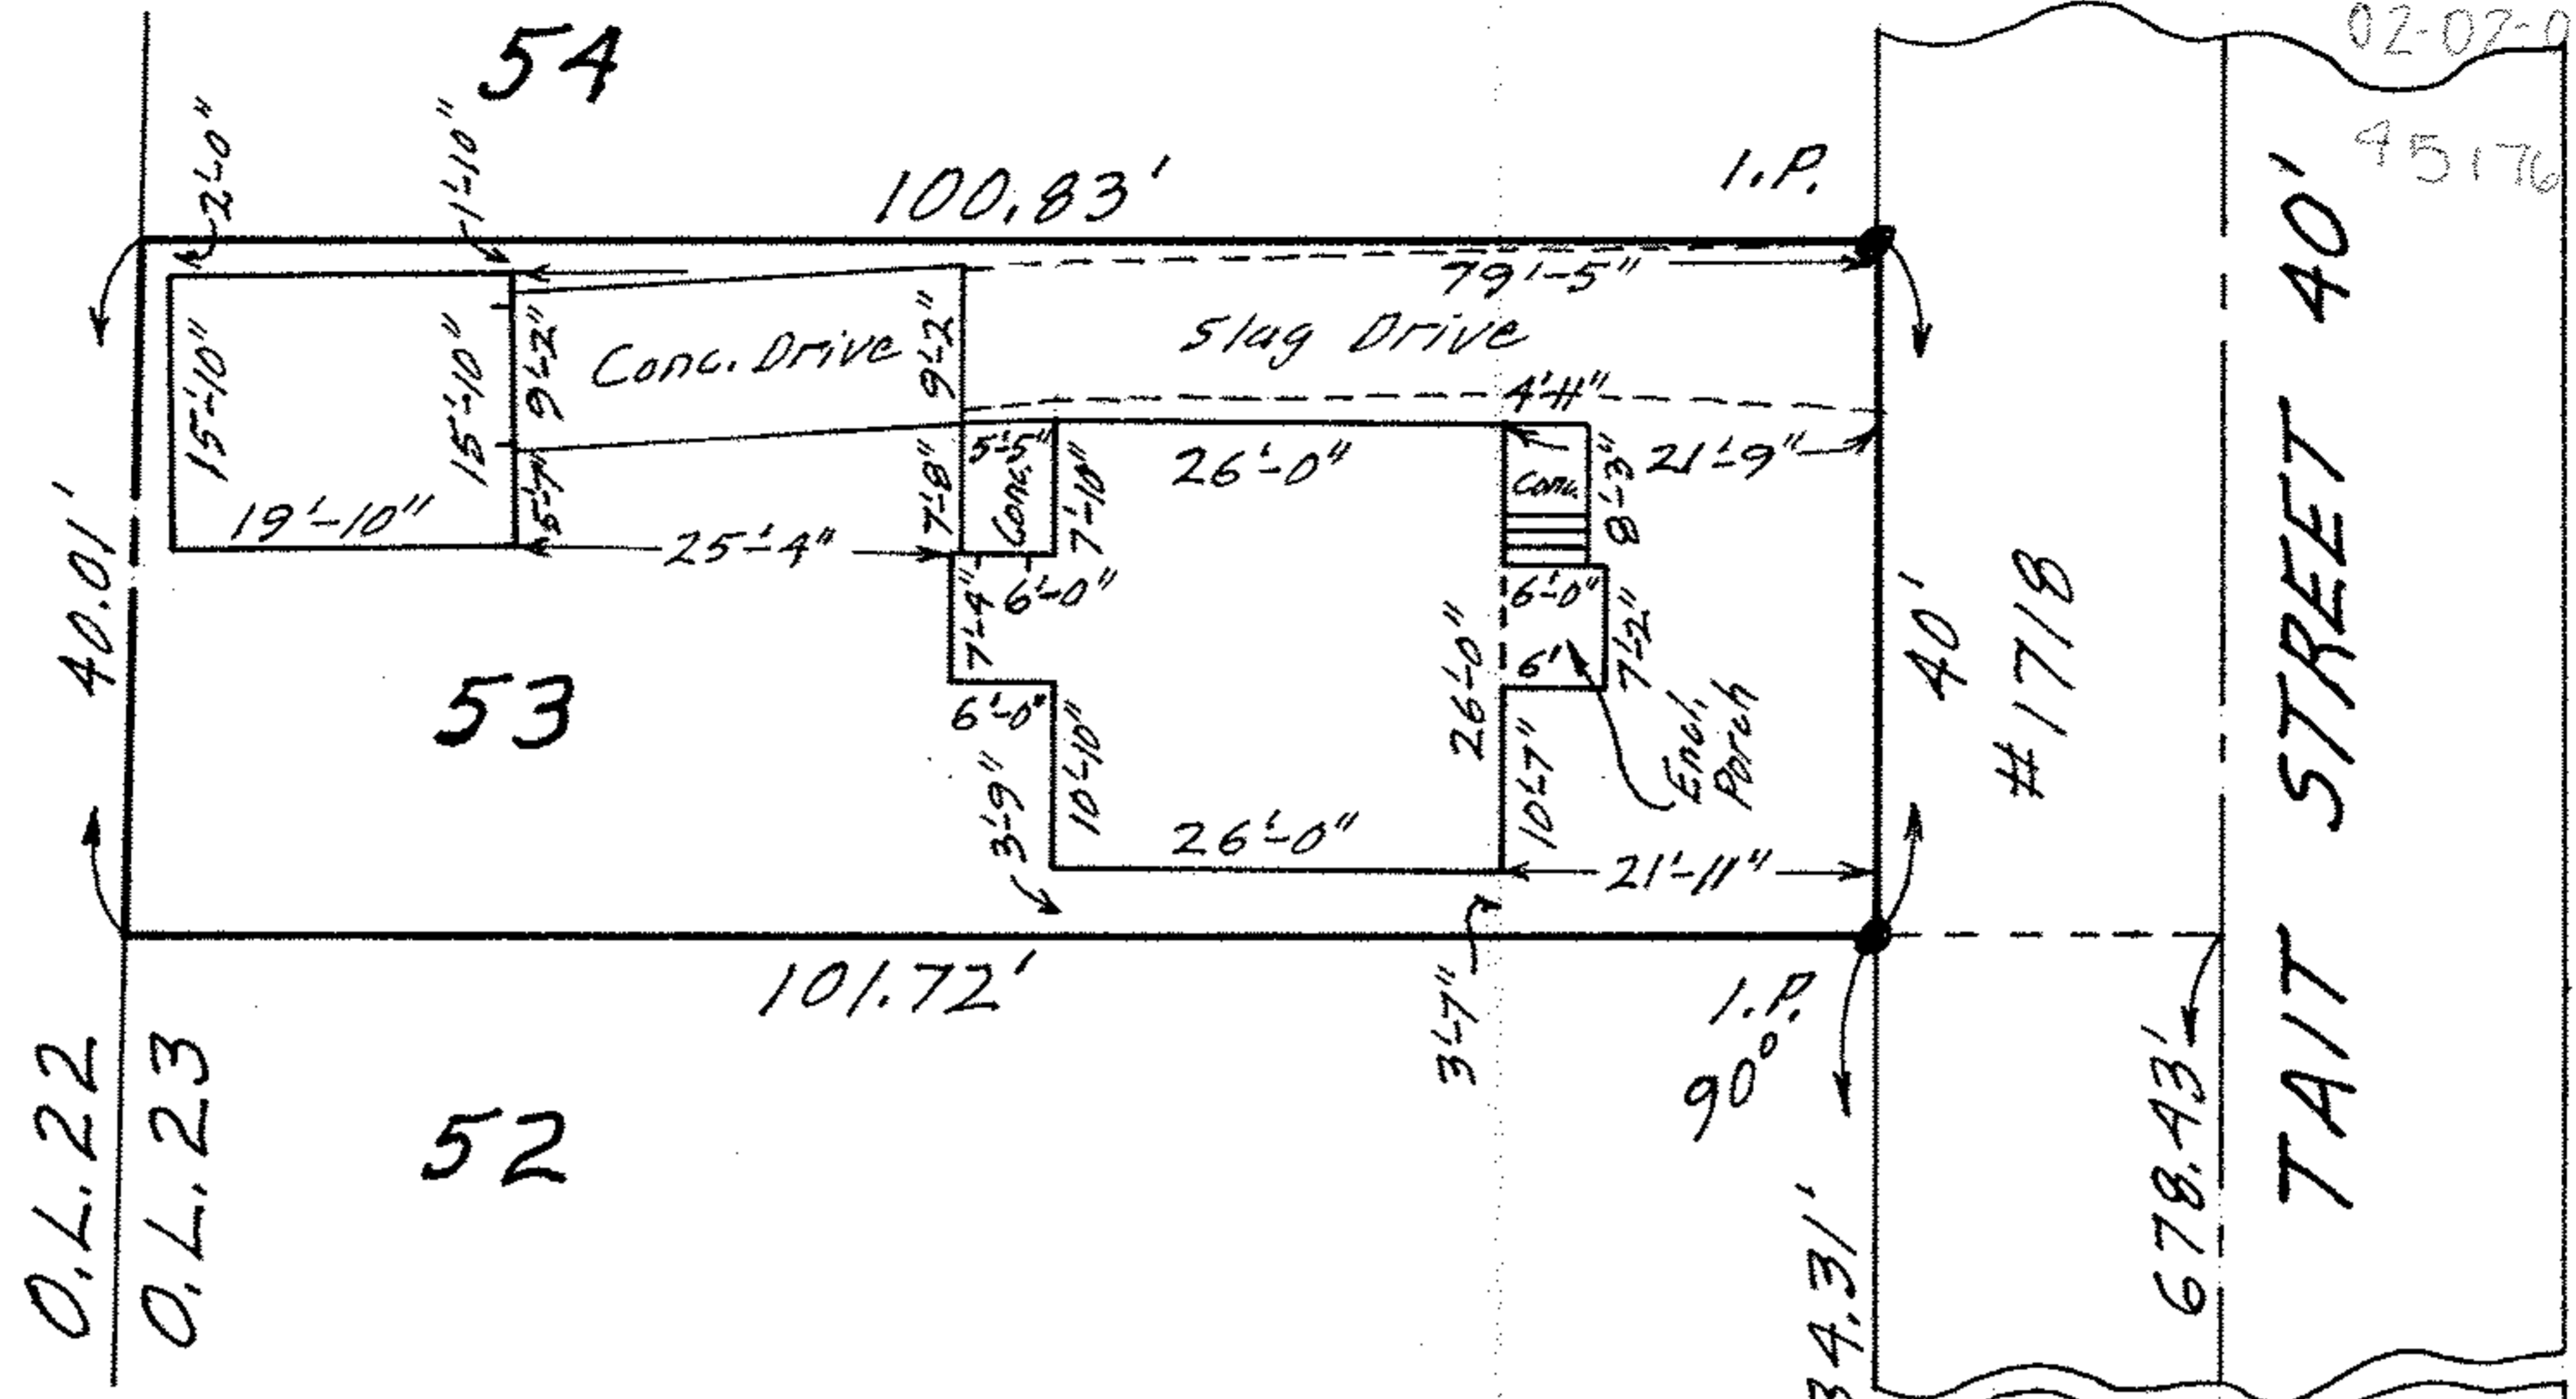

MAP OF SUB-LOT NO. 53
 LAKE VIEW ALL'T. VOL. 6 Pgs. 9 & 10
 ORIG. LOT NO. 23 TRACT NO. 2
 BLACK RIVER TWP. - LORAIN CITY
 LORAIN COUNTY - OHIO
 SCALE: 1" = 20' OCT. 31-1969 4:30 P.M.
 NOTE: There are no encroachments
 on the above property.
 Gary E. Penfound REG. SURVEYOR NO. 4457
 CITY TITLE CO. Order No. E-926-7
 Profant to Amon

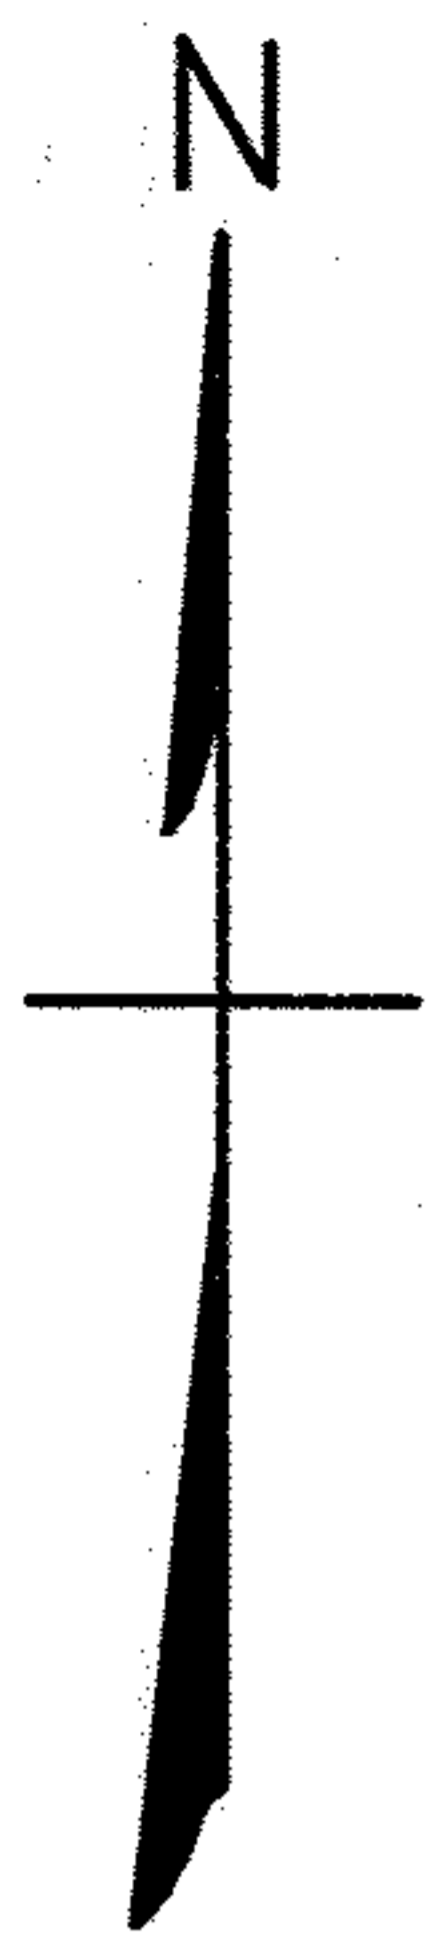