
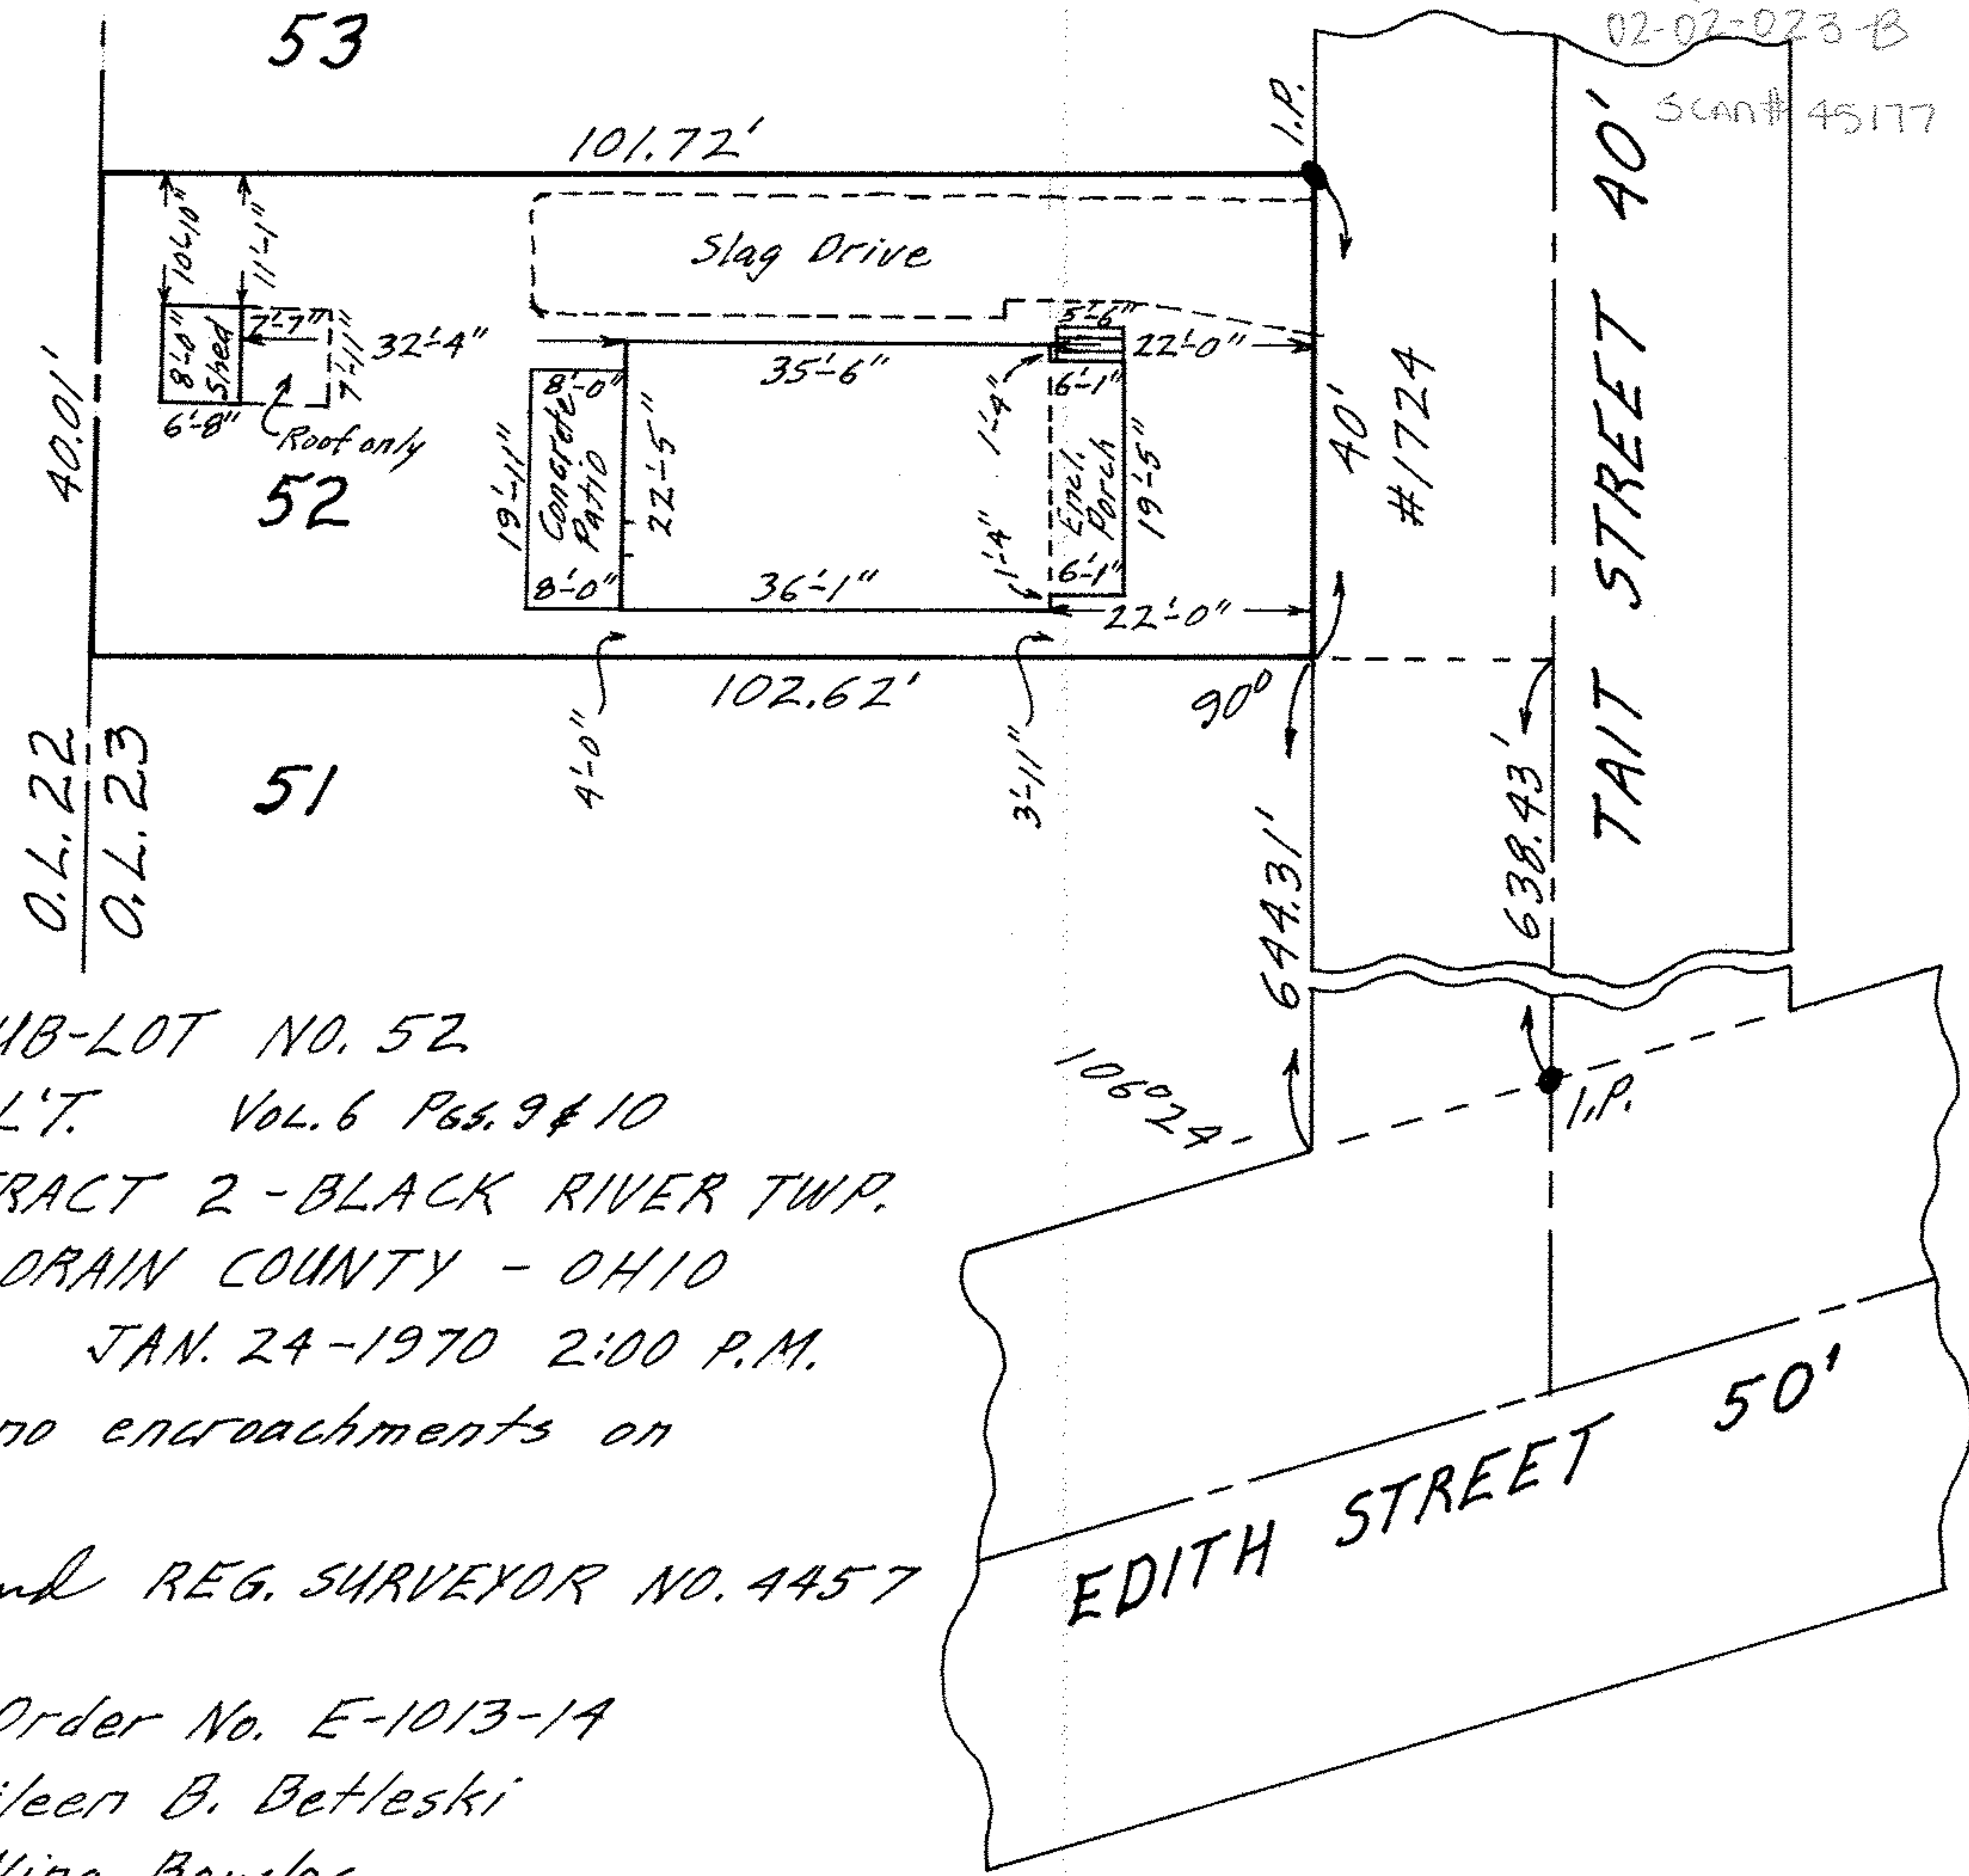


02-02-023-107-017

02-02-023-B

SCAN# 45177

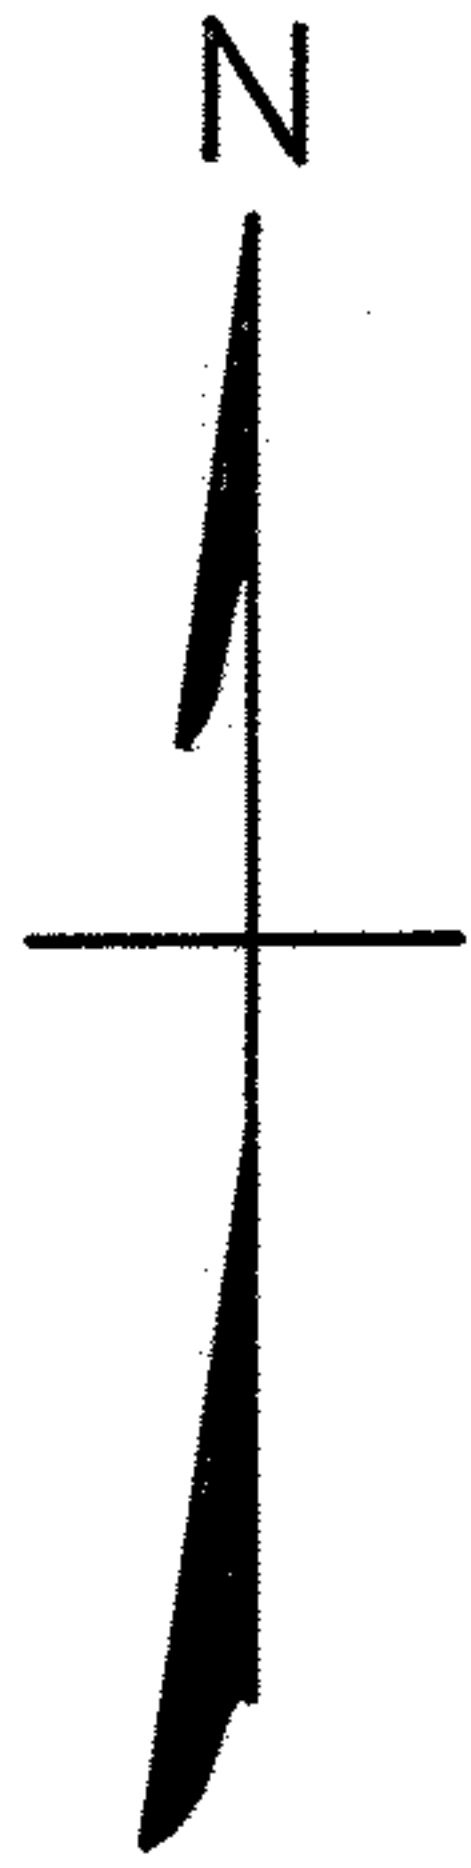

MAP OF SUB-LOT NO. 52

LAKE VIEW ALL'T. Vol. 6 Pgs. 9 & 10
 ORIG. LOT 23 - TRACT 2 - BLACK RIVER TWP.
 LORAIN CITY - LORAIN COUNTY - OHIO
 SCALE: 1" = 20' JAN. 24 - 1970 2:00 P.M.

NOTE: There are no encroachments on
 this property.
 Gary E. Penfound REG. SURVEYOR NO. 4457

CITY TITLE Co. Order No. E-1013-1A
 Adrian F. & Eileen B. Betleski
 to John V. & Nina Bowles