


02-02-023-107-0317033
02-02-023-0

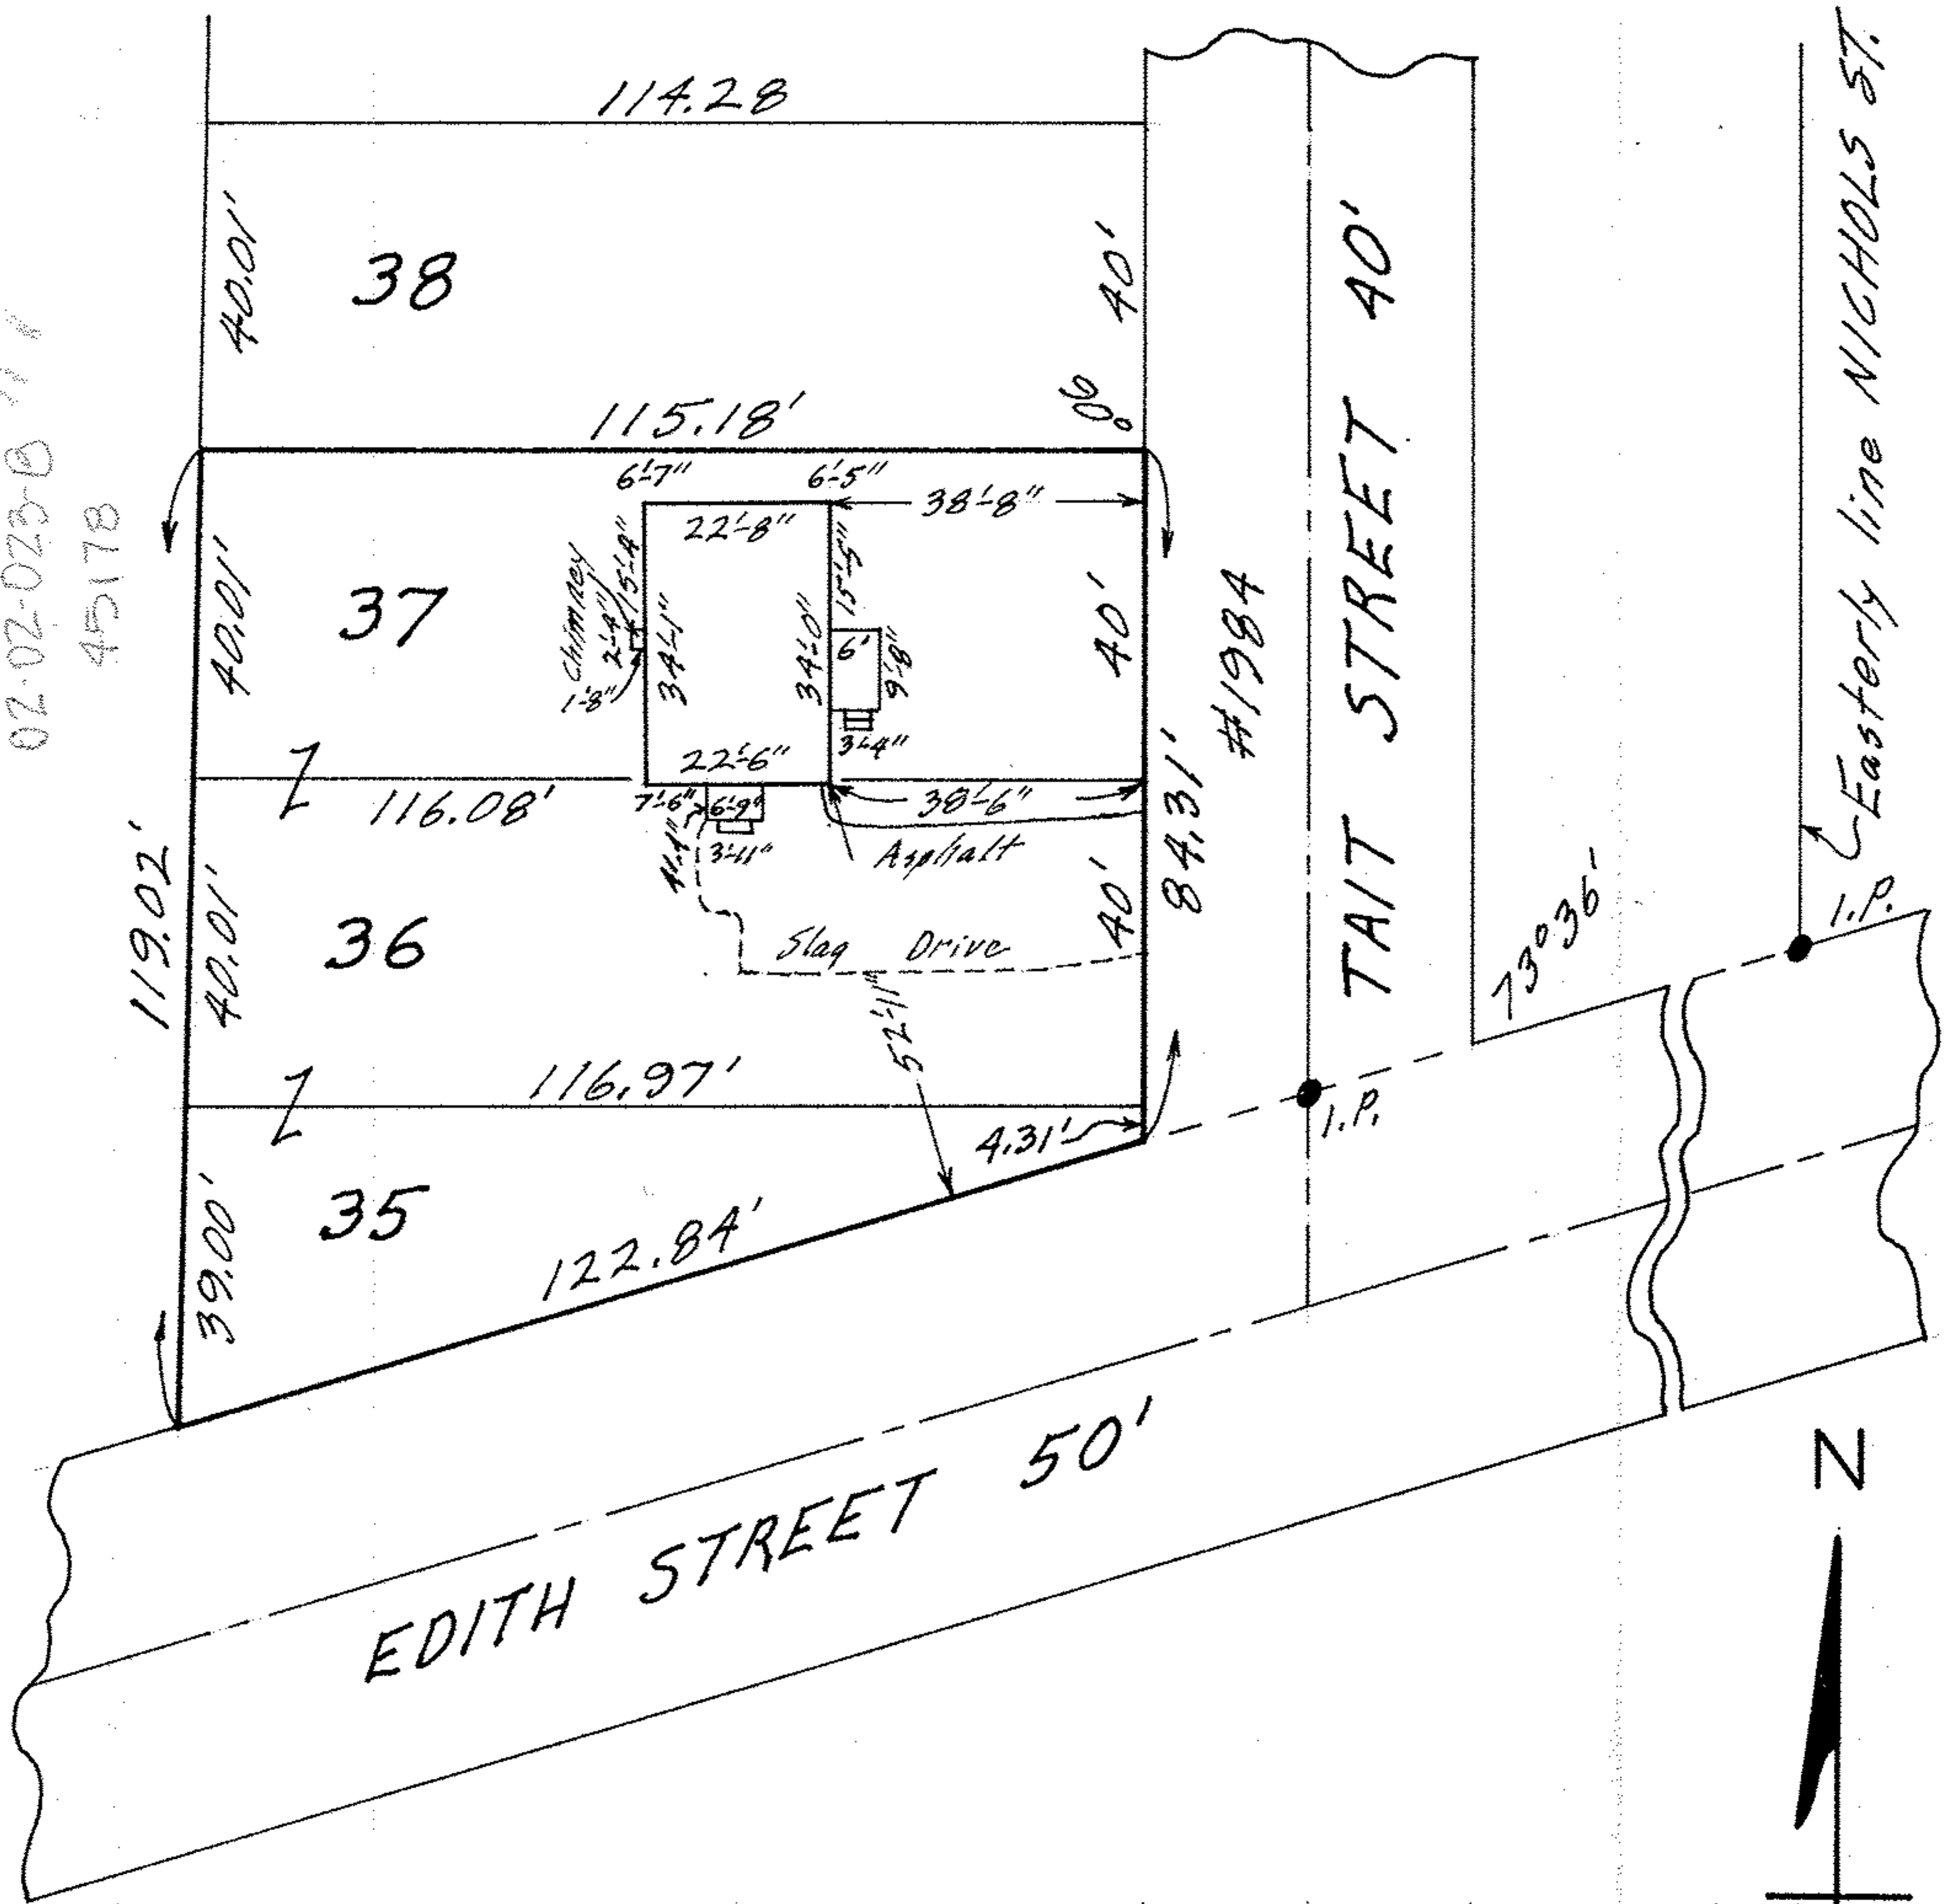

MAP OF SUB-LOTS NOS. 35-36 & 37
 LAKE VIEW ALL'T. VOL. 6 Pgs. 9 & 10
 ORIG. LOT 23 - TRACT 2 - BLACK RIVER TWP.
 LORAIN CITY - LORAIN COUNTY - OHIO
 SCALE: 1" = 30' SEPT. 8 - 1968 5:30 P.M.
 Gary E. Penfound REG. SURVEYOR

Colleen M. Zboran