


02-02-023-110-001-003
02-02-023-110-001-003
Scan# 45181

GRACE STREET 40'

I.P.

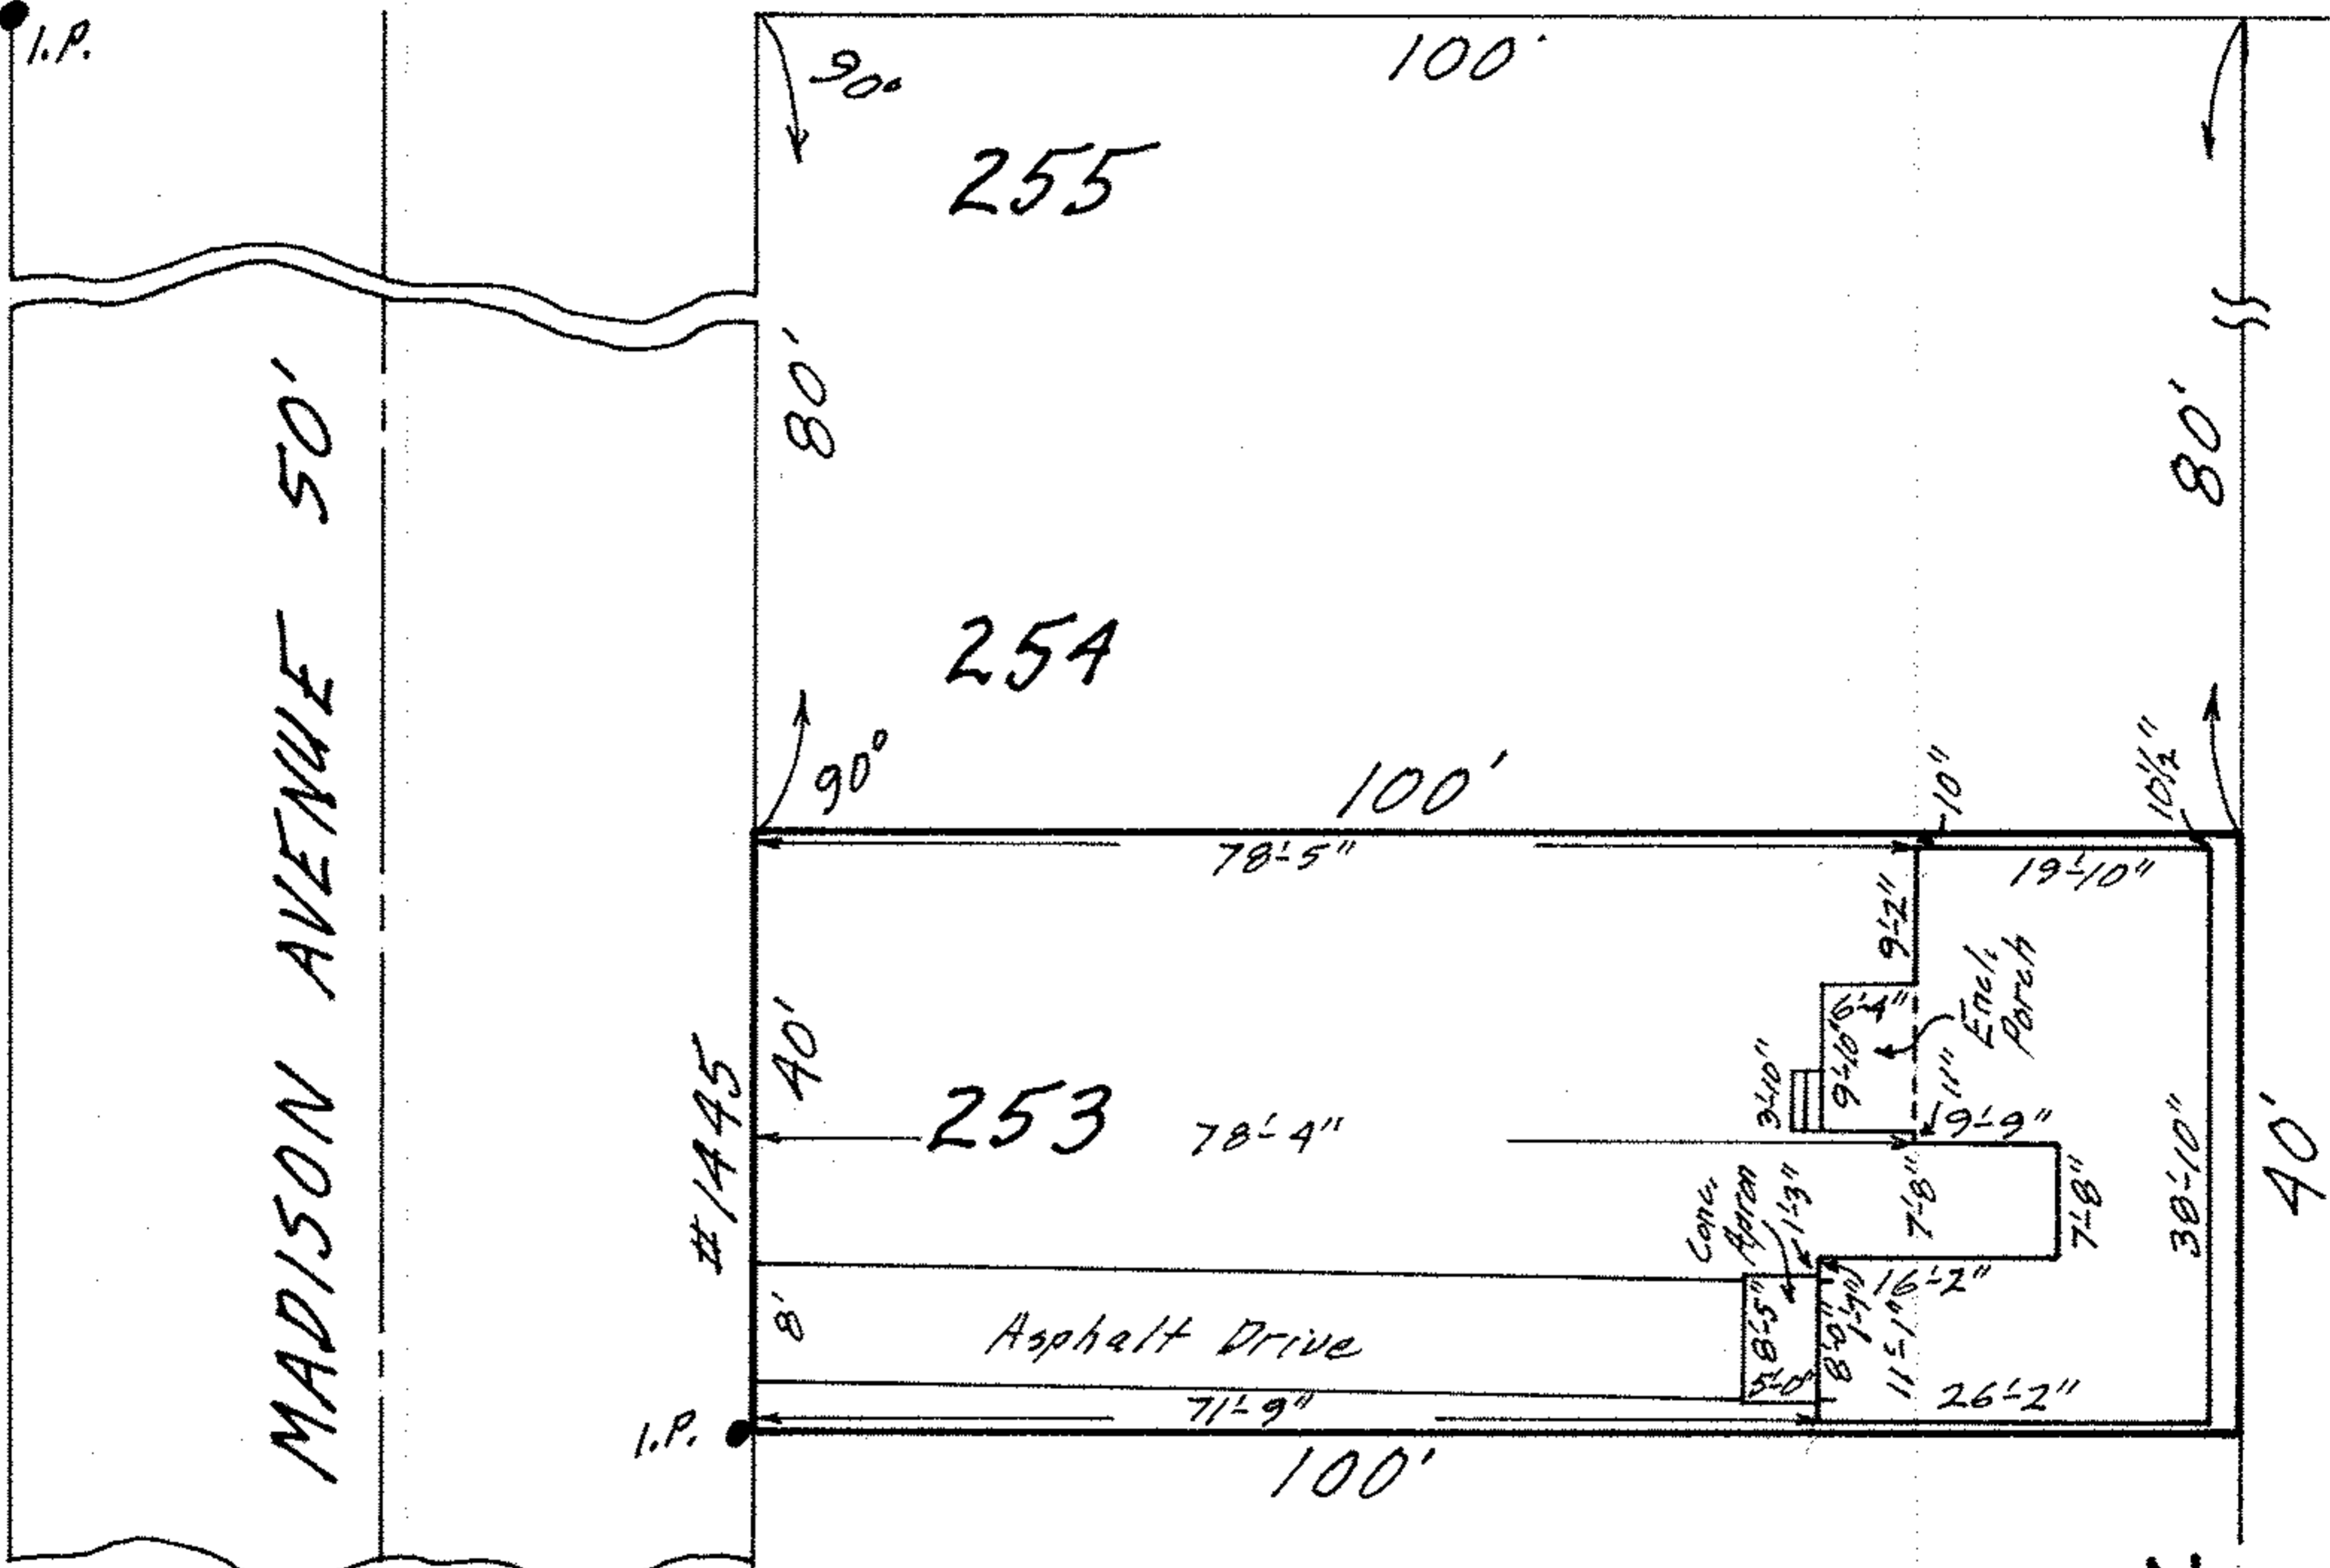

MAP OF SUB-LOT NO. 253

LAKE VIEW ALL'T. Vol. 6 Pgs. 9 & 10

O.L. 23 TRACT 2 BLACK RIVER TWP.

LORAIN CITY - LORAIN COUNTY - OHIO

SCALE: 1" = 20' AUG. 1 - 1968 12:30 P.M.

Gary E. Penfound REG. SURVEYOR

Marjorie J. Gyuru - Parcel No. 3



02-02-023