


02-02-023-11-040
02-02-0237B
Scan# 45182



EDITH STREET 50'

LEAVITT ROAD 60'

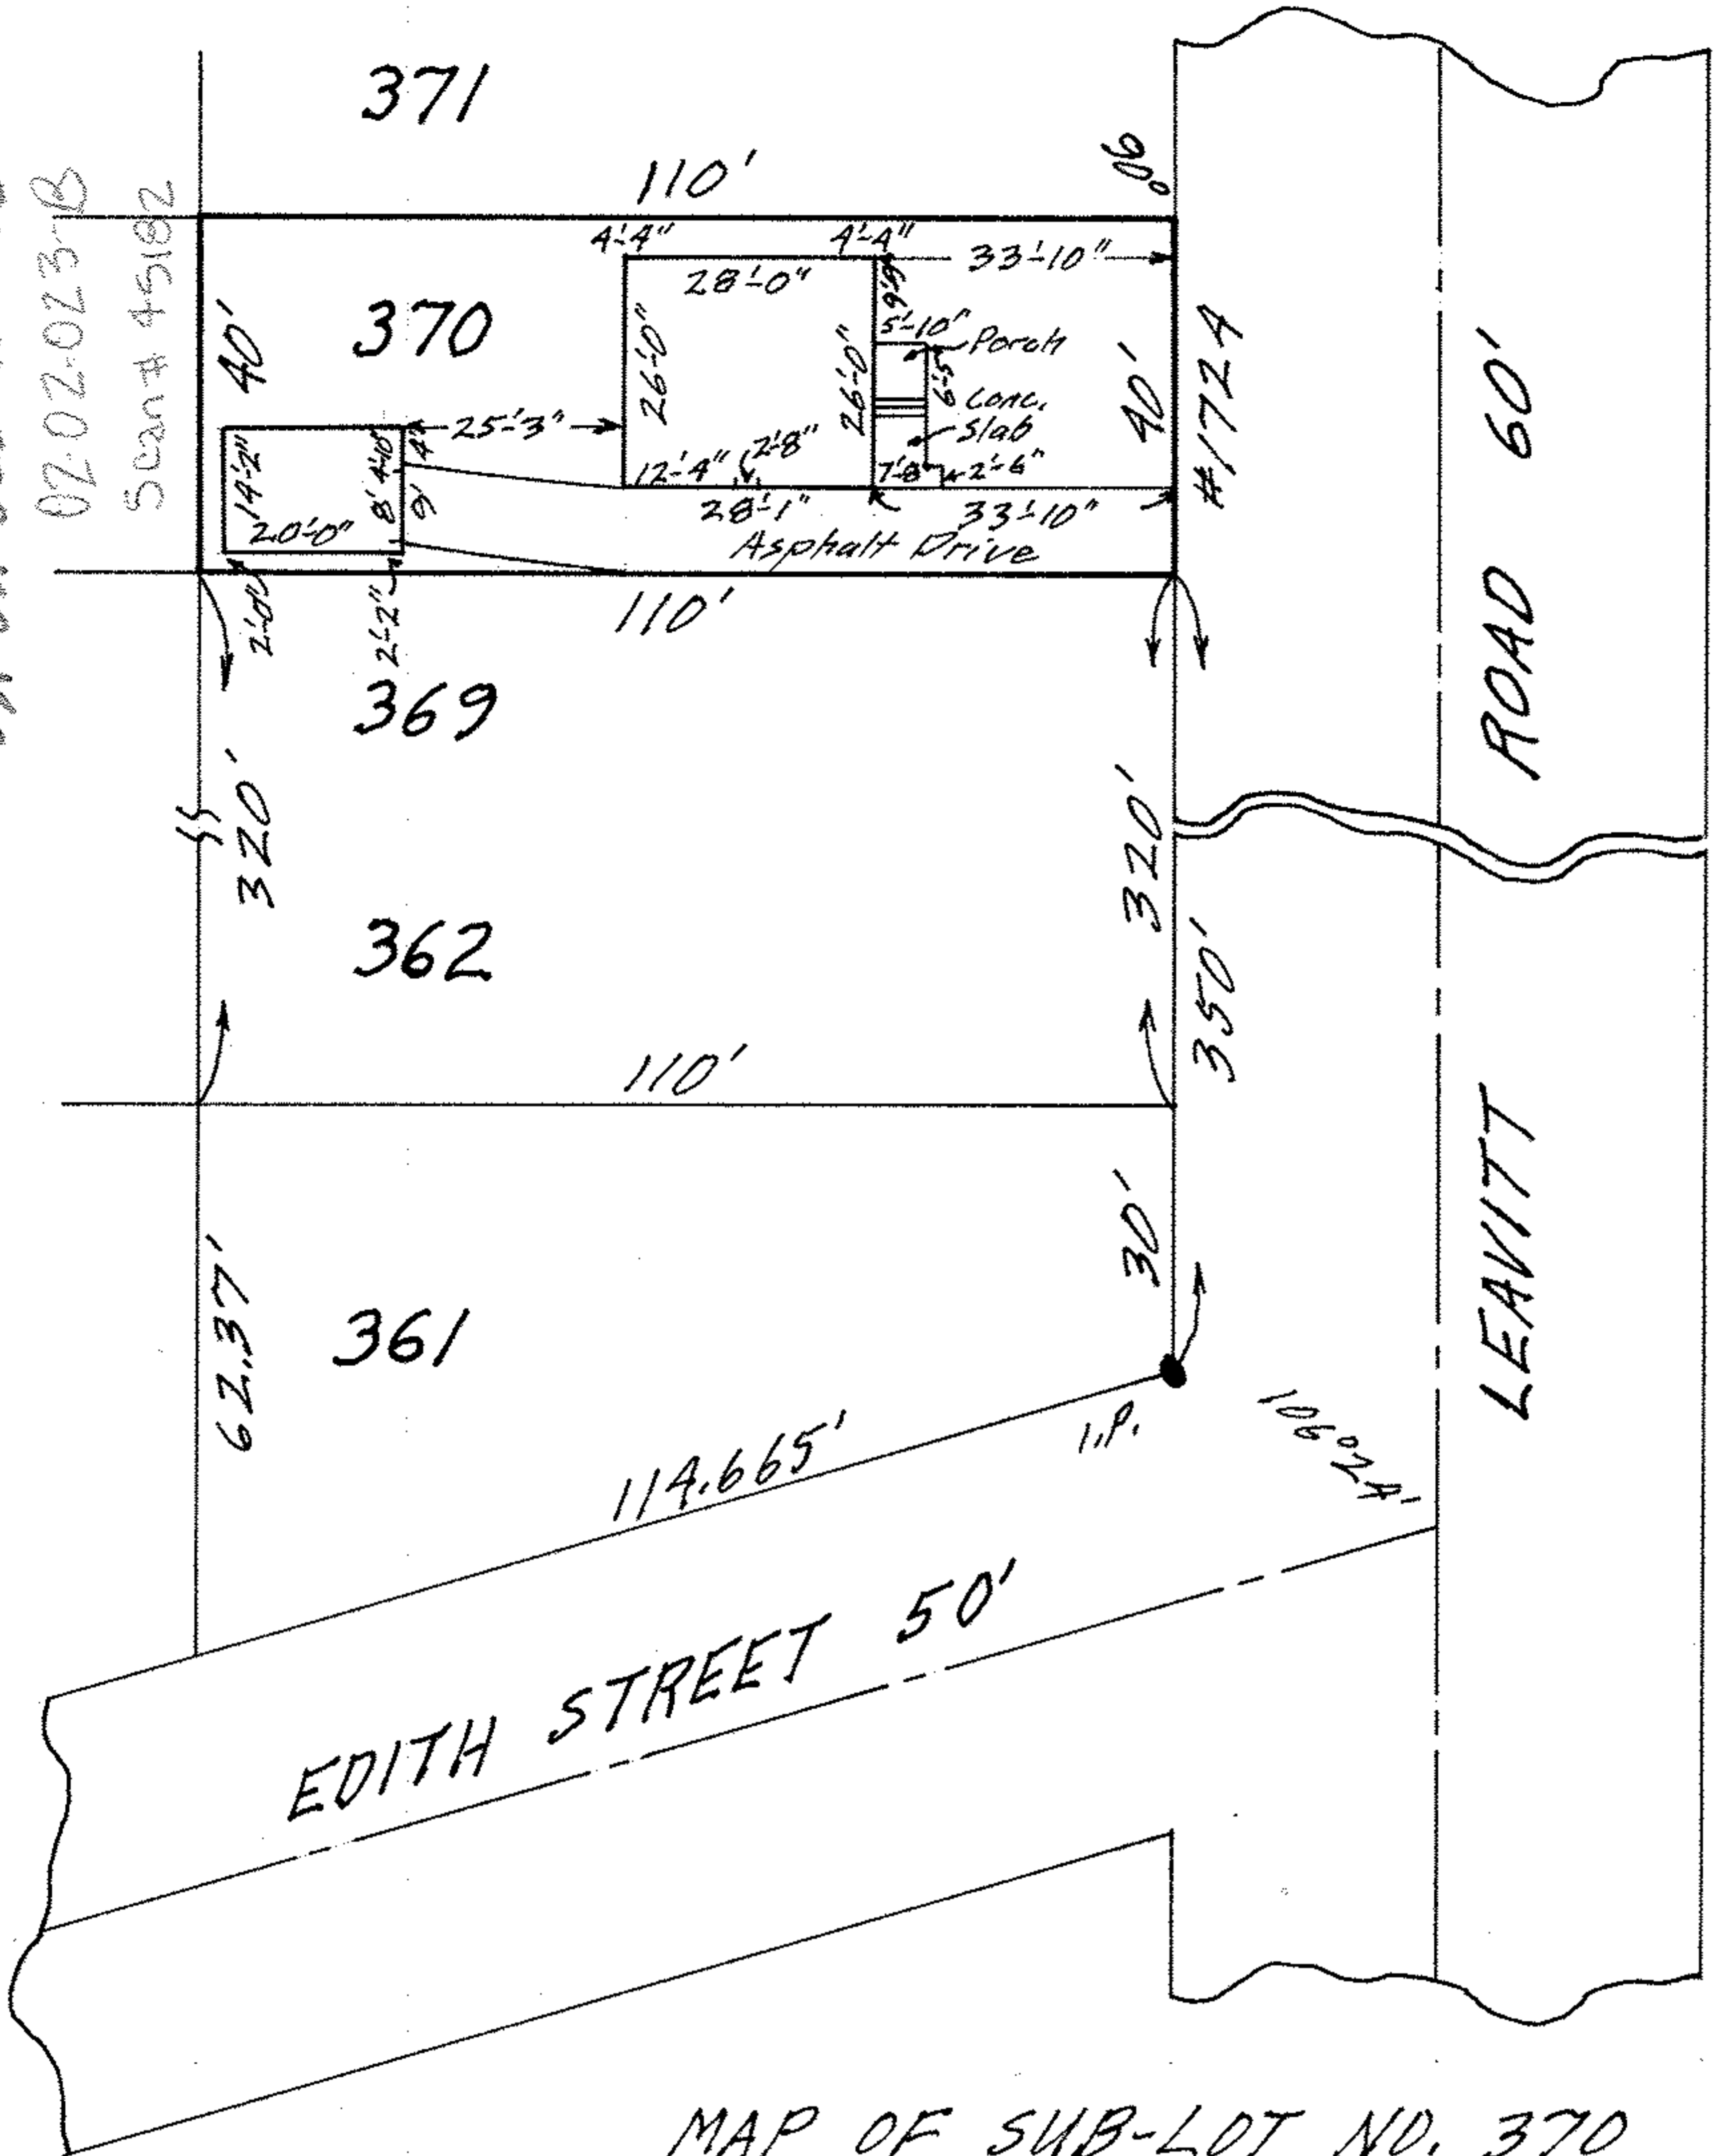

MAP OF SUB-LOT NO. 370
LAKE VIEW ALL'T. VOL. 6 Pgs. 9 & 10
ORIG. LOT 23 - TRACT 2 - BLACK RIVER TWP.
LORAIN CITY - LORAIN COUNTY - OHIO
SCALE: 1" = 30' JAN. 7-1967 3:00 P.M.
Gary E. Penfound REG. SURVEYOR

Edward J. Kamia