


02-02-024-117-040  
02-02-024-B  
SCAN#45186

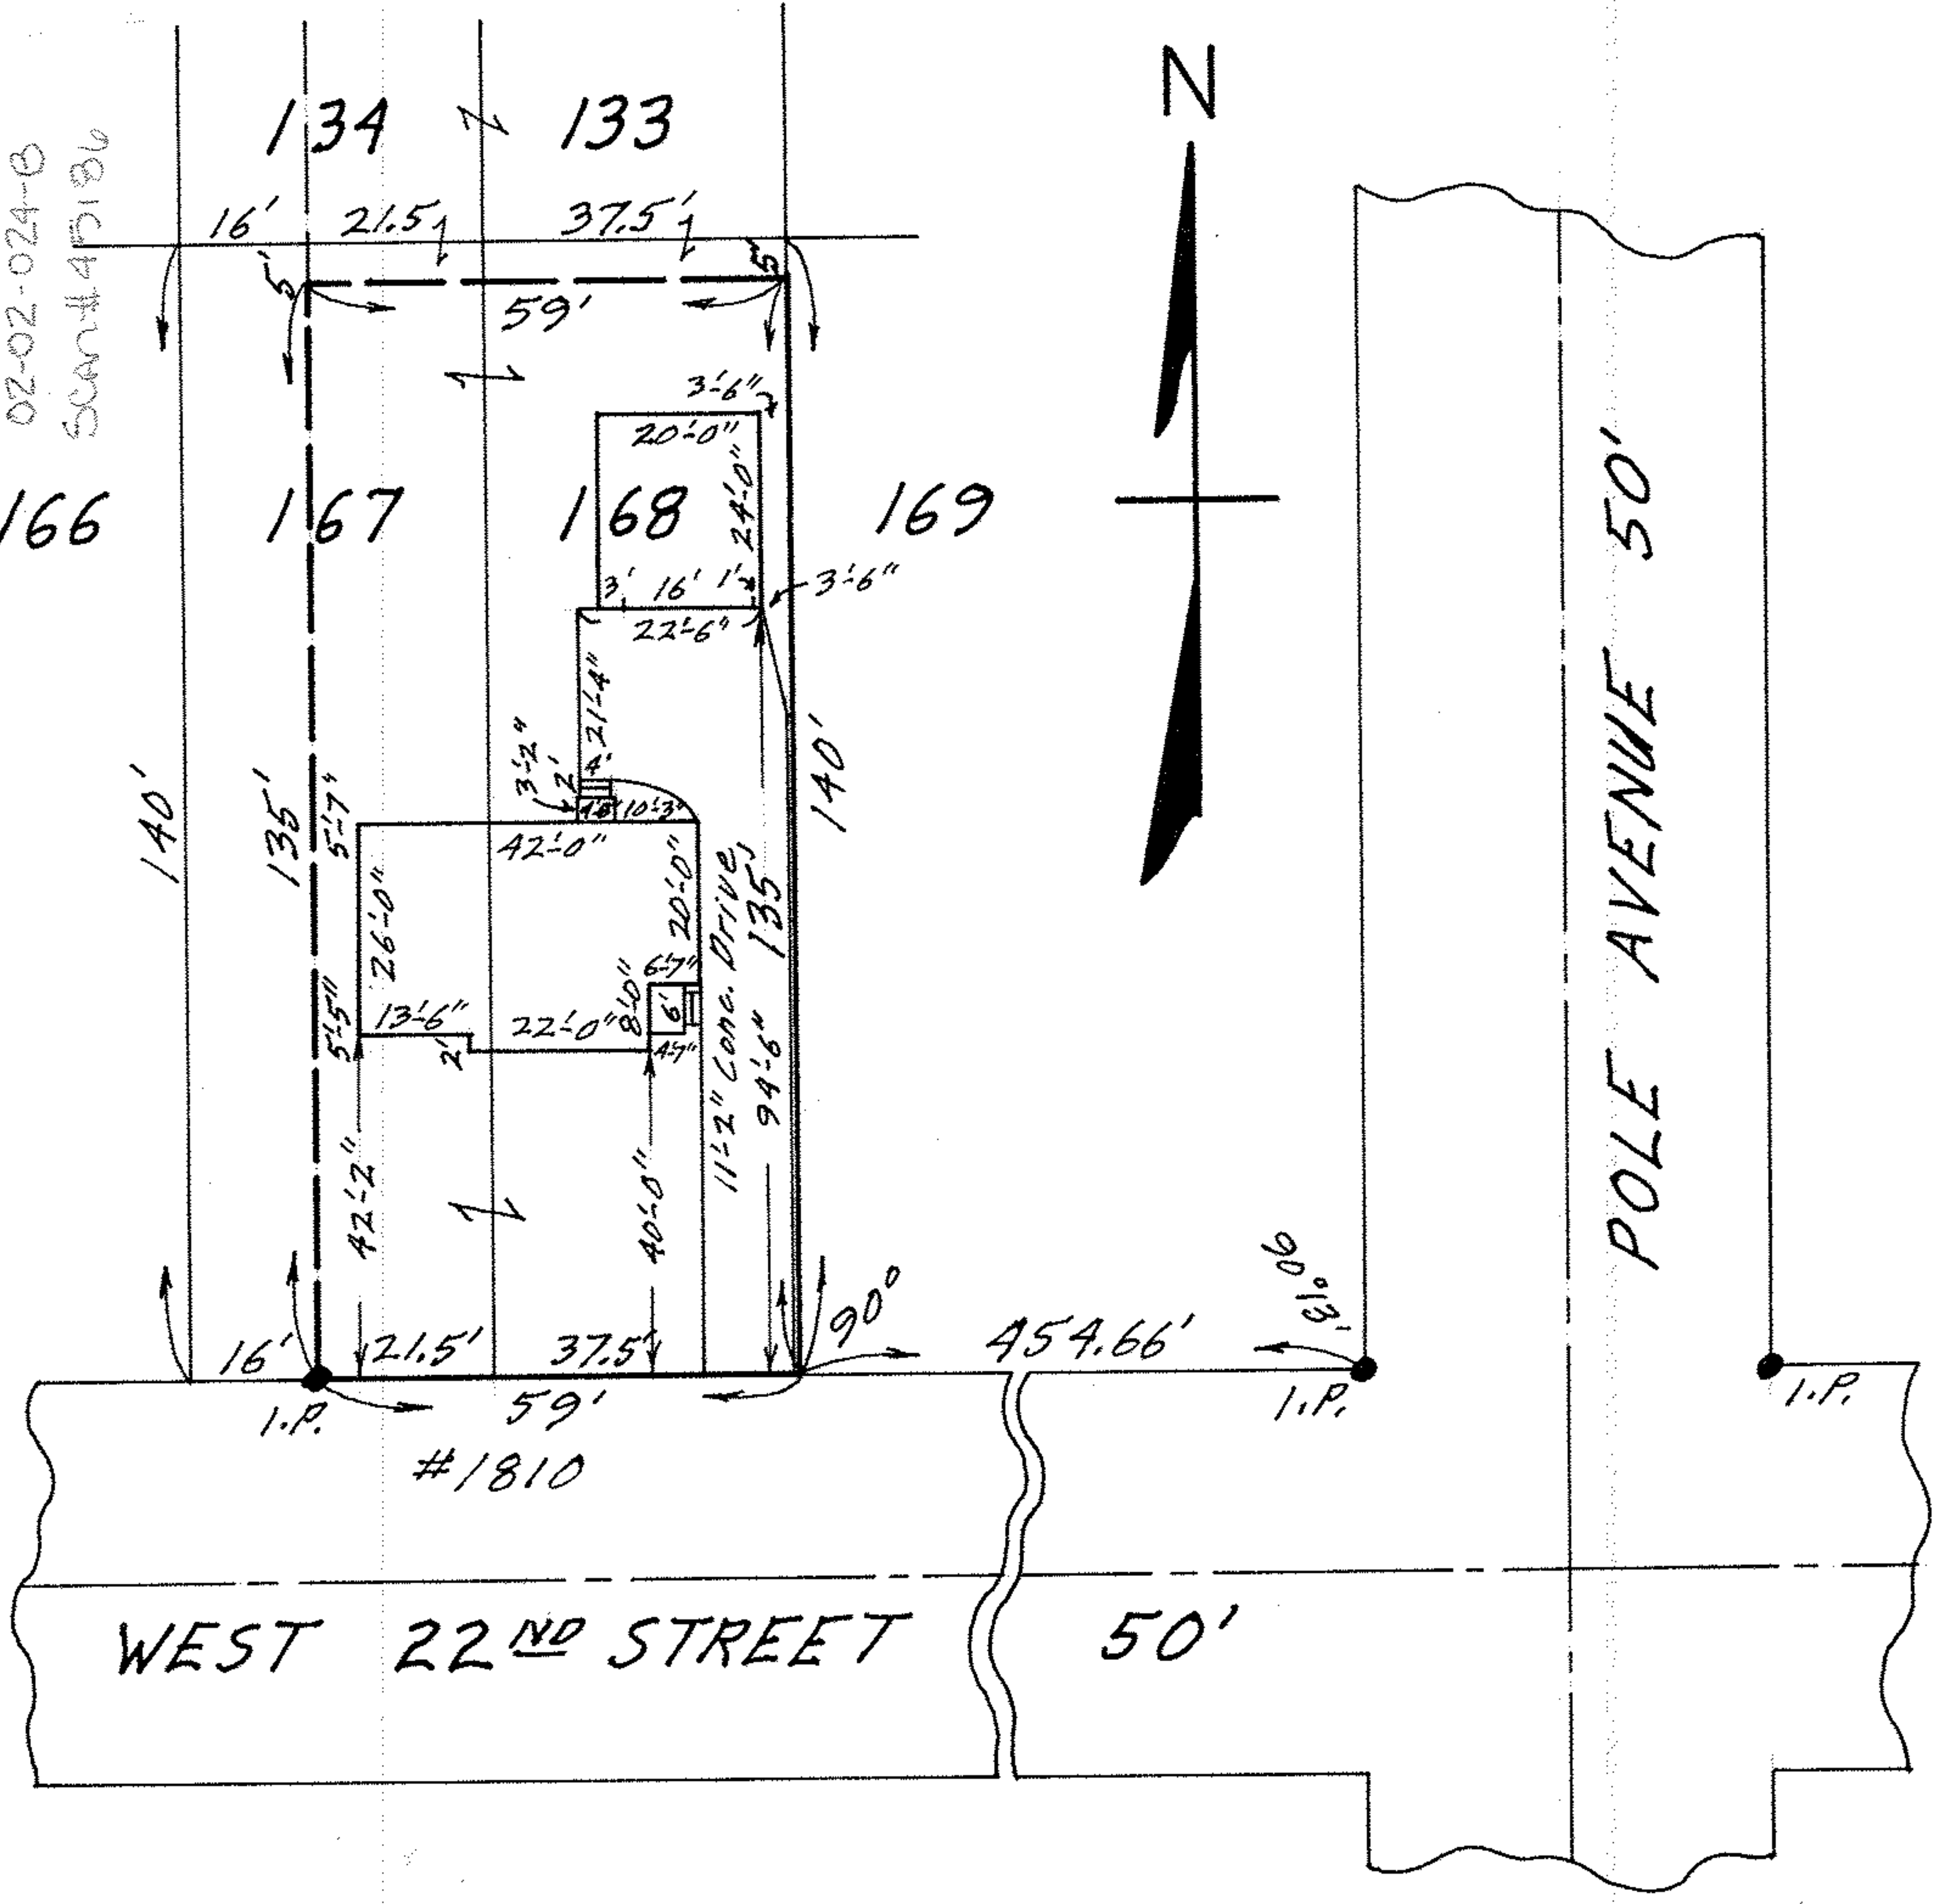

MAP OF PARTS OF SUB-LOTS NOS. 167 & 168  
POLE & REEVES CITY ACRES ADD'N. VOL. 12 Pg. 15  
ORIG. LOT 24 - TRACT 2 - BLACK RIVER TWP.  
LORAIN CITY - LORAIN COUNTY - OHIO  
SCALE: 1" = 30' SEPT. 25-1967 11:30 A.M.  
Gary E. Penfound REG. SURVEYOR  
Donald & Maggie D. Blakely