


02-02-025-109-014
02-02-025-A
SCAN# 45189

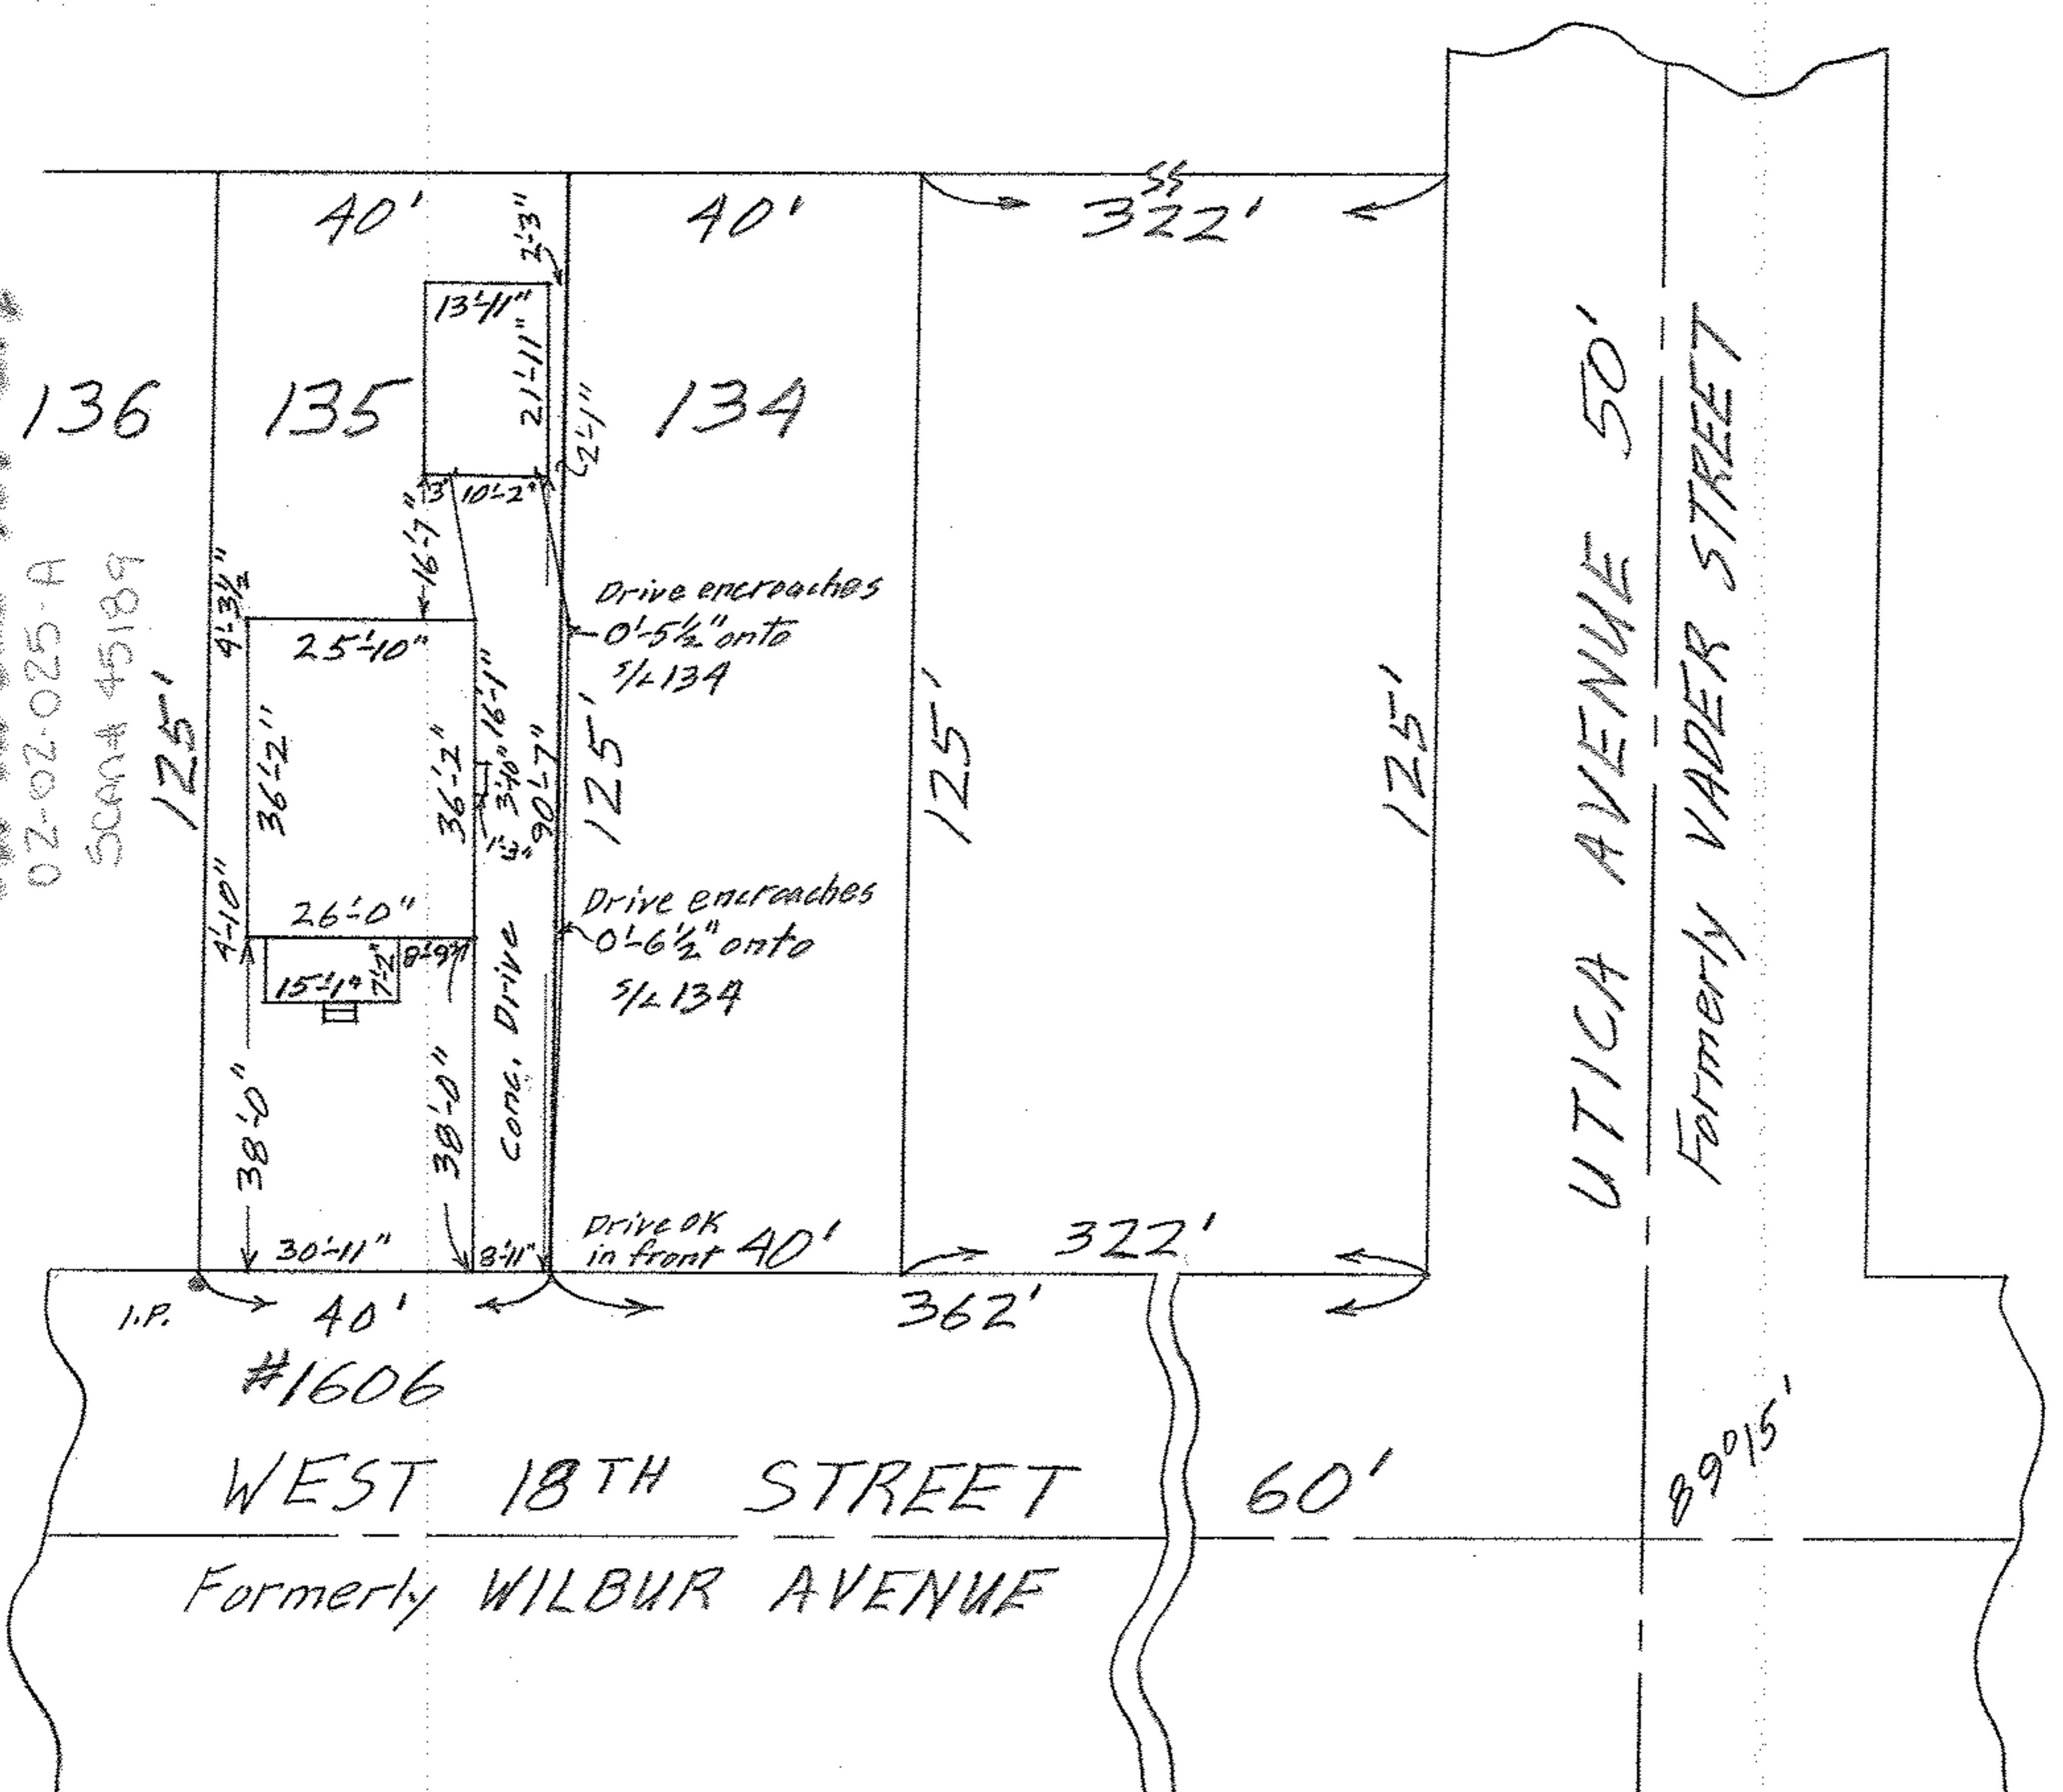

MAP OF SUB-LOT NO. 135

W. S. POLES ADD'N. Vol. 7 Pgs. 39 & 40
ORIG. LOT 25 - TRACT 2 - BLACK RIVER TWP.
LORAIN CITY - LORAIN COUNTY - OHIO
SCALE: 1" = 30' AUGUST 16 - 1964 5:45 P.M.
Gary E. Penfound REG. SURVEYOR

George Spencer, Jr. & Edith F. Spencer