


02-02-025-111-007

02-02-025-6
Scan # 45190

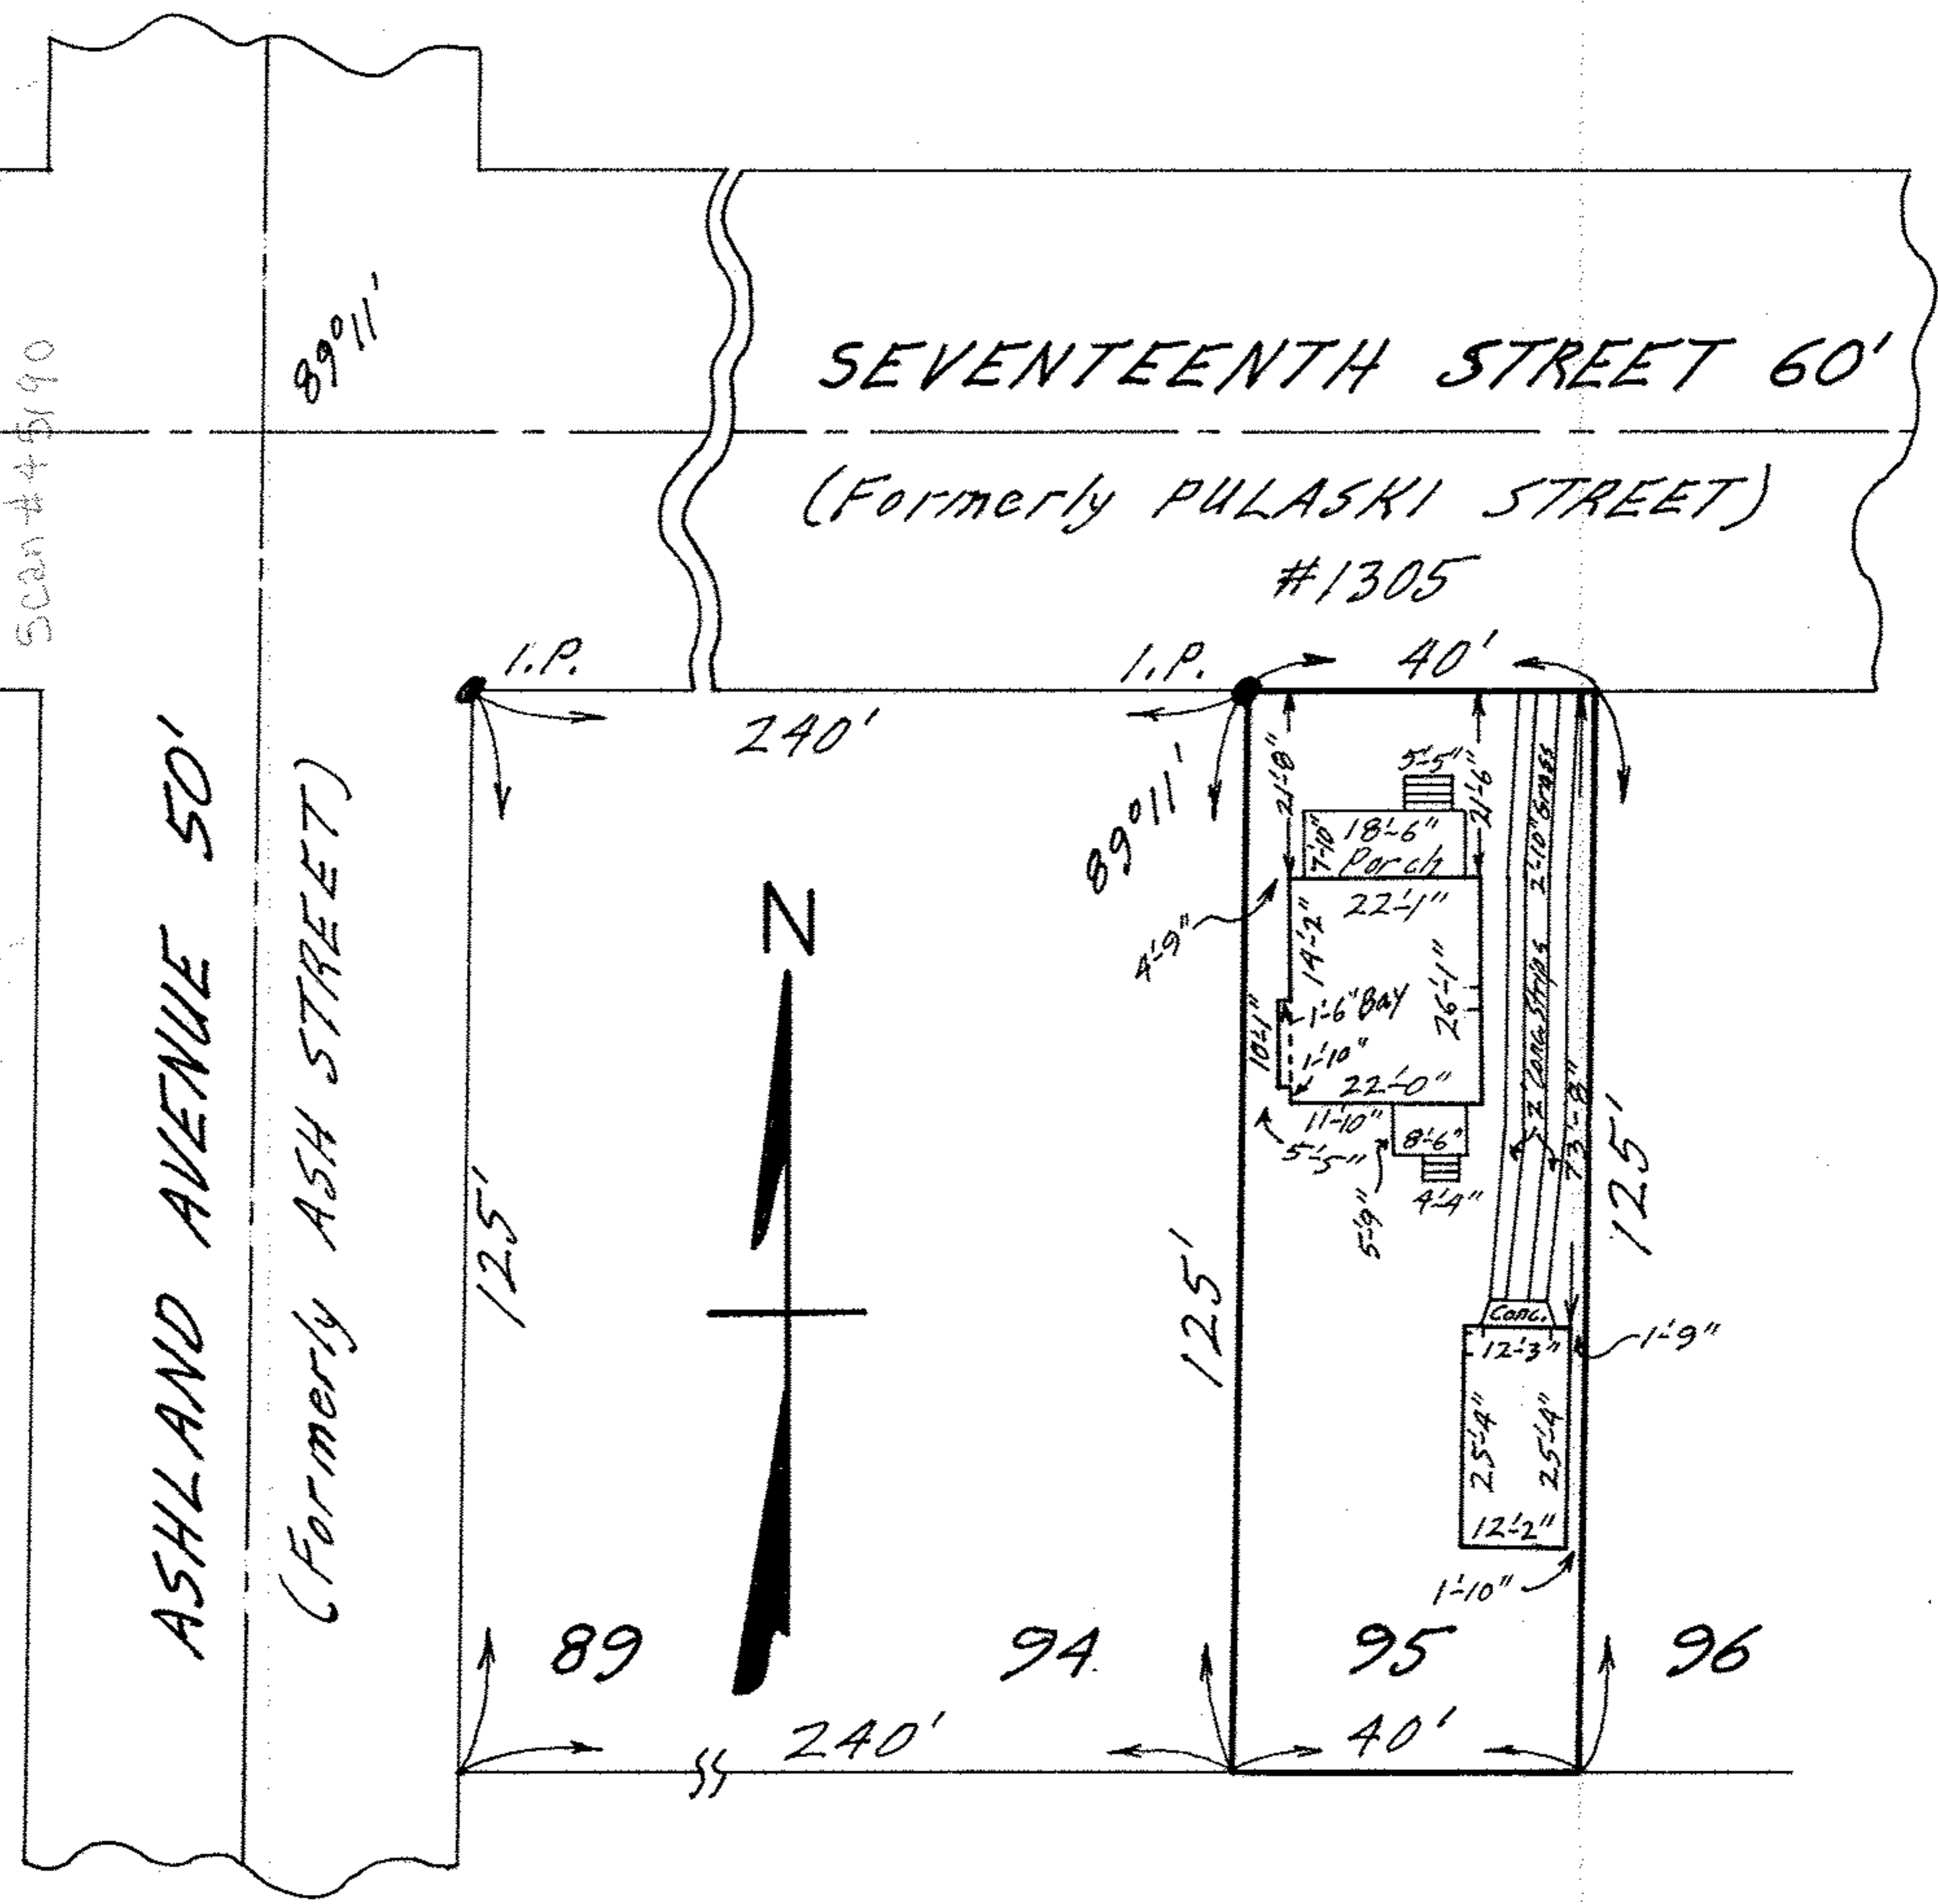

MAP OF SUB-LOT NO. 95

W.S. POLE'S ADD'N. VOL. 7 Pgs. 39 & 40

ORIG. LOT 25 - TRACT 2 - BLACK RIVER TWP.
LORAIN CITY - LORAIN COUNTY - OHIO
SCALE: 1" = 30' MAY 9 - 1970 4:45 P.M.

NOTE: There are no encroachments on this property.
Gary E. Penfound REG. SURVEYOR NO. 4457

CITY TITLE Co. Order No. E-1110-11
Agnes J. Schrankel to Melvin & Alice K. Flanders