


02-02-025-117-0210
 0202025-10
 SAN# 45193

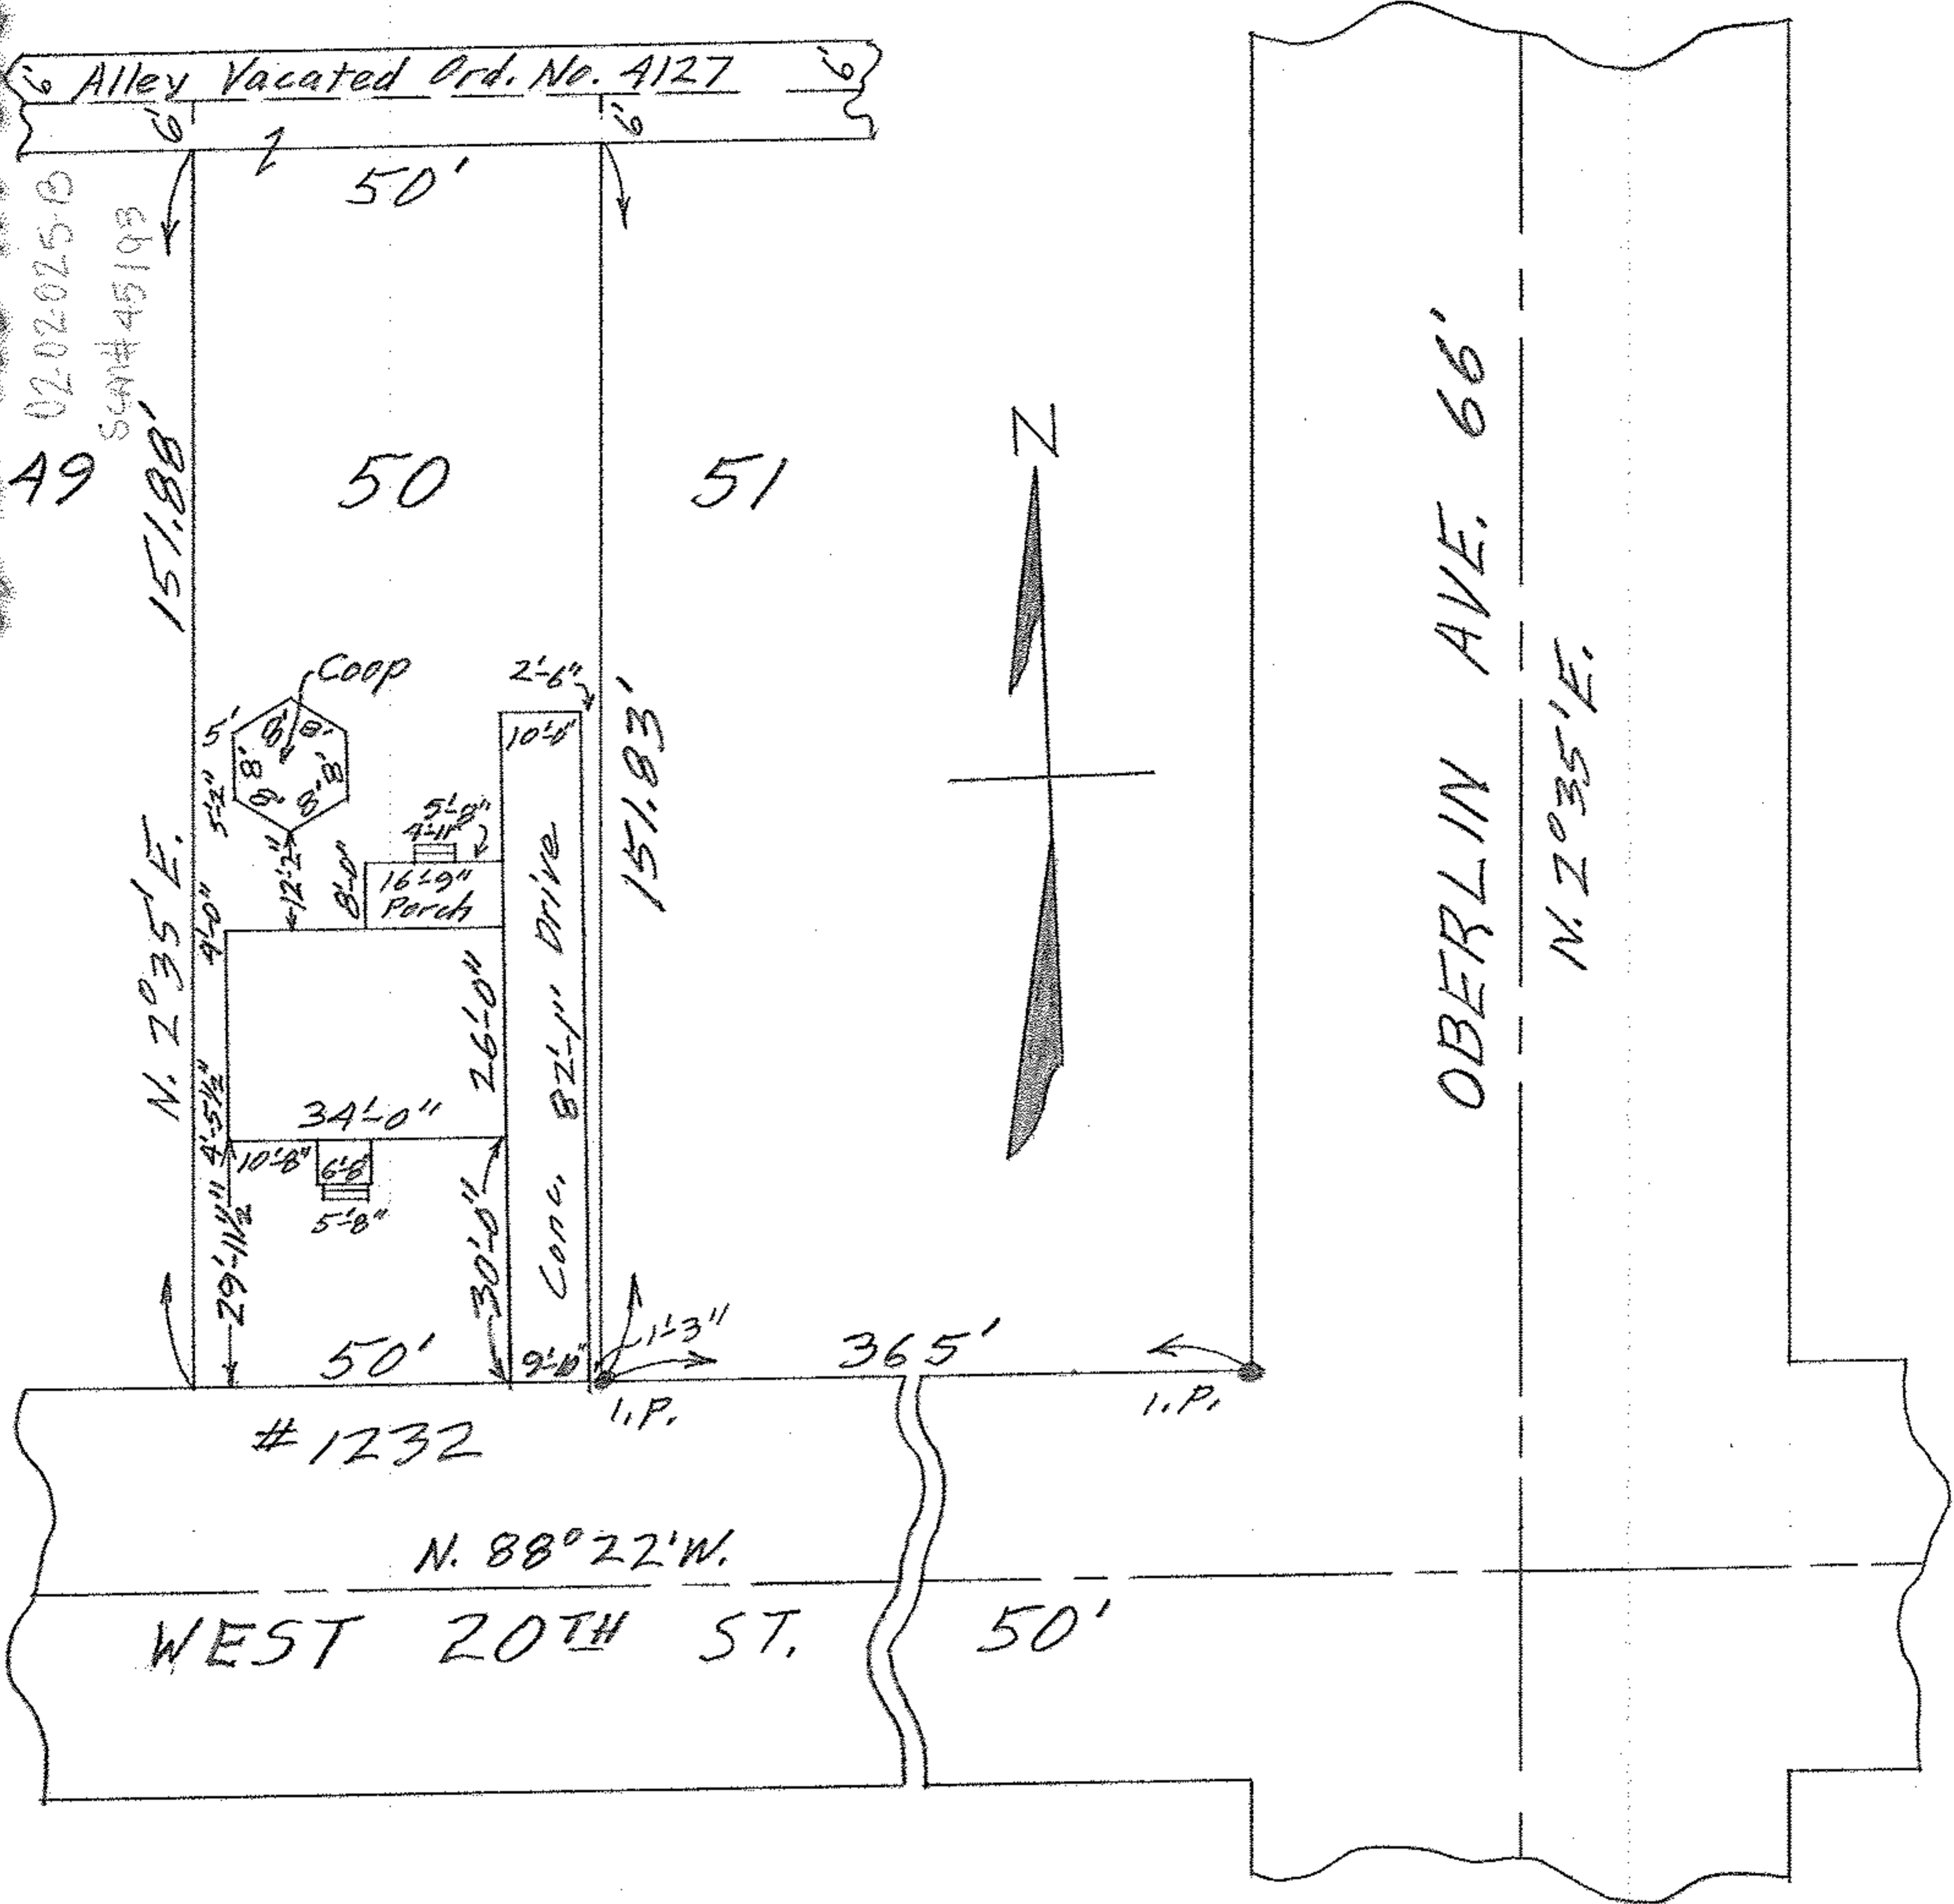

MAP OF SUB-LOT NO. 50
 OAKLAND ADD'N. Vol. 4 Pg. 17 PLATS
 ORIG. LOT 25 - TRACT 2 - BLACK RIVER TWP.
 LORAIN CITY - LORAIN COUNTY - OHIO
 SCALE: 1" = 30' MAY 25 - 1964 8:15 P.M.
 Gary E. Penfound REG. SURVEYOR
 Frank Massey, Jr. & Yvonne Massey

WW

02-02-025