



02-02-026-10a-001  
 02-02-026-A  
 SCW# 45190

BROWNELL AVENUE 50'

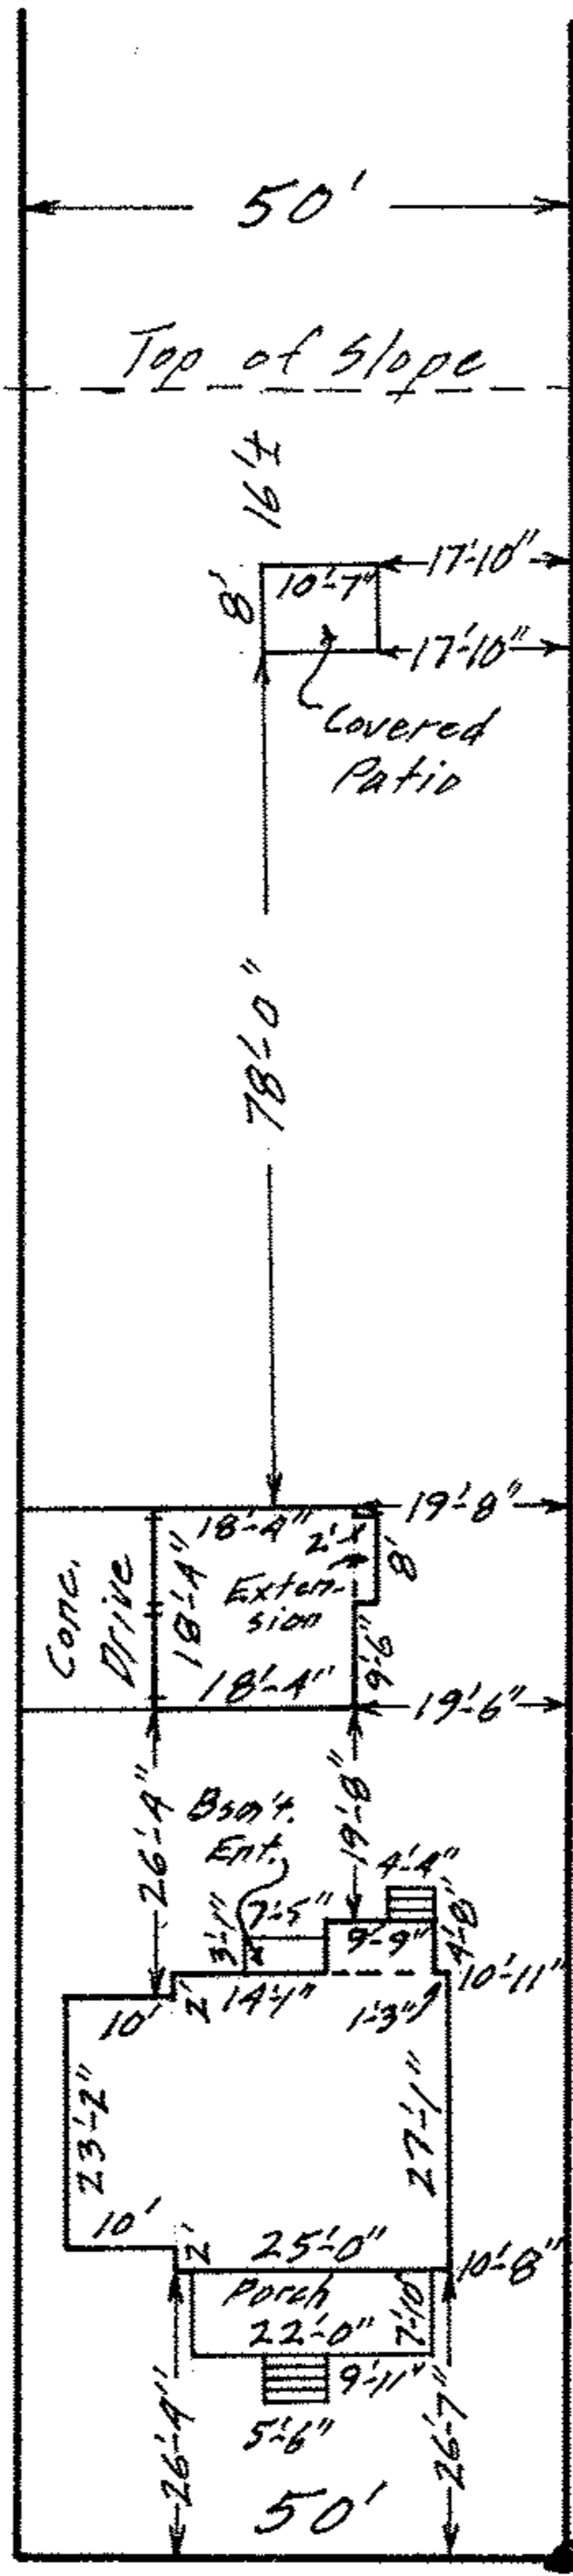

MAP OF PART OF ORIG. LOT 26-  
 TRACT NO. 2 - BLACK RIVER TWP  
 LORAIN CITY  
 LORAIN COUNTY OHIO  
 SCALE: 1"=30' JUNE 30-1966 4:00 P.M.  
 Gary E. Penfound REG. SURVEYOR

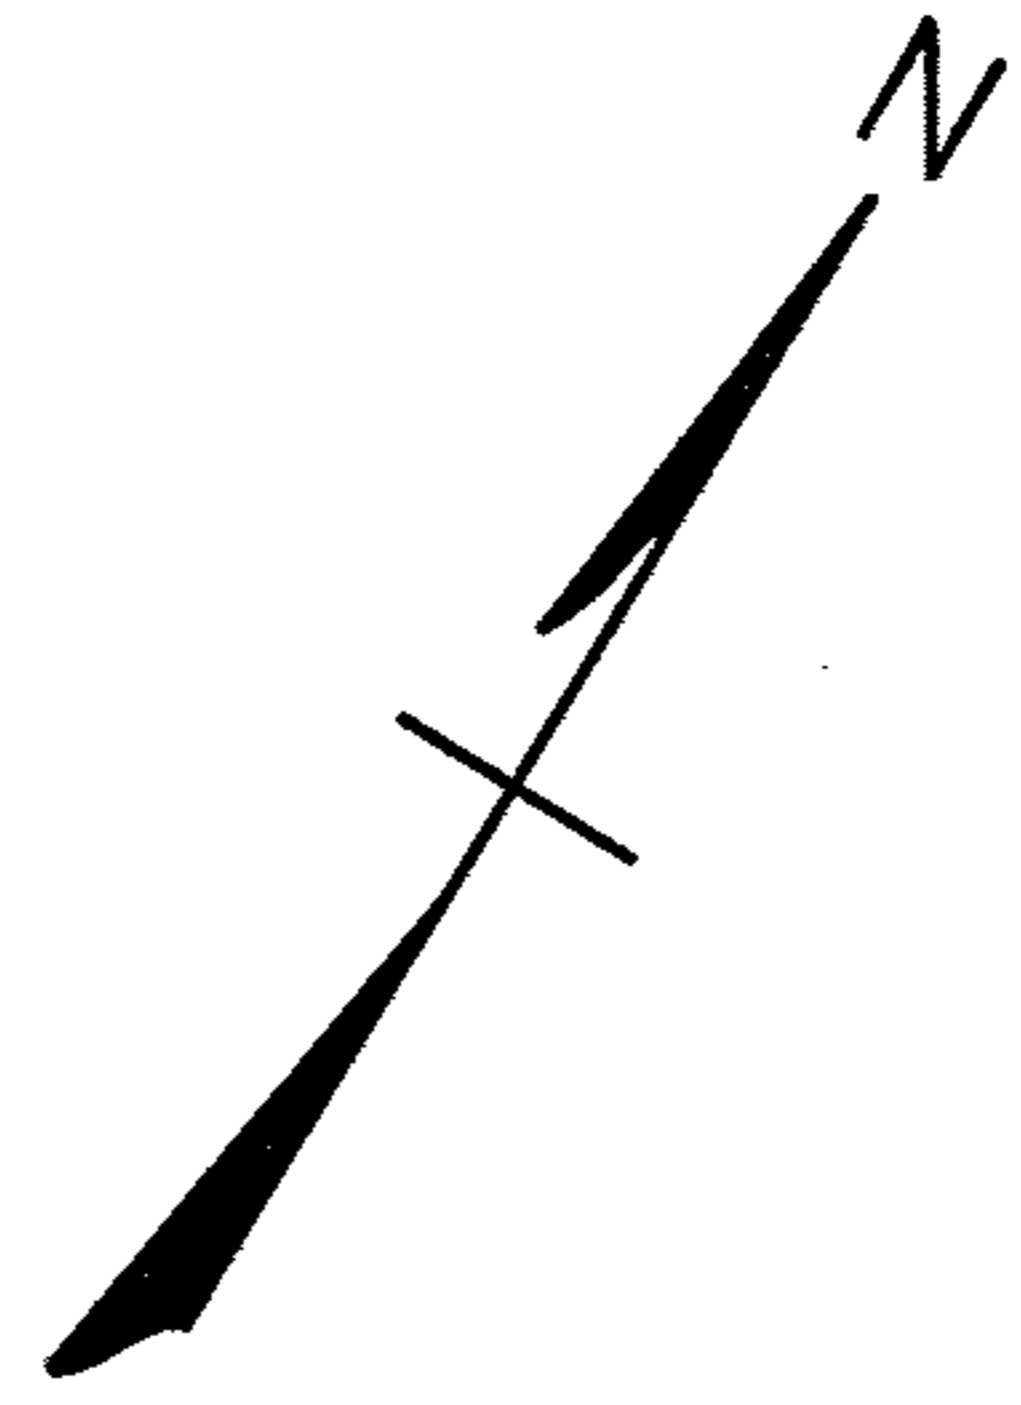

130.50 Rec. & Meas. I.P.

SECOND STREET 50'

#1238

Naomi N. Long

PC

02-02-026