


02-02-026-109-009  
02-02-026-10  
SC# 45199

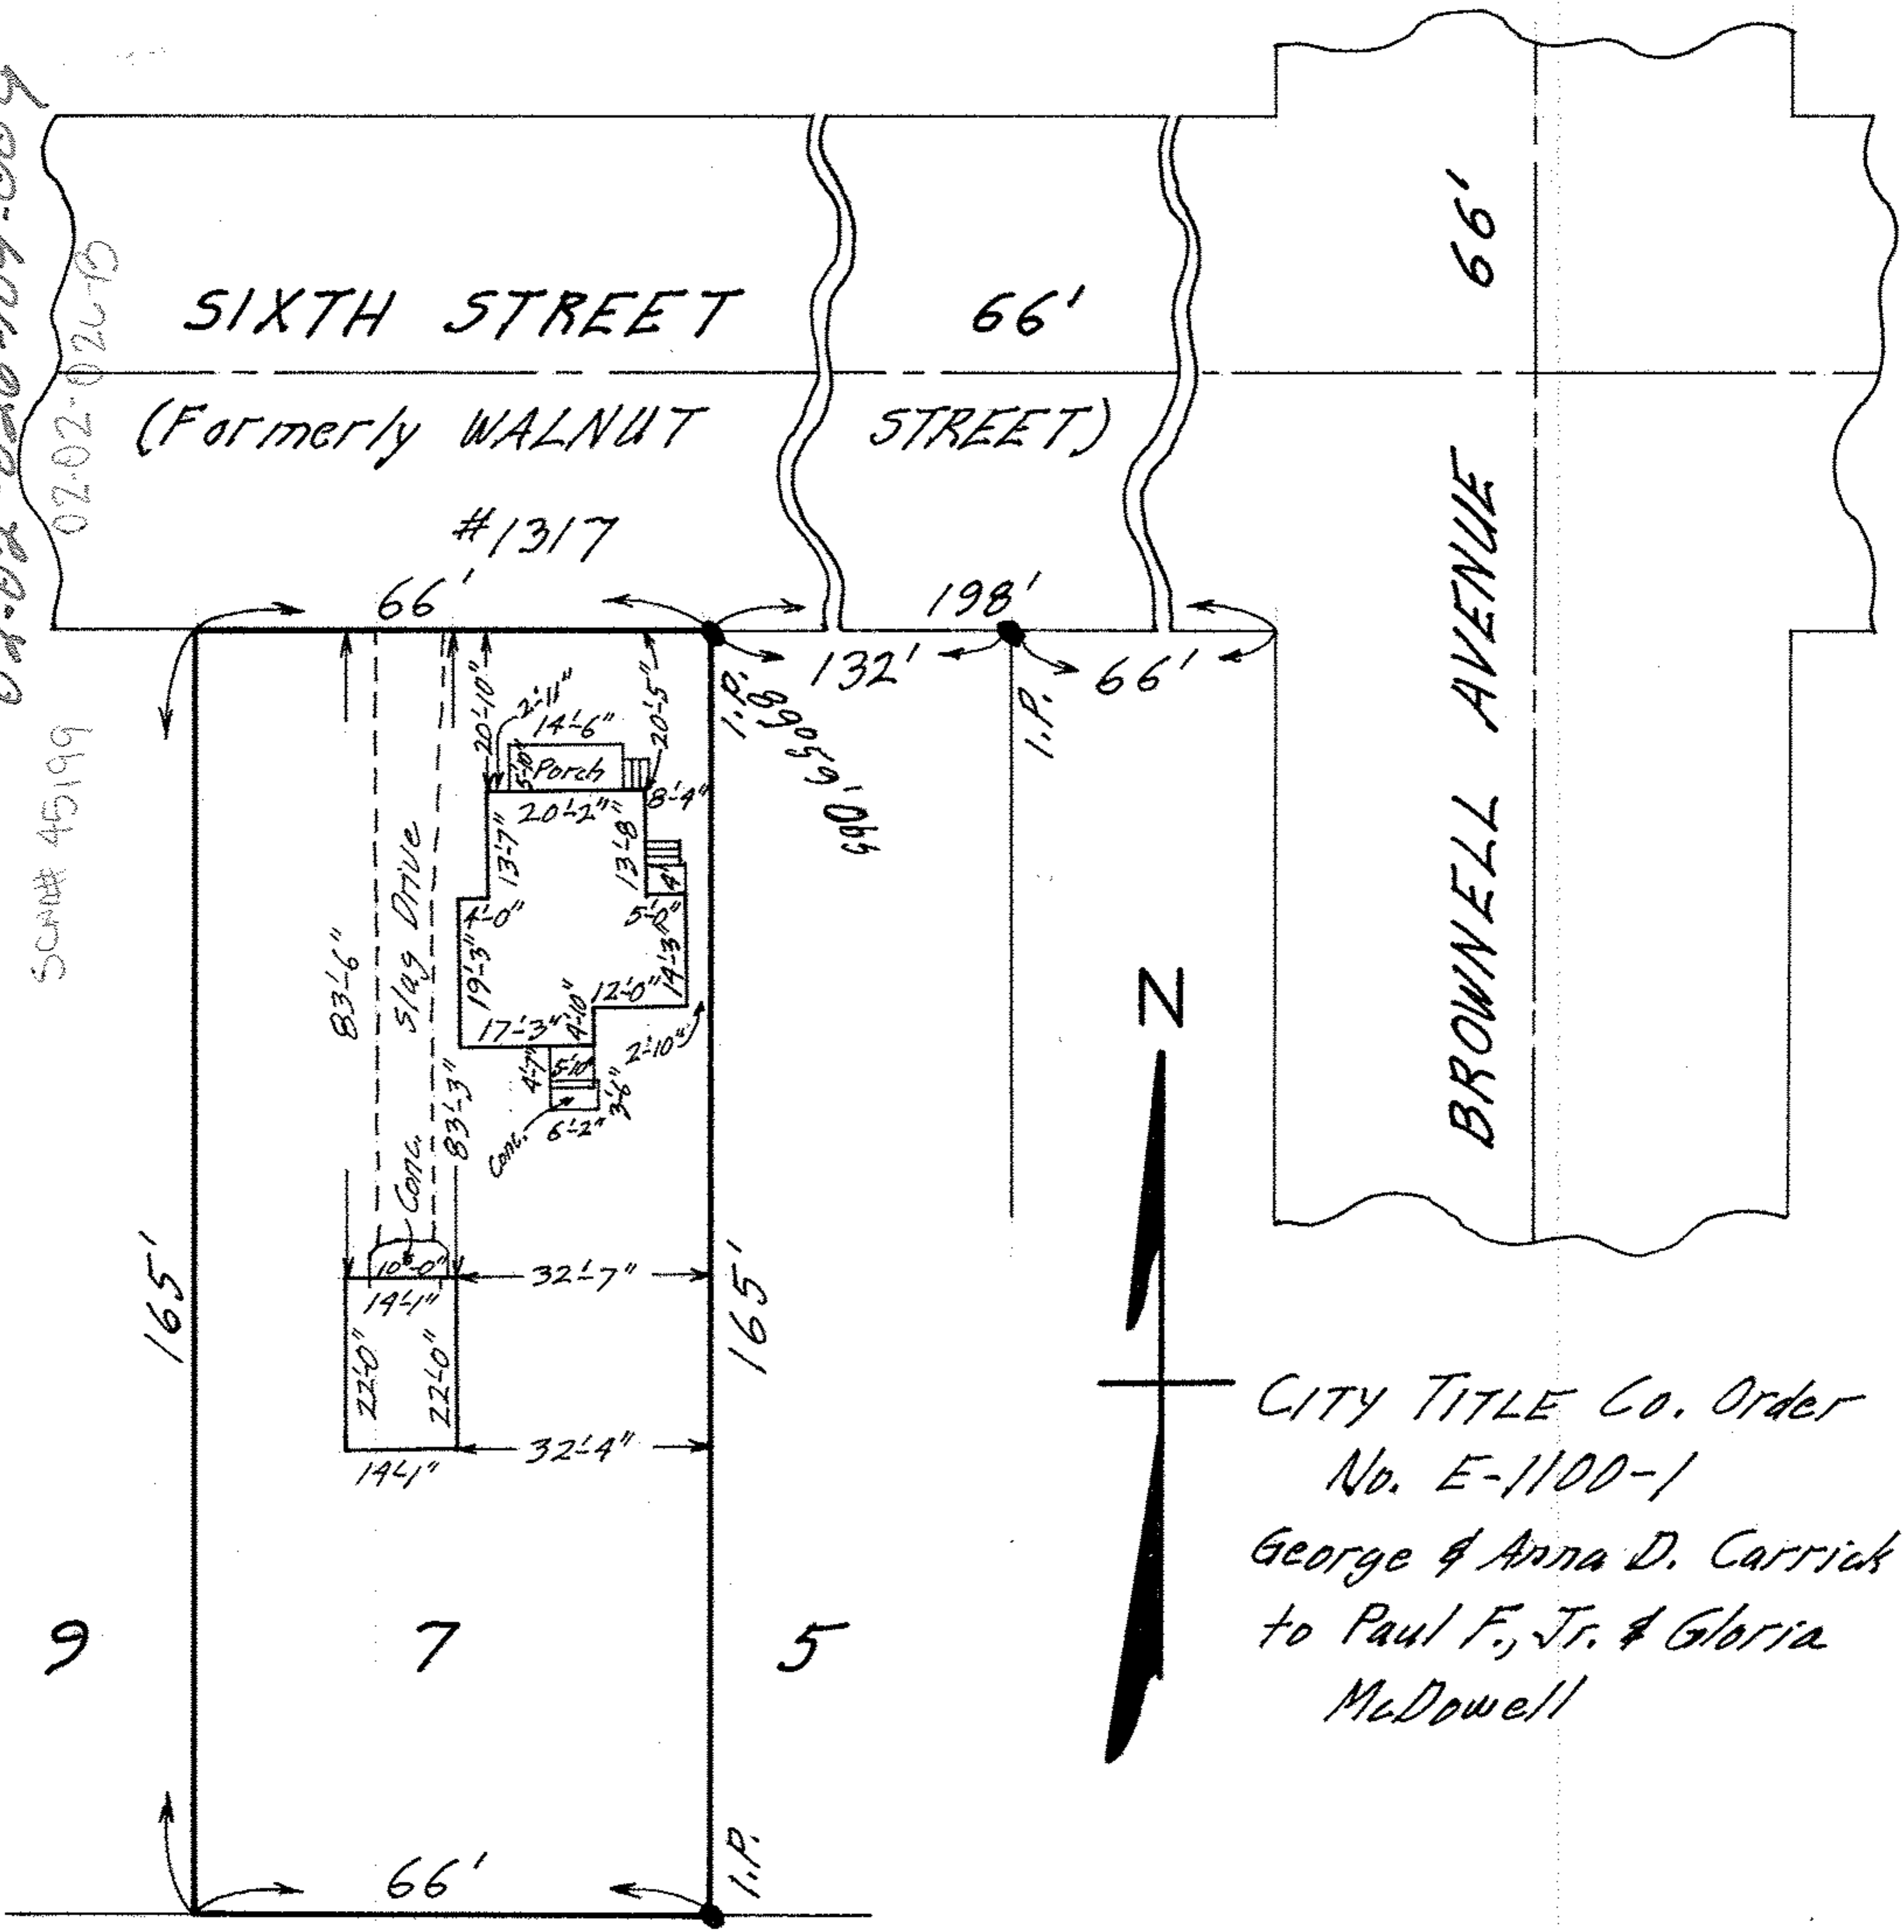

CITY TITLE Co. Order  
 No. E-1100-1  
 George & Anna D. Carrick  
 to Paul F., Jr. & Gloria  
 McDowell

MAP OF SUB-LOT NO. 7 OF BLOCK NO. 7  
 BROWNELL'S FIRST ADD'N. Vol. 2 Pg. 9  
 ORIG. LOT 26 - TRACT 2 - BLACK RIVER TWP.  
 LORAIN CITY - LORAIN COUNTY - OHIO  
 SCALE: 1" = 30' APRIL 28 - 1970 6:00 P.M.  
 NOTE: There are no encroachments on this property.  
 Gary E. Penfound REG. SURVEYOR NO. 4457

02-02-026