


02-02-027-119-004
 02-02-027 SC#45214
 PARKVIEW AVENUE 66'

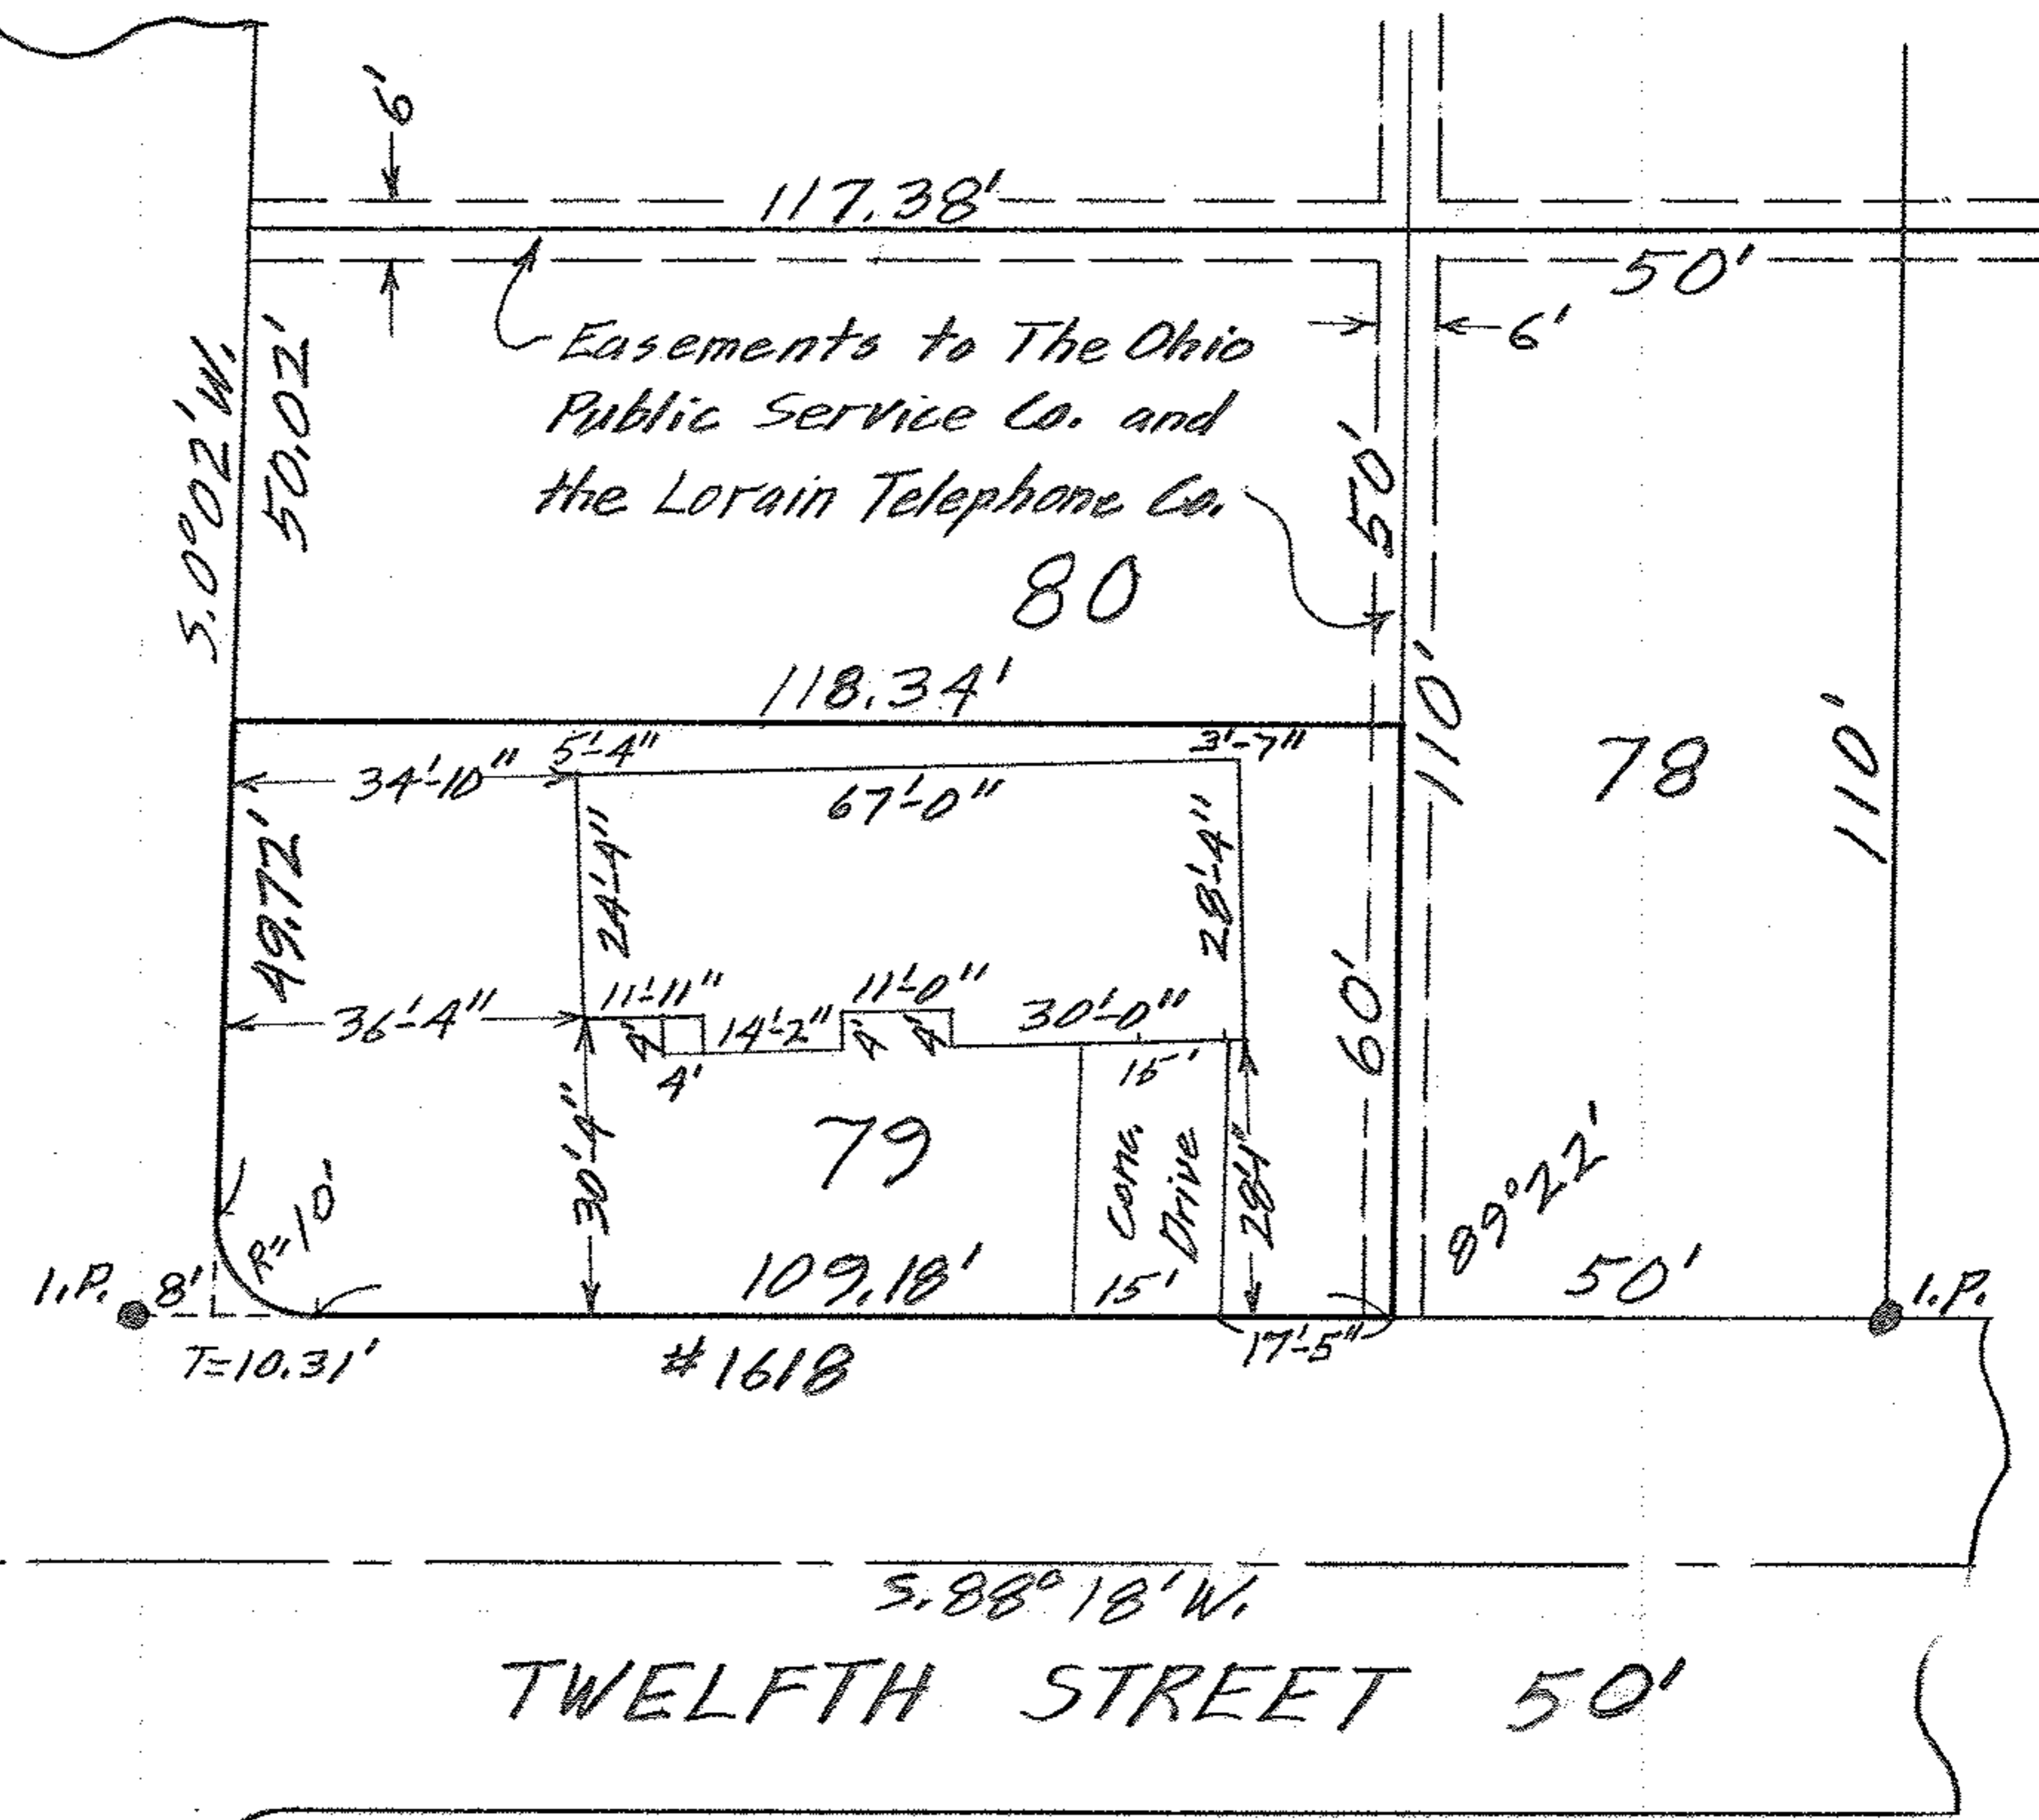

MAP OF SUB-LOT NO. 79
 LAKE VIEW PARK HOMES ALL'T. VOL 19 P 15
 ORIG. LOT 27 - TRACT 2 - BLACK RIVER TWP.
 LORAIN CITY - LORAIN COUNTY - OHIO
 SCALE: 1" = 30' NOV. 24-1965 11:30 A.M.
 Gary E. Penfound REG. SURVEYOR

Norman J. & Evelyn L. Beller