

02-02-027-119-007


02-02-027

SCAN#45215

MAP OF SUB-LOT NO. 85
LAKE VIEW PARK HOMES ALLT. VOL. 14 PG. 15
ORIG. LOT 27 - TRACT 2 - BLACK RIVER TWP.
LORAIN CITY - LORAIN COUNTY - OHIO
SCALE: 1"=30' OCT. 17-1969 2:00 P.M.
CITY TITLE CO.

NOTE: The only encroachment is that of 2 1/2 inches
of concrete drive from Sub-Lot 86 as shown.

Order No. E-883-A
Anne Laskay to
Louis R. & Sandra A.
Parise

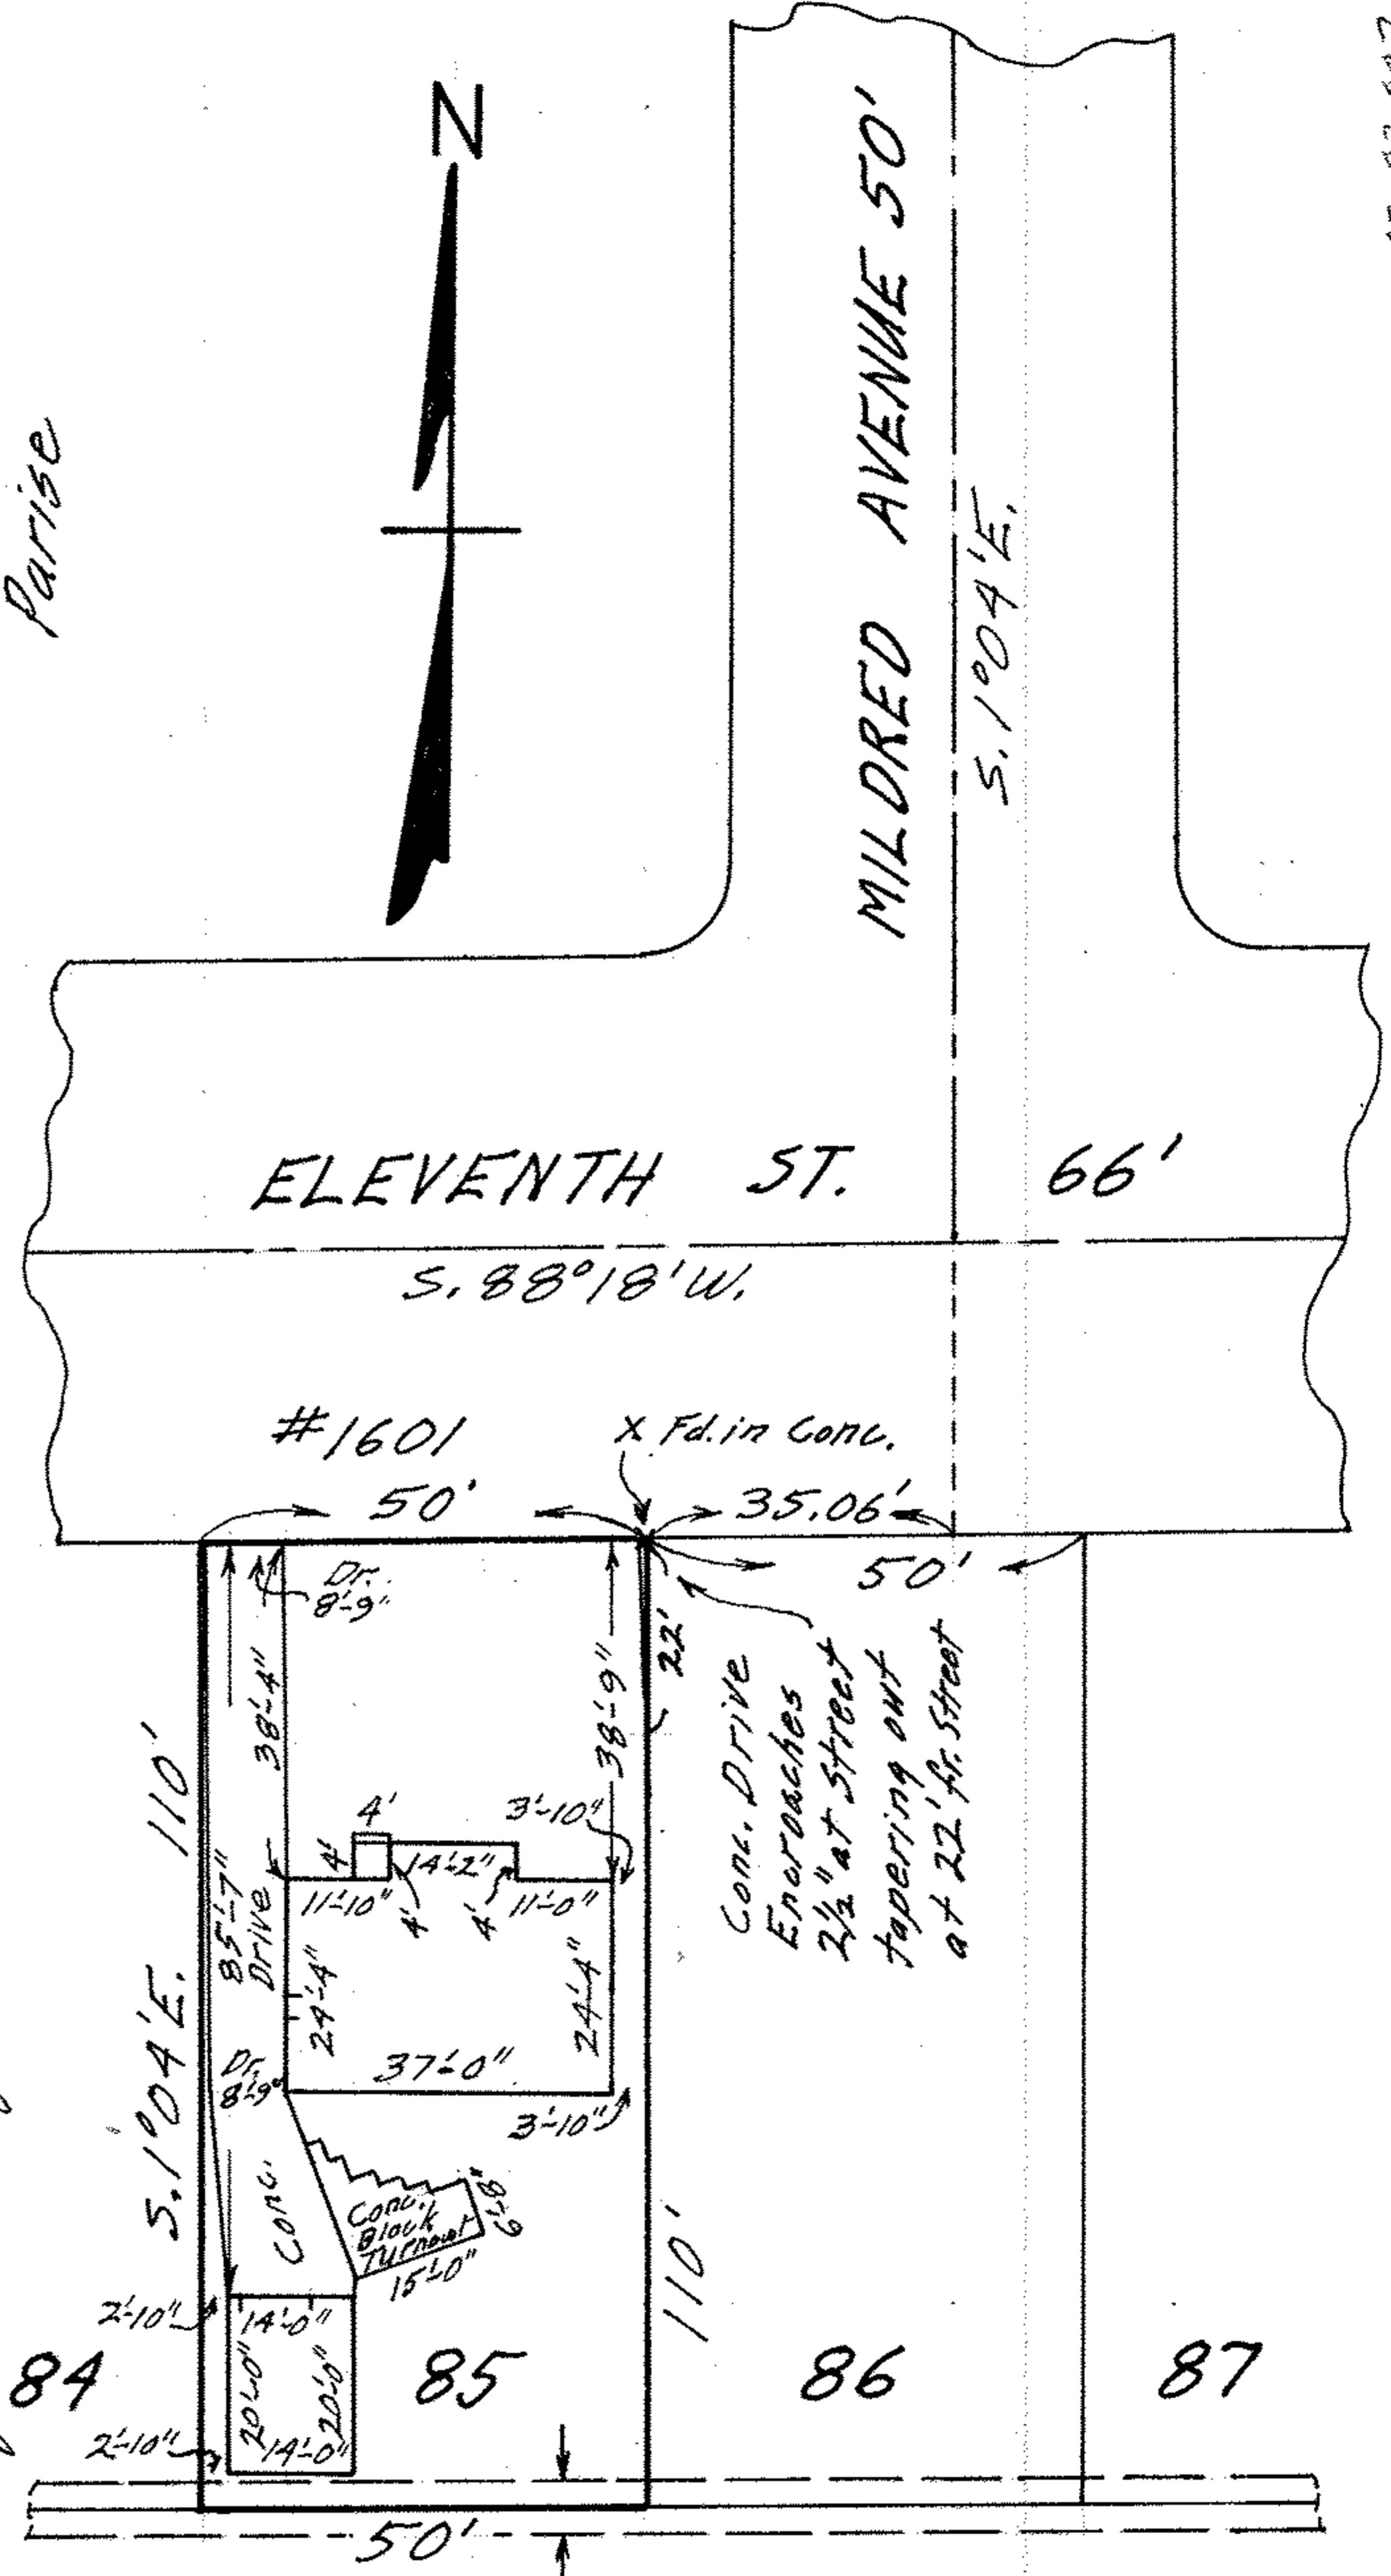

02-02-027