


02-02-029-101-026
 02-02-029
 Scan # 45219

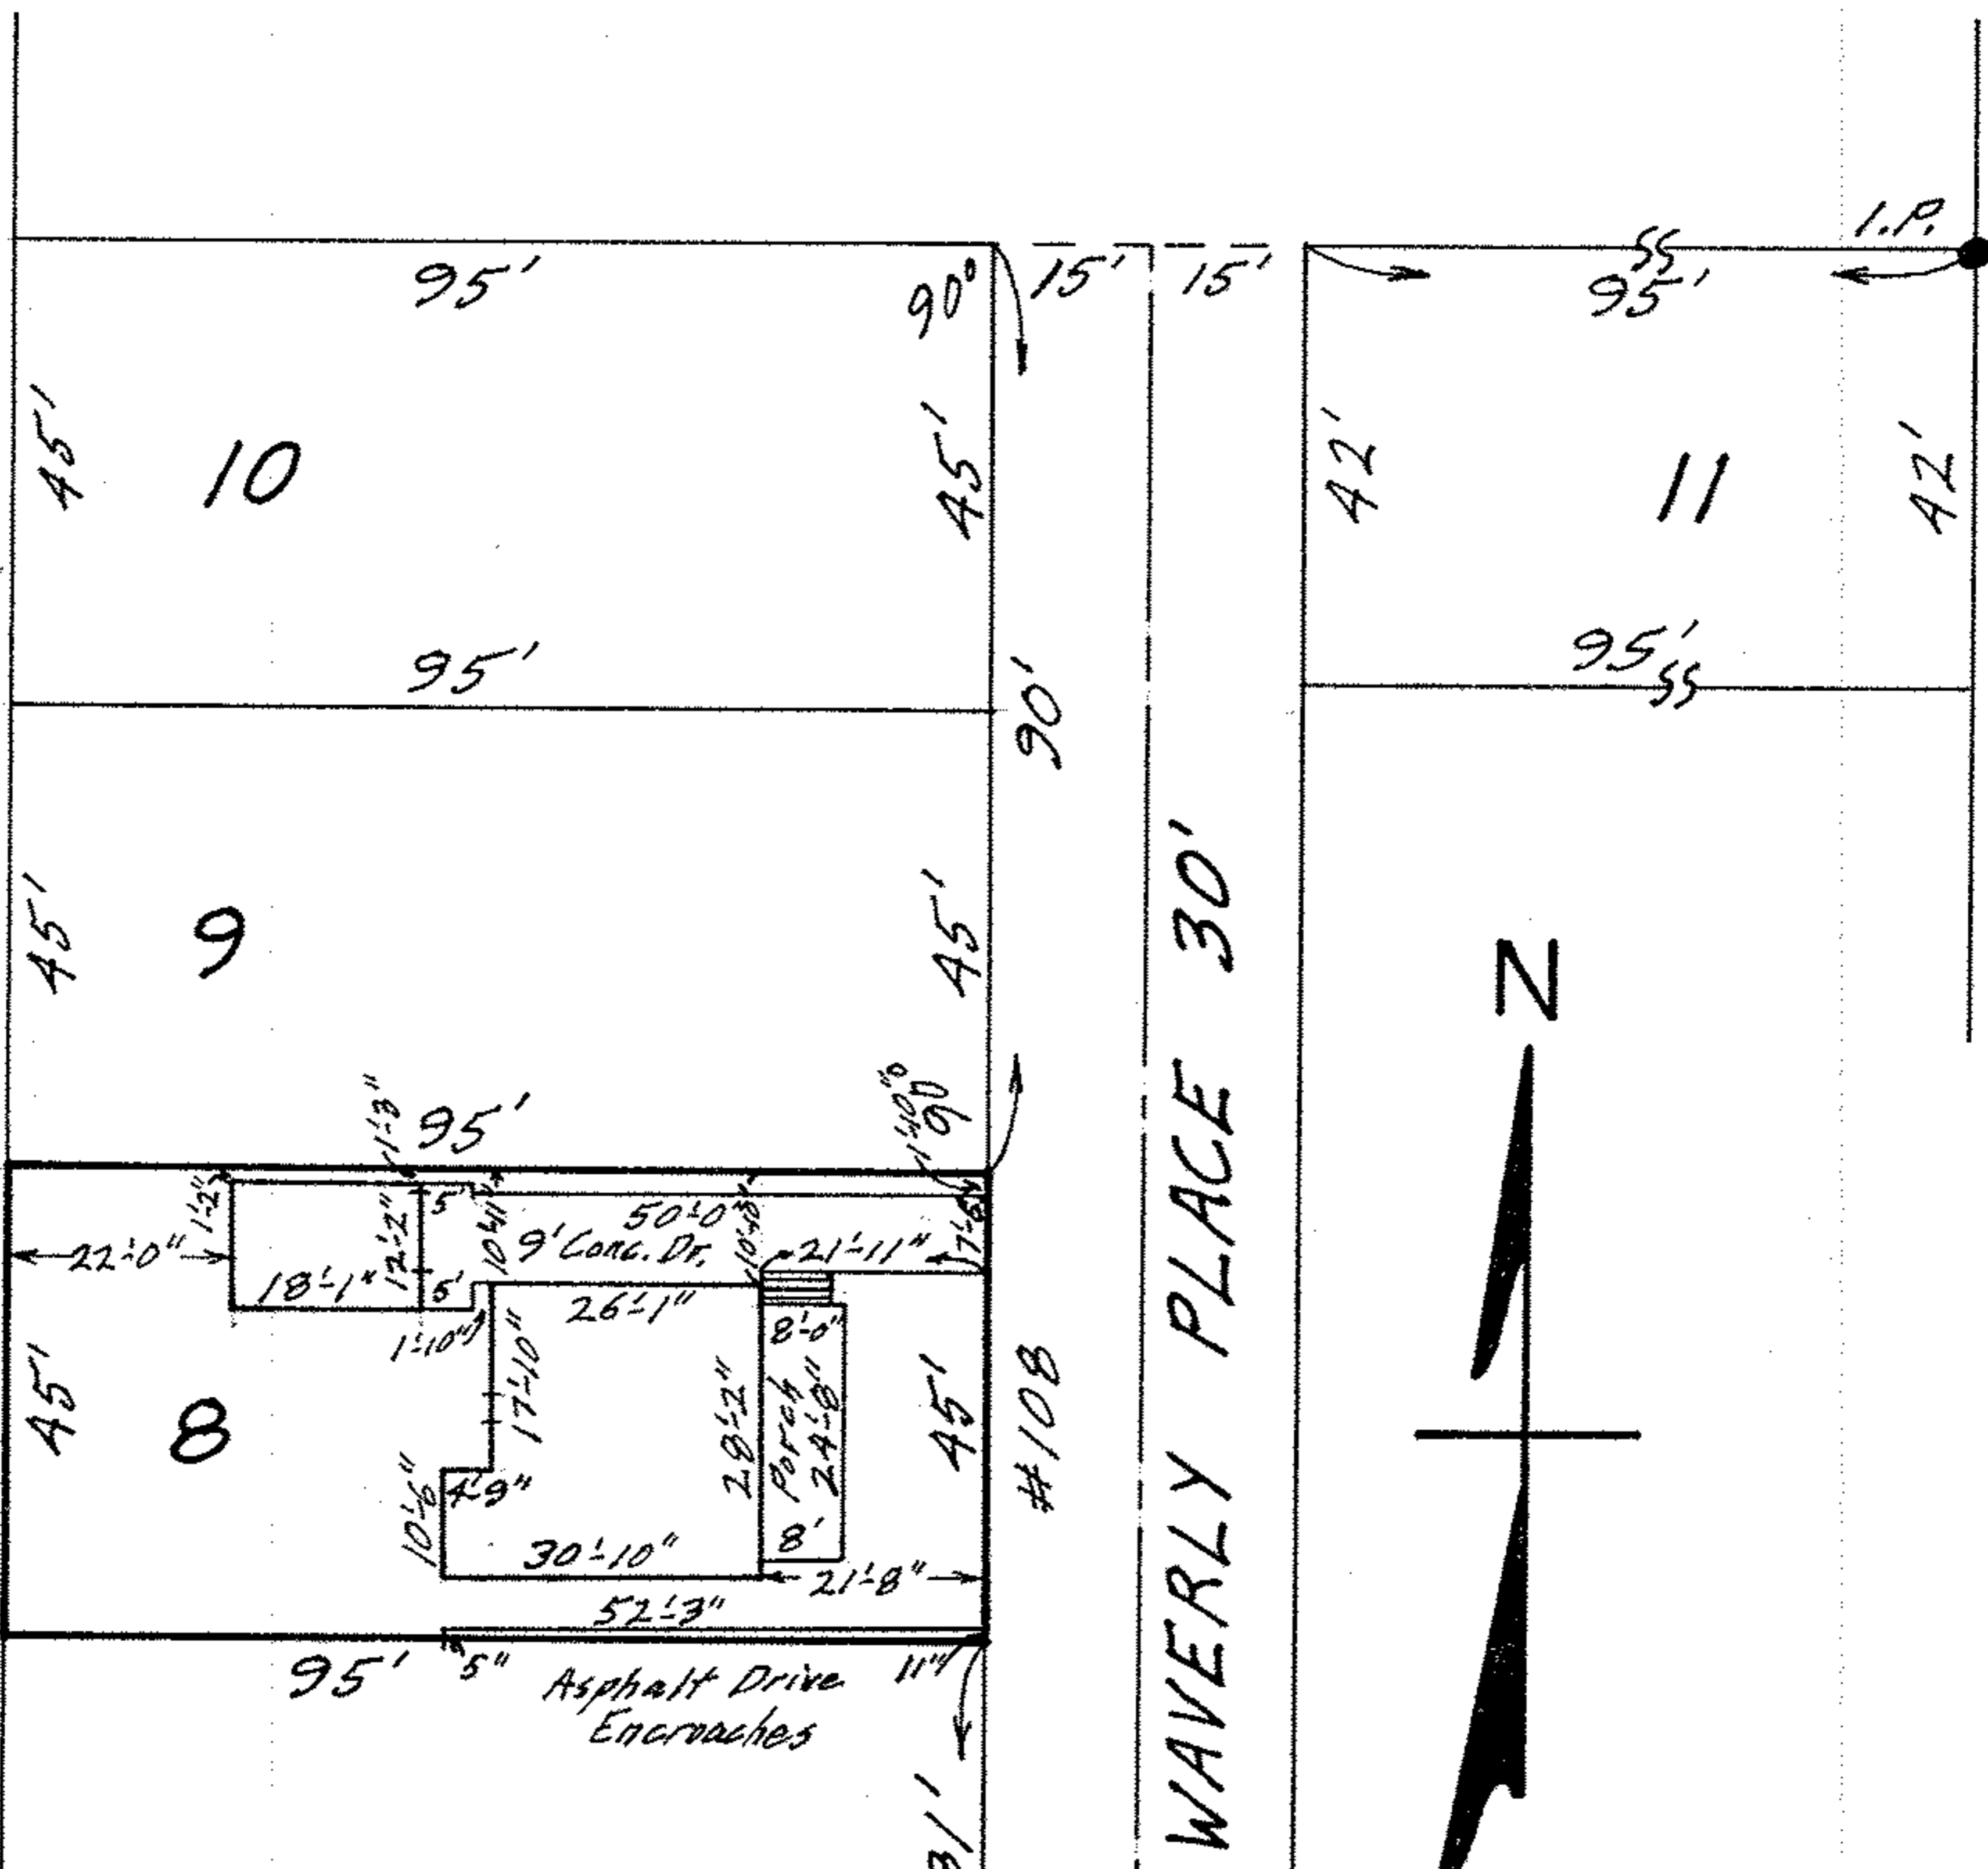

John W. & Barbara M.
 Szabo

MAP OF SUB-LOT NO. 8
 O. F. HAGEMAN TRUSTEE ALL'T.
 VOL. 8 PG. 2 PLATS
 O.L. 29-TR. 2 - BLACK RIVER TWP.
 LORAIN CITY
 LORAIN COUNTY OHIO
 SCALE 1"=30' APR. 26-1968 12:15 P.M.
 Gary E. Penfound REG. SURVEYOR