


03.00.003.000.129


SCAN # 45230

Slag and Cinder Drive

DETAIL SHEET OF PART OF ORIG. LOT NO. 3
 SHEFFIELD TWP. SHEFFIELD VILLAGE
 LORAIN COUNTY OHIO
 DETAIL SCALE: 1" = 30' NOV. 8-1969 12:15 P.M.
 Mary E. Penfound REG. SURVEYOR
 SL 19

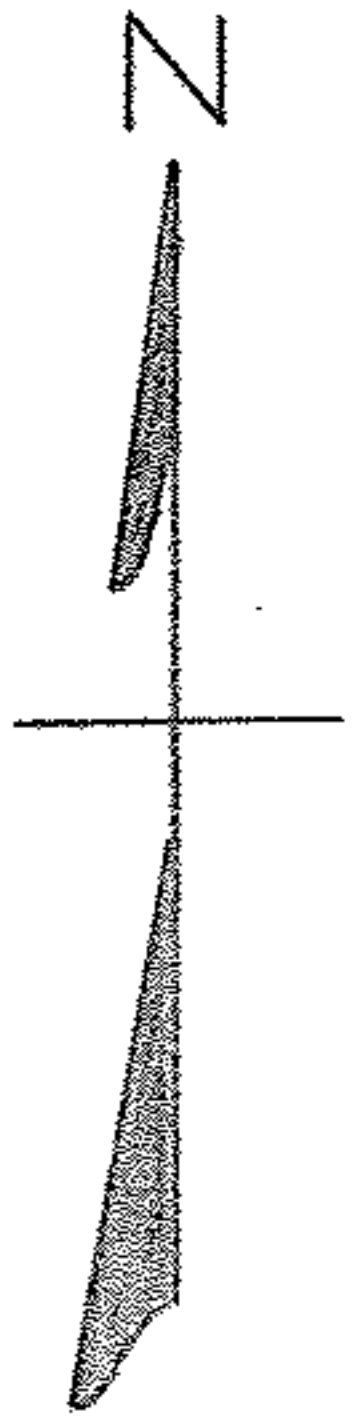

60' ABBE ROAD

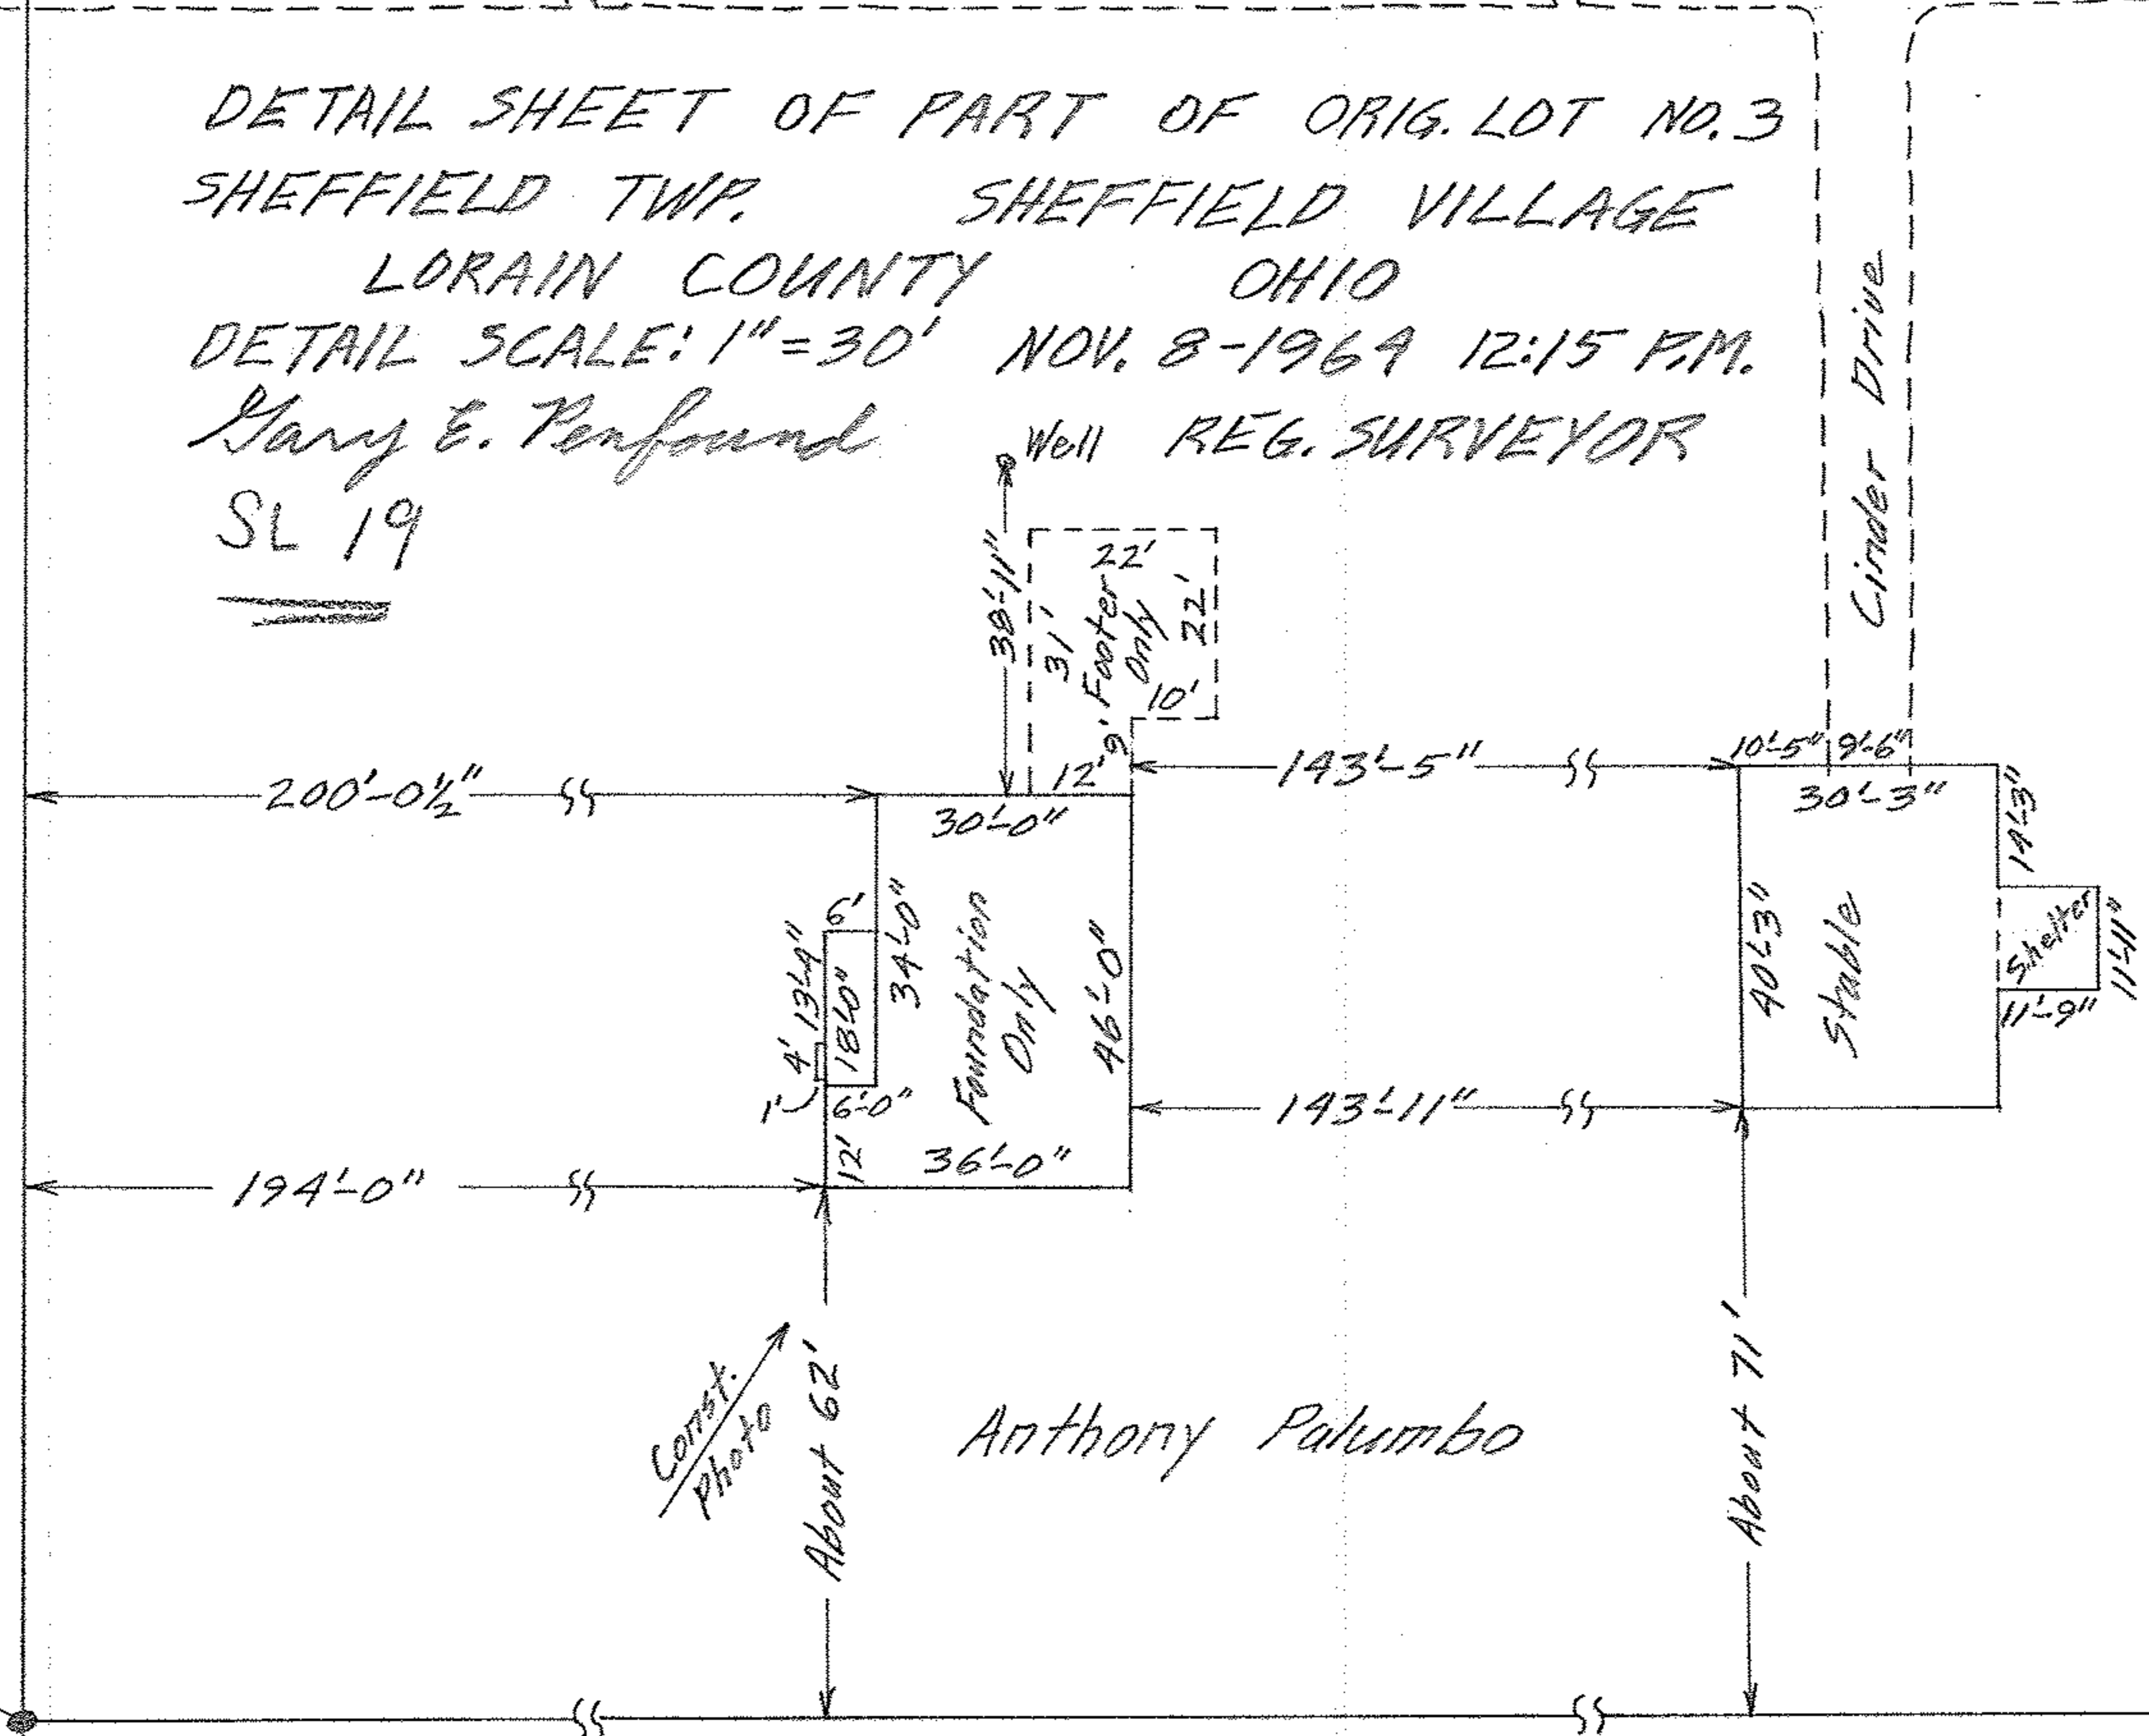

Anthony Palumbo