
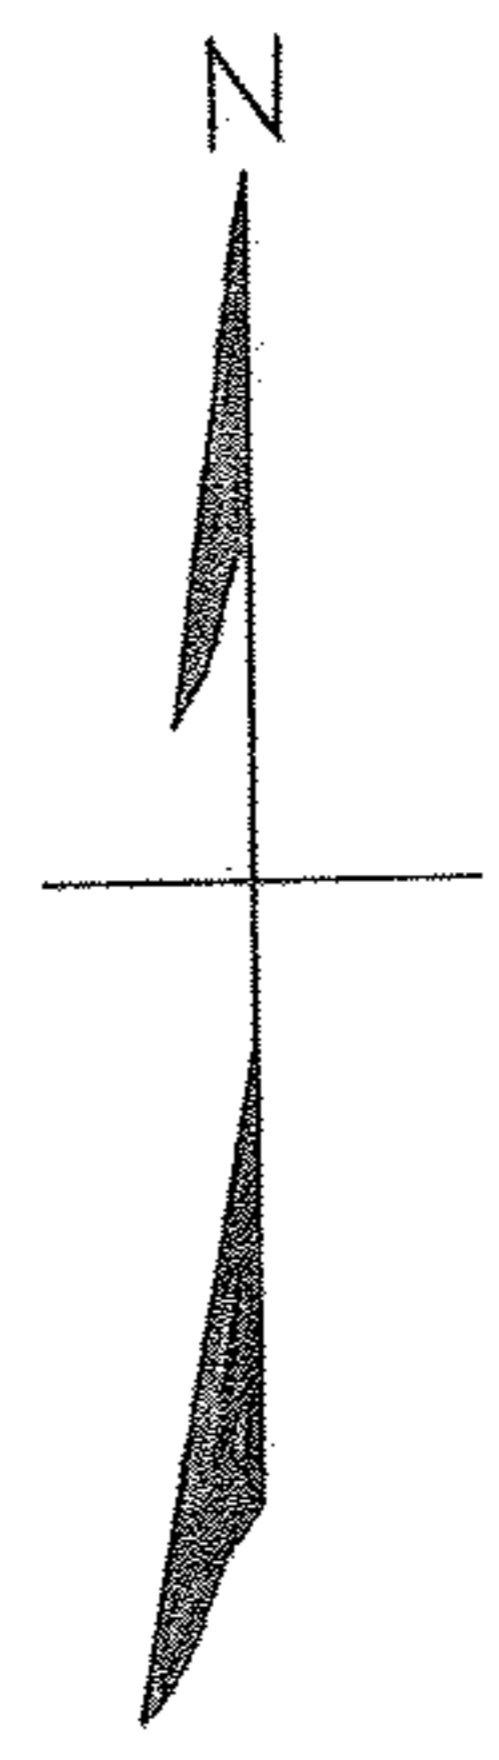


03-00-007-A
 03-00-007.02.032,033
 Charles & Stella Riske
 Scan # 45232

03-00-007-00-002

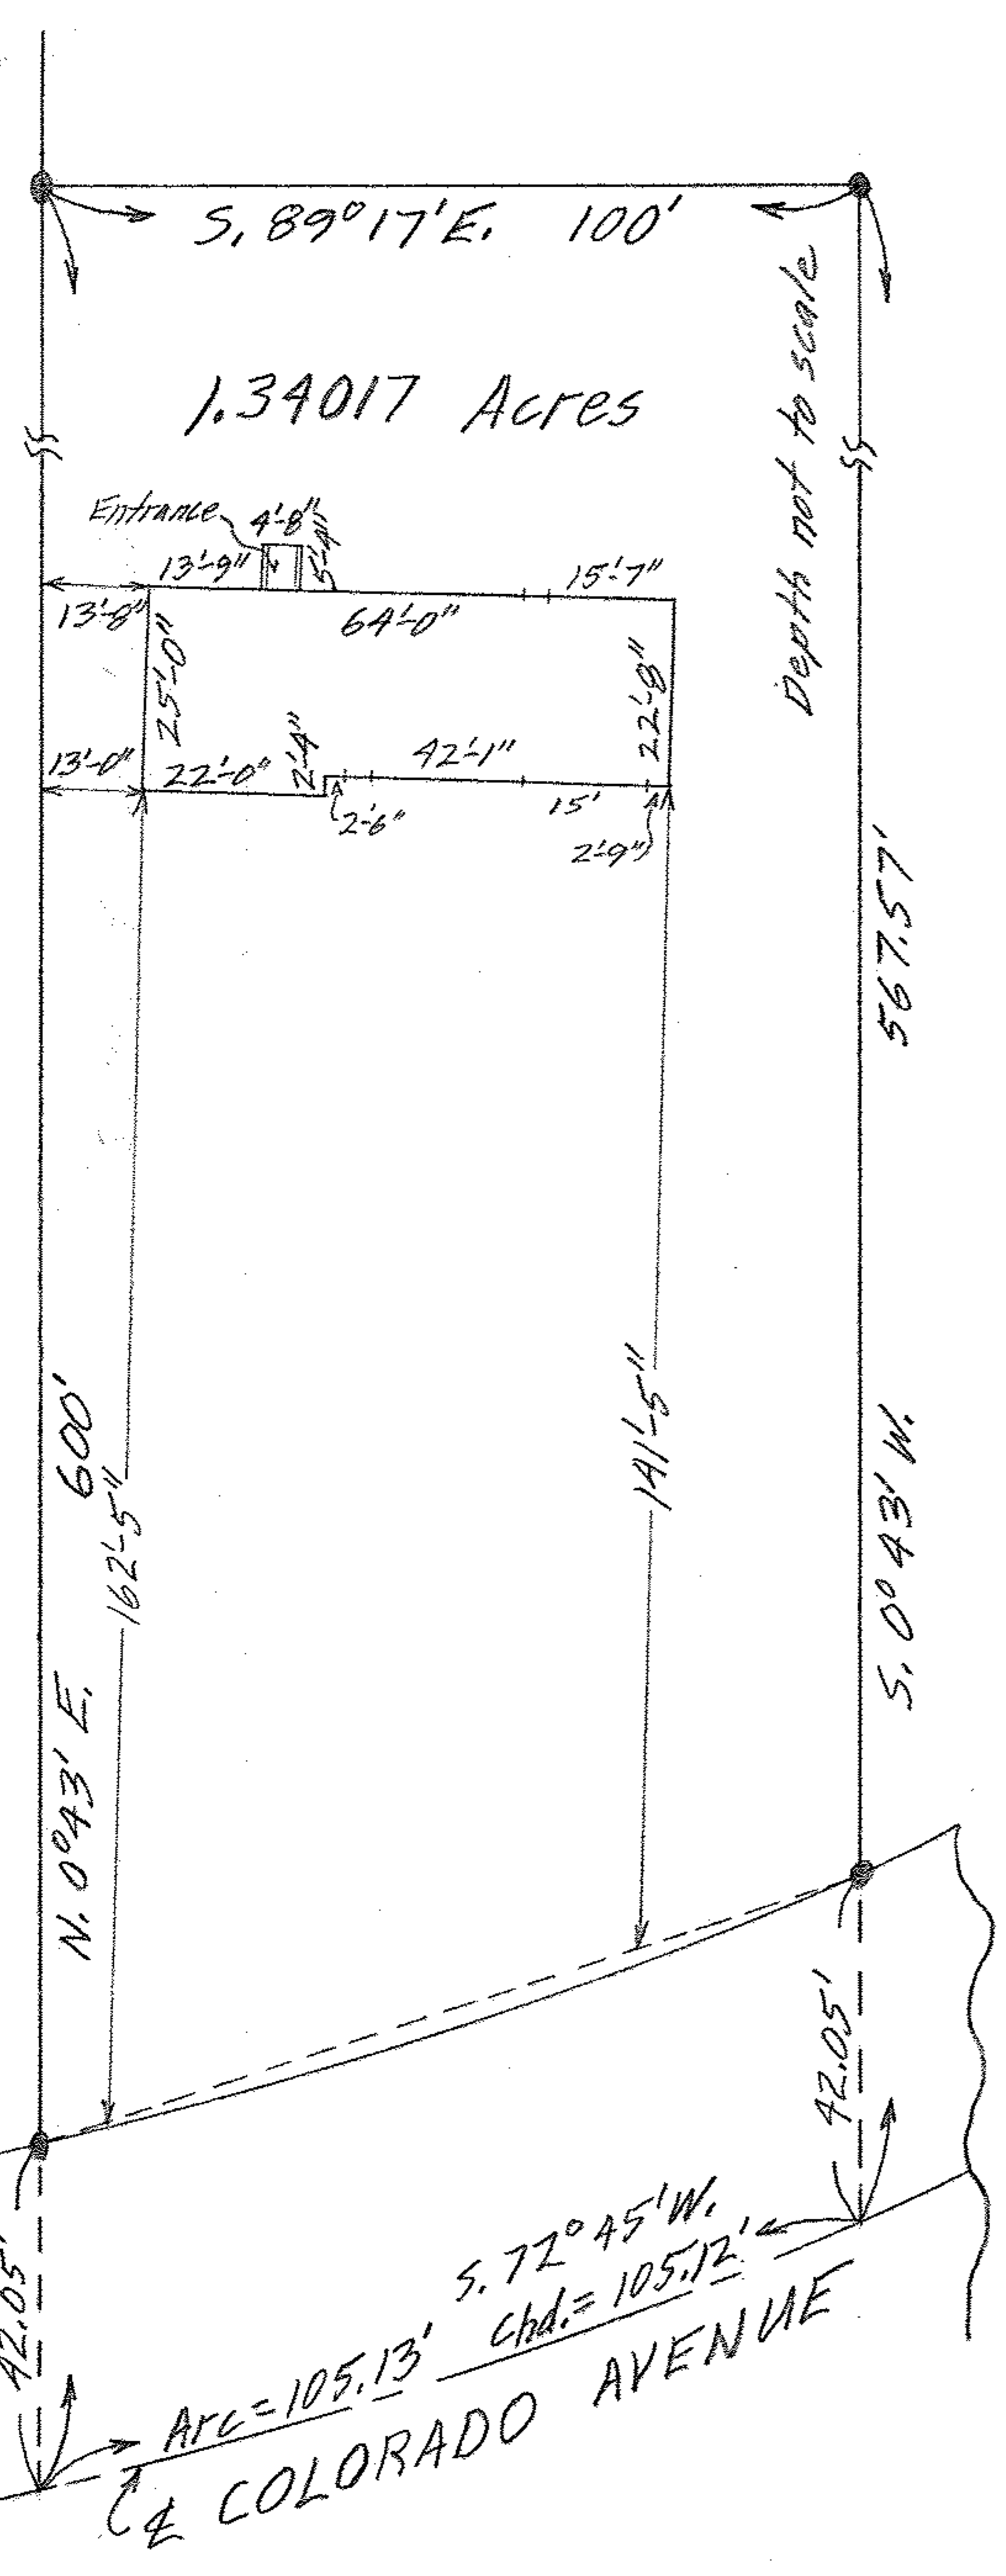

MAP OF PART OF ORIGINAL LOT NO. 7

SHEFFIELD TWP. SHEFFIELD VILLAGE

LORAIN COUNTY OHIO

SCALE: 1" = 30' APRIL 19-1962 10:00 A.M.

Gary E. Penfound REG. SURVEYOR

Anthony F. & Cecelia L. Fill

BH