


03-00-023-000-031

3

03-00-023-A

SCAN 45235

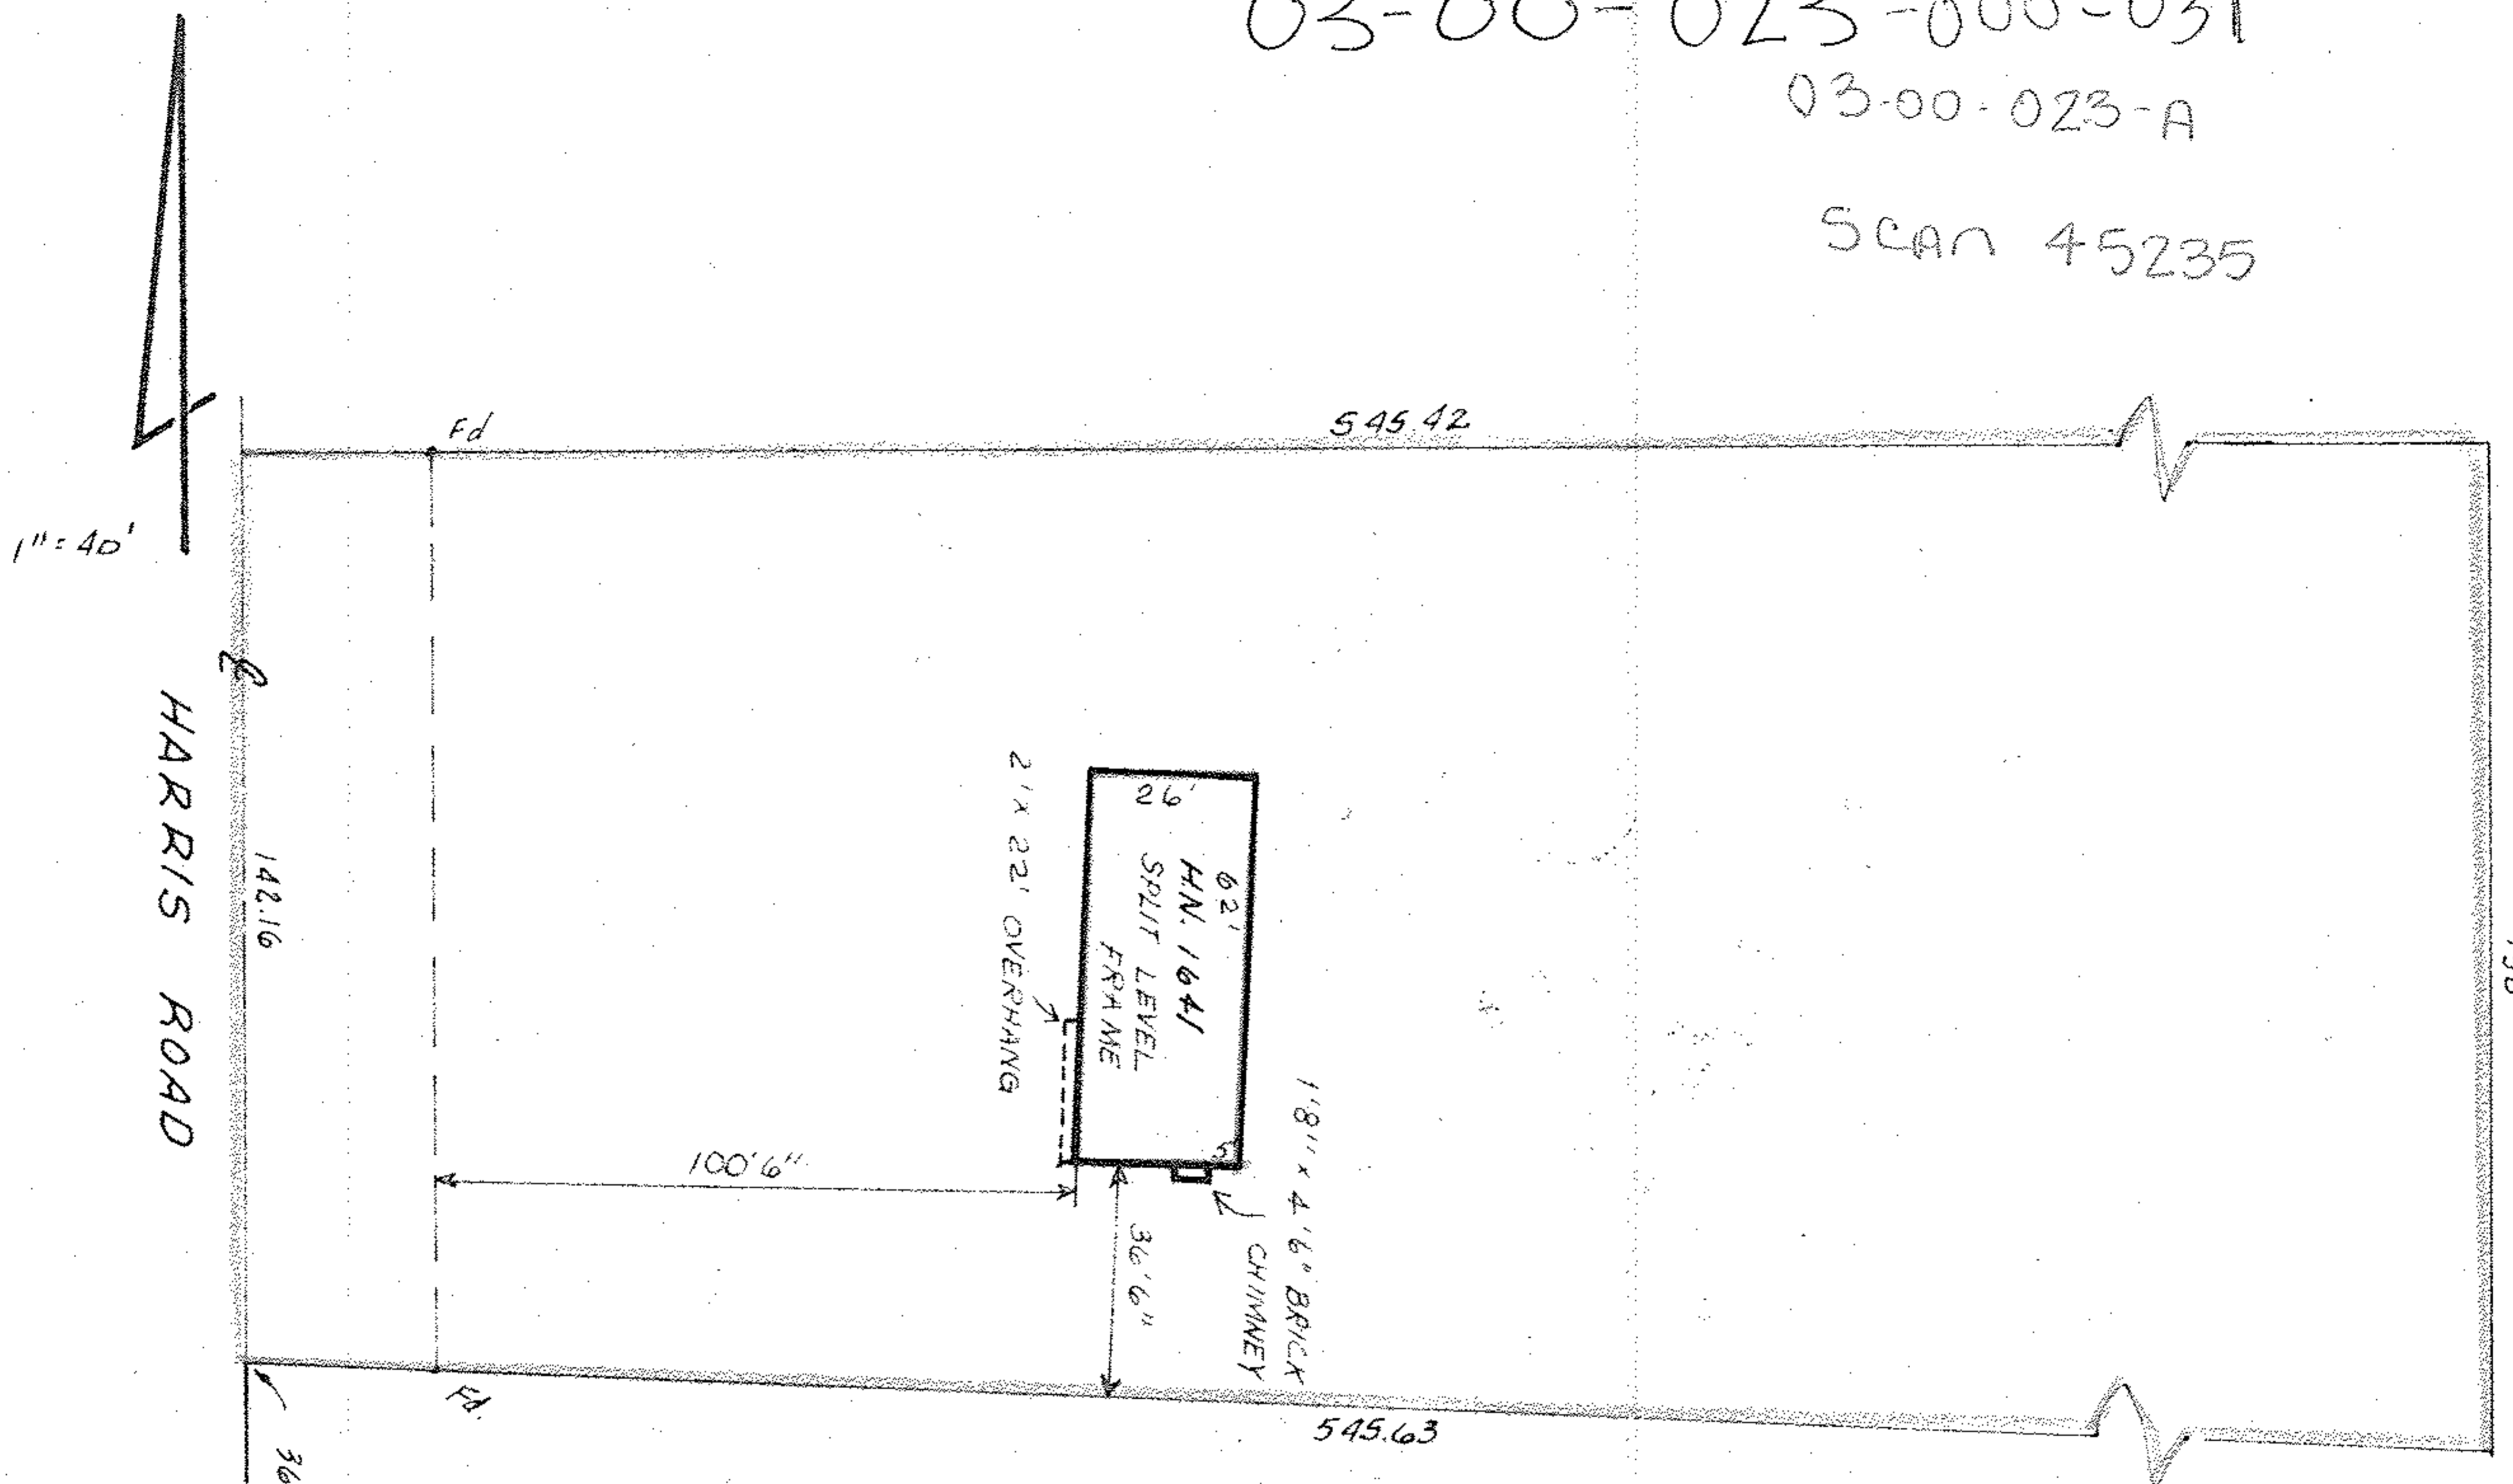

O.L. 26	O.L. 23
O.L. 25	O.L. 22

PART of ORIG. SHEFFIELD TWP. LOT 23
 NOW in SHEFFIELD VILLAGE
 LORAIN COUNTY, OHIO

MCGLINCHY & ASSOCIATES
 MAR. 9, 1977 #771661 B
 SECOND PICTURE 6/22/77

MIDT E-8310