


050-40-250 50 00-80

SCM# 45237 03.00-029-104-026  
03-00-029-B

BELLE AVENUE 50'

5.89°16'E.

#4356

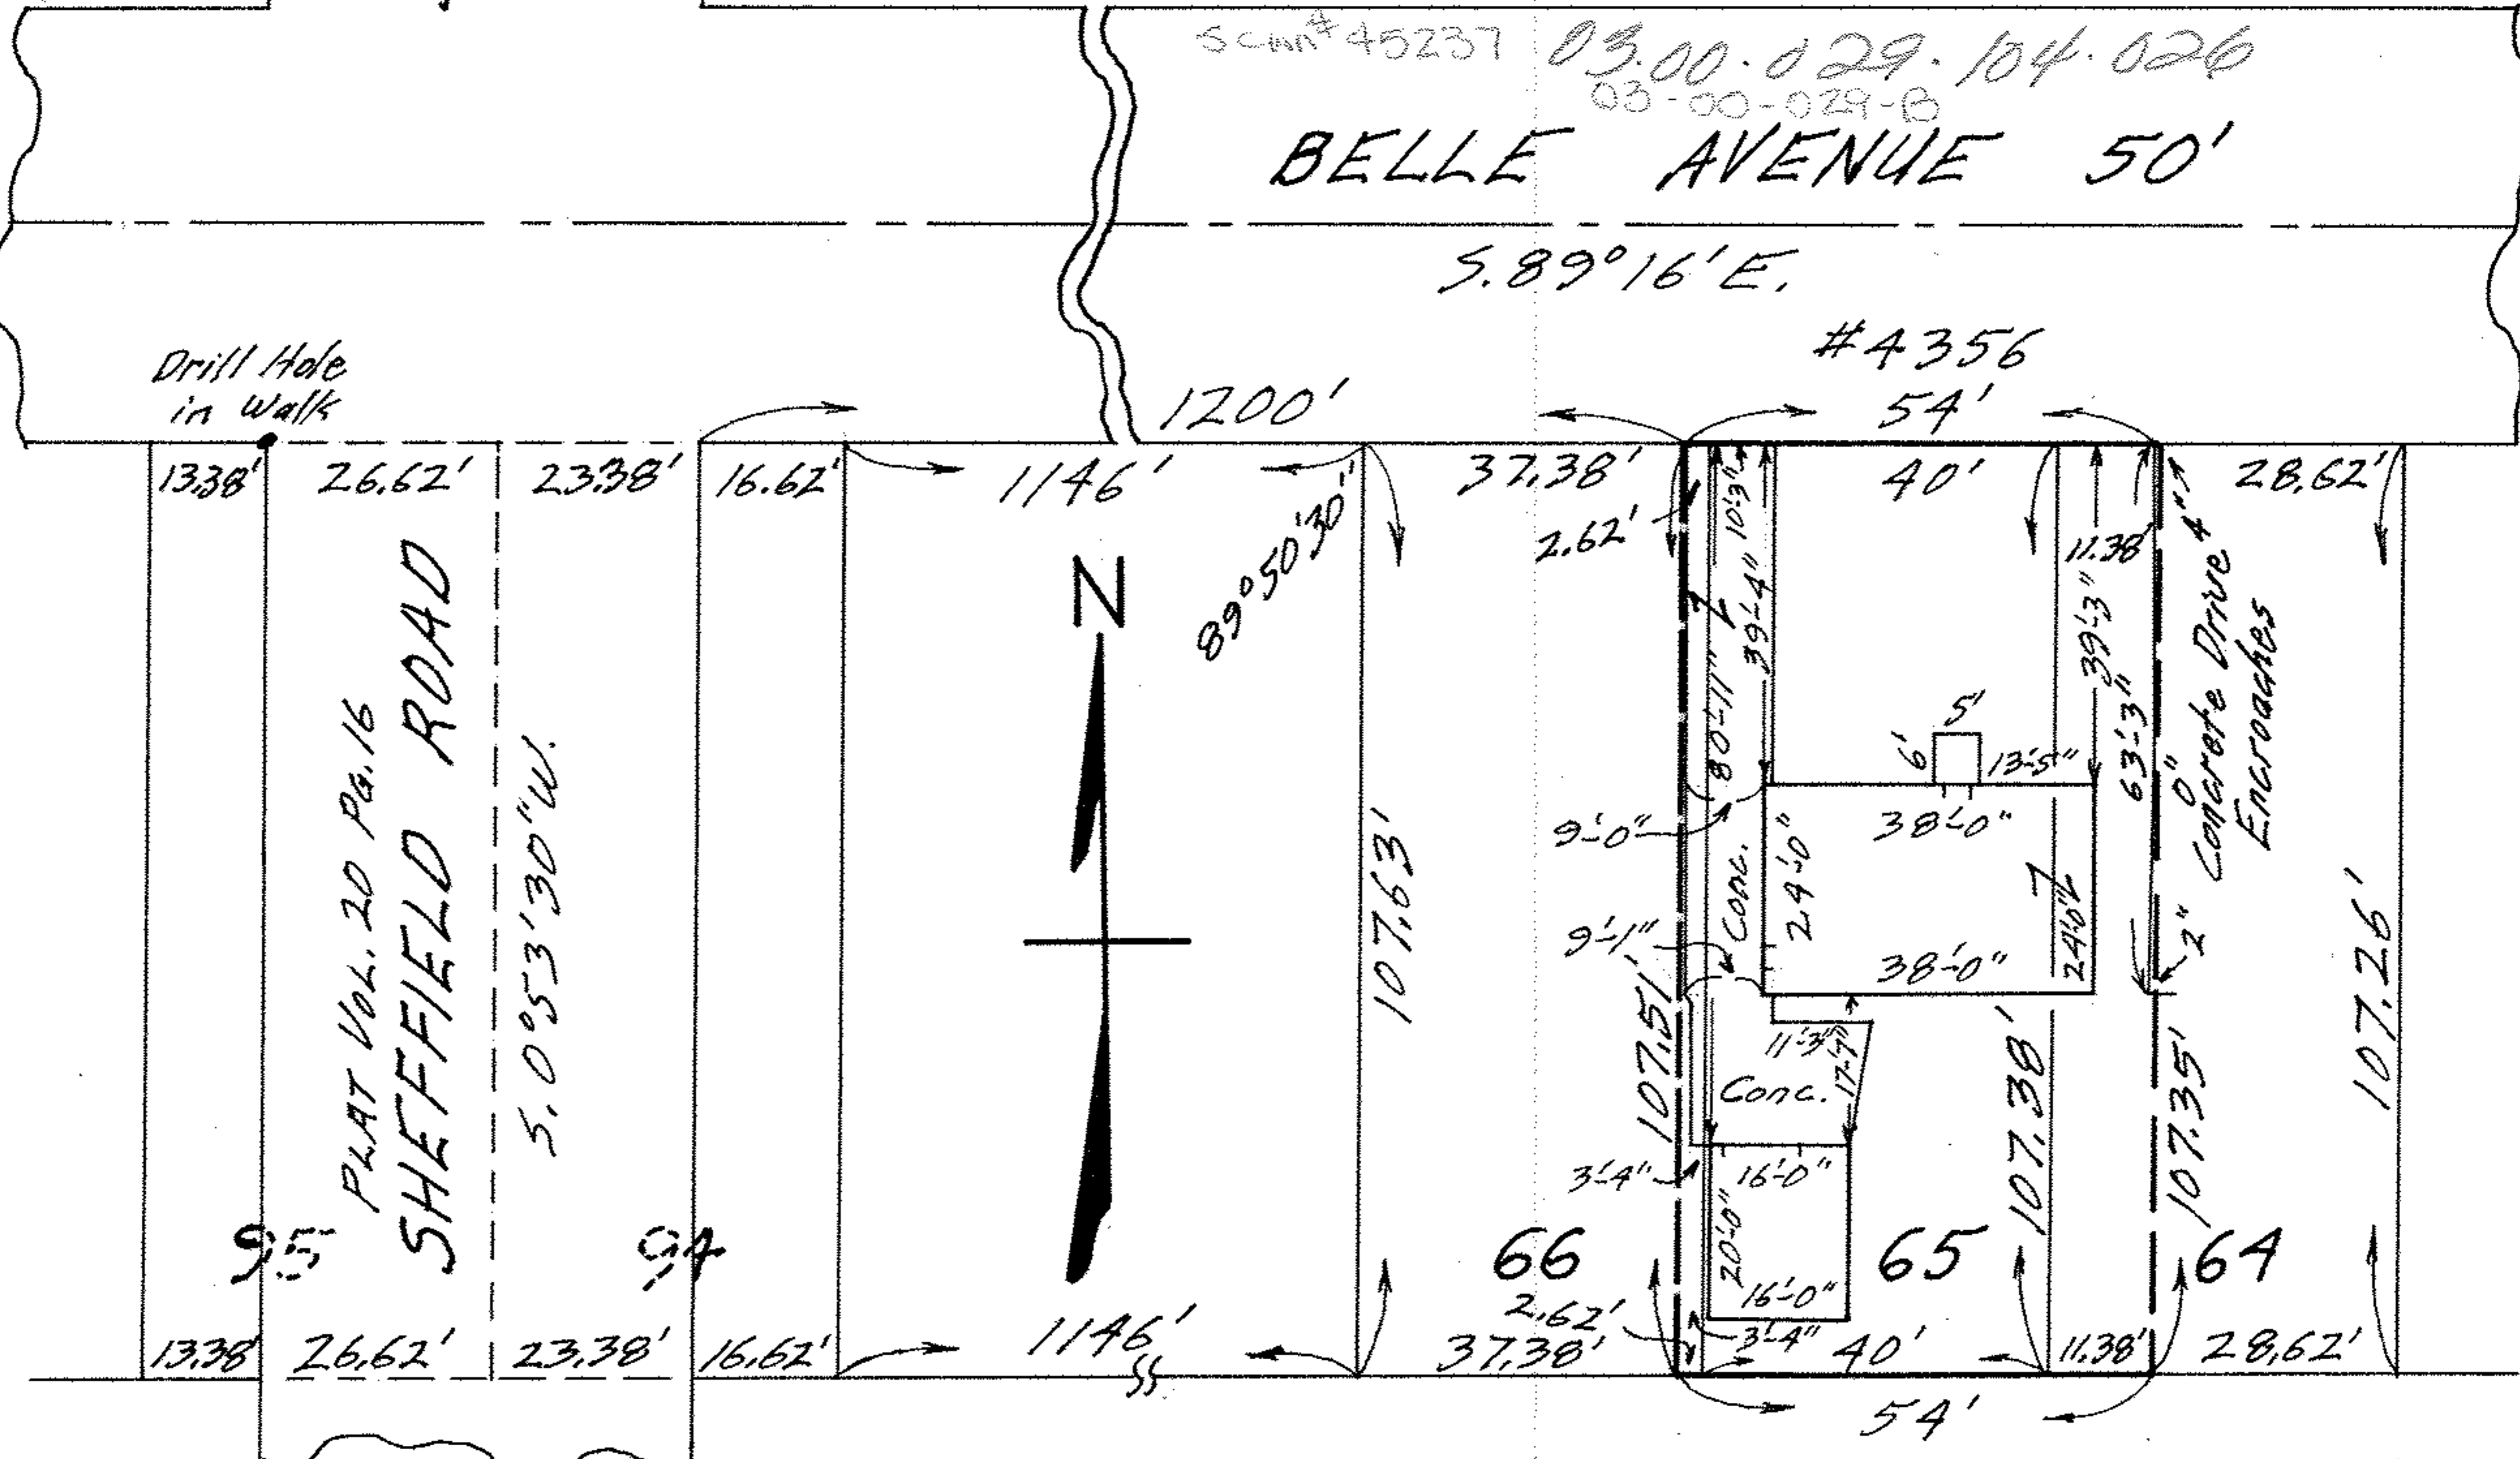

MAP OF THE WESTERLY 11.38 FEET OF SUB-LOT NO. 64, ALL OF SUB-LOT NO. 65, AND THE EASTERLY 2.62 FEET OF SUB-LOT NO. 66 OF BLOCK "D" KNICKERBOCKER SUB'N. NO. 2 VOL. 12 PG. 16 PLATS ORIG. LOT NO. 29 SHEFFIELD TWP. - SHEFFIELD LAKE CITY - LORAIN COUNTY - OHIO SCALE: 1" = 30' NOV. 3-1970 10:15 A.M.

NOTE: Concrete Drive encroaches from the east.

Gary E. Penfound REG. SURVEYOR NO. 4457