
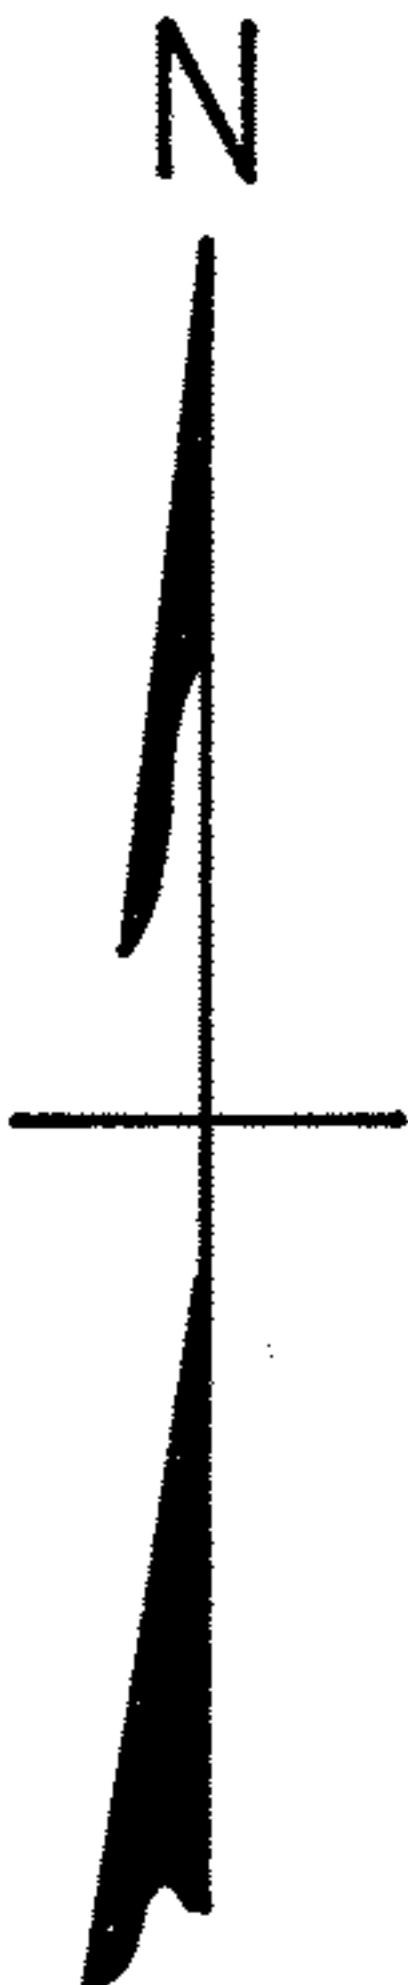


03-00-036-121-007-008
 03-00-036-A
 SCAN # 45256

03-00-036-121-007-008

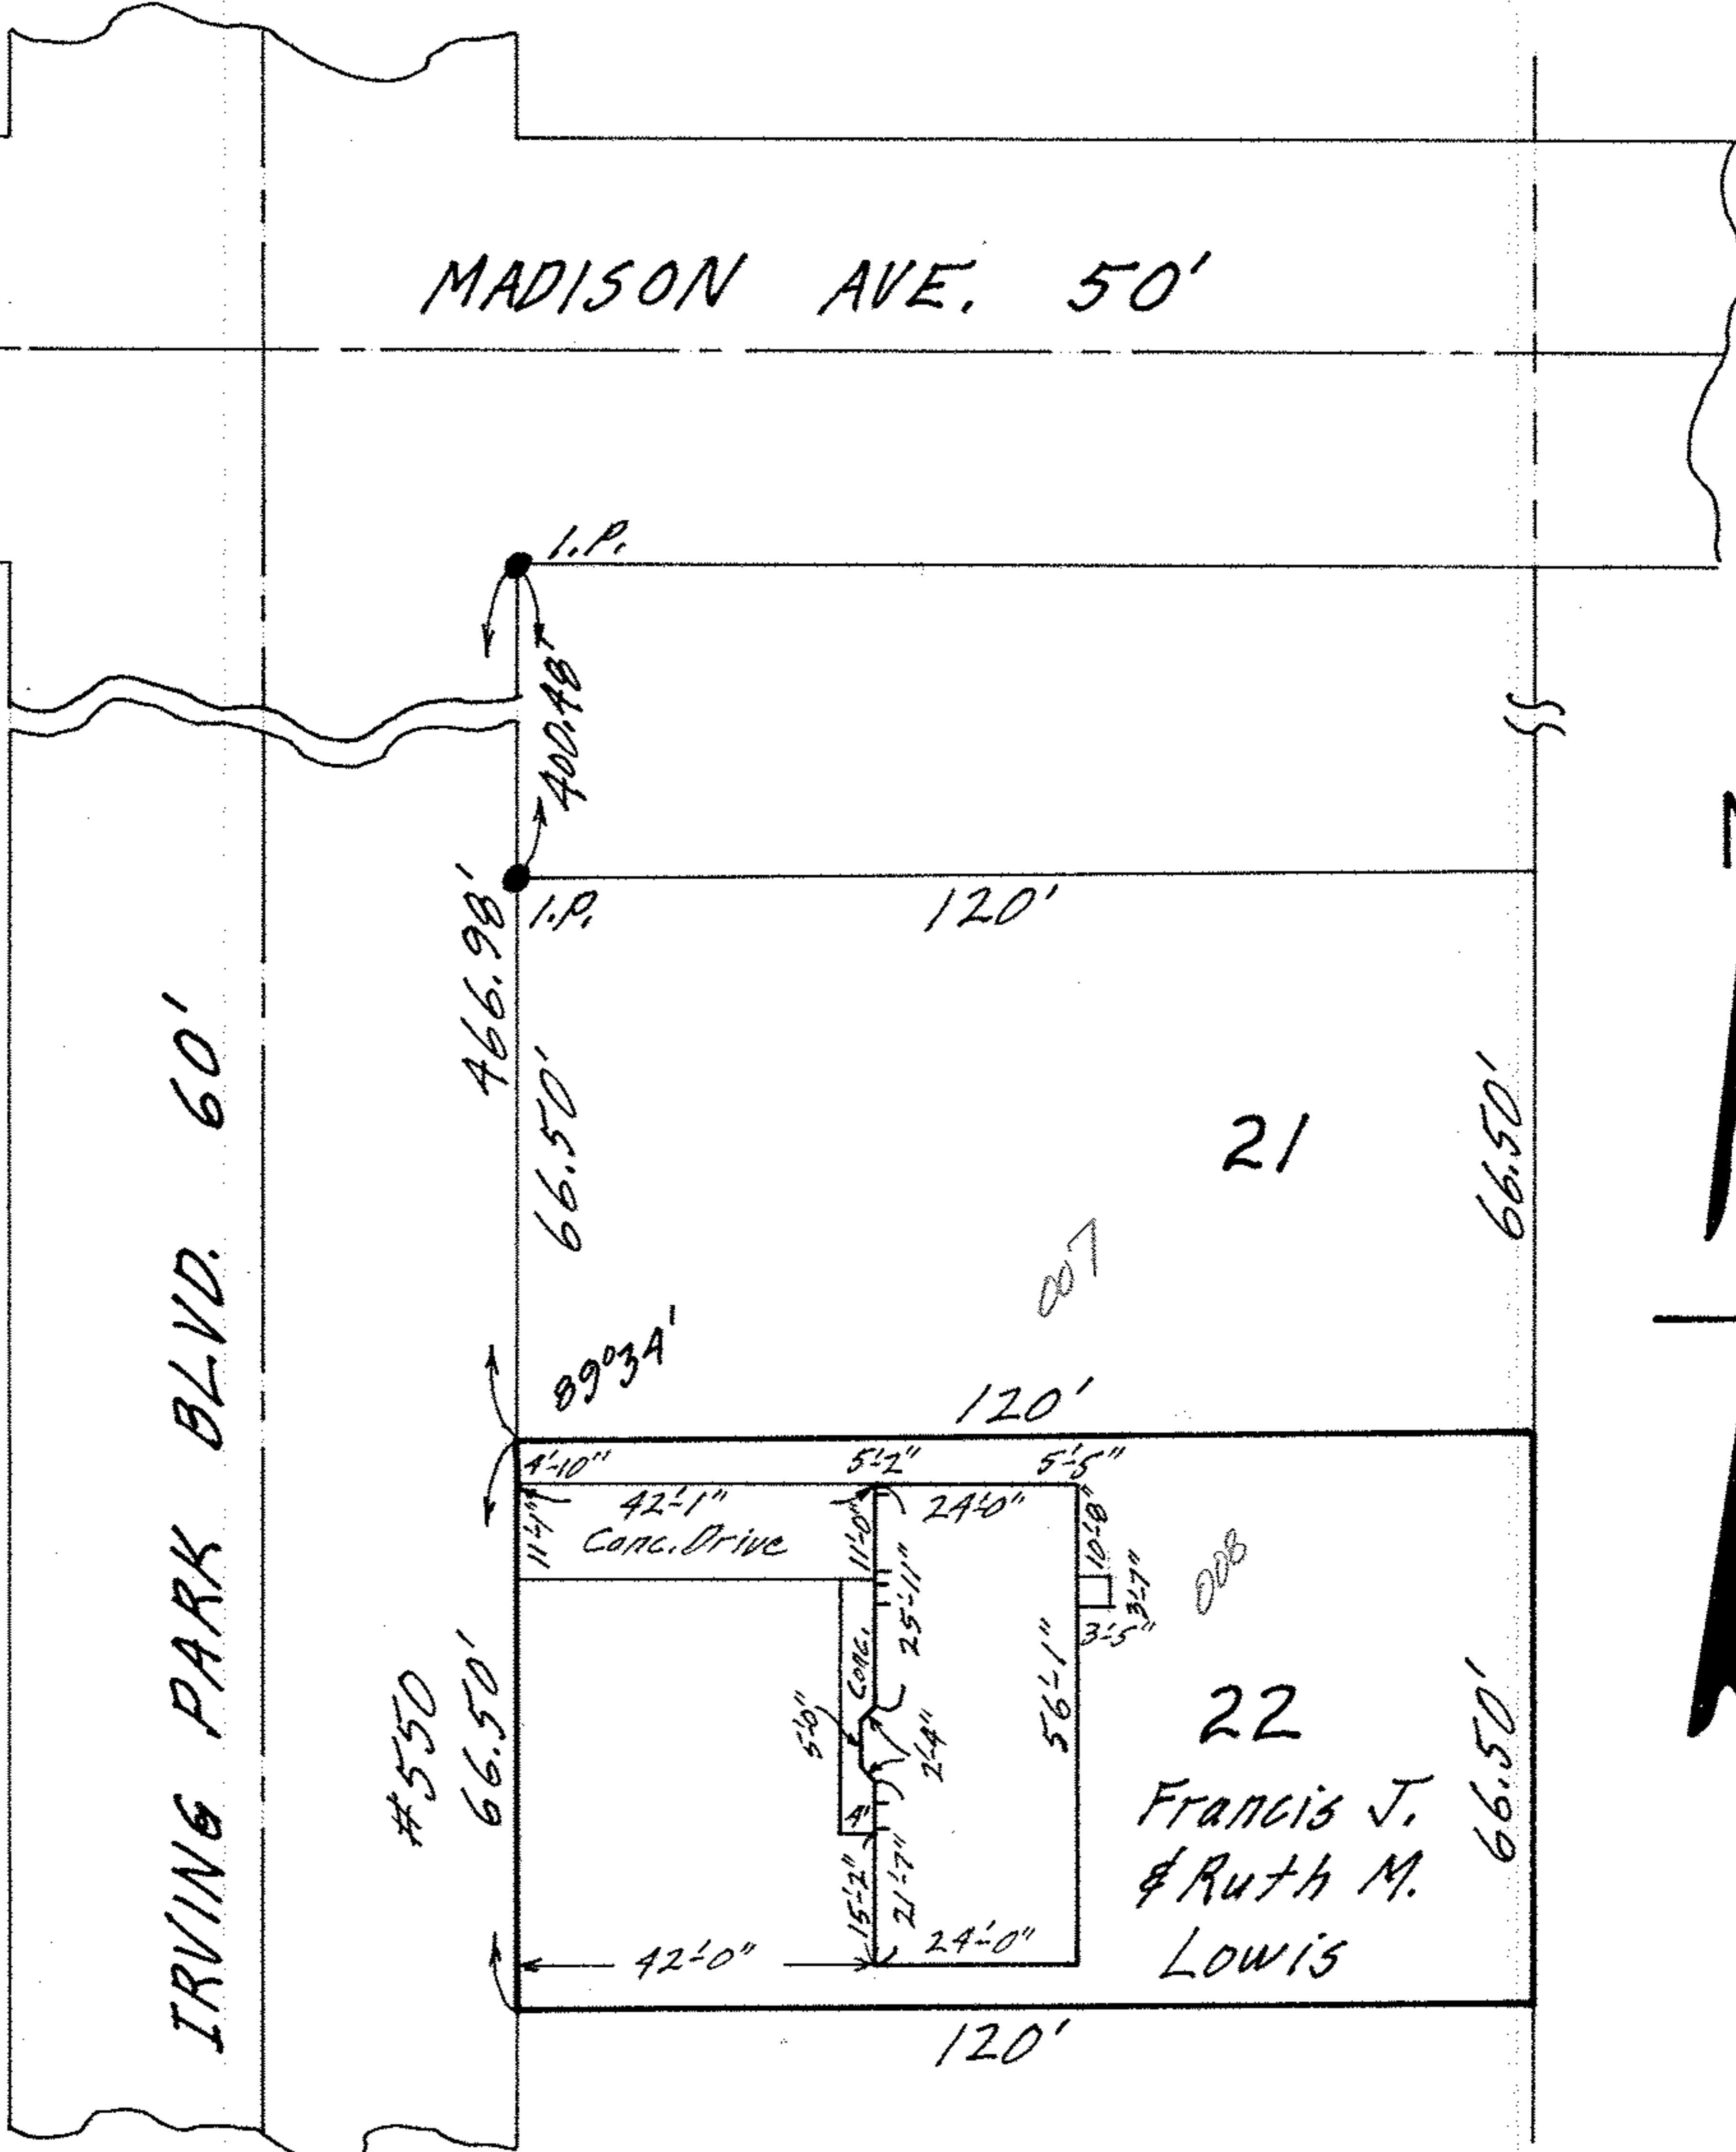

MAP OF SUB-LOT NO. 22
 PADWAY ALL'T. VOL. 17 PG. 10 PLATS
 ORIG. LOT 36 SHEFFIELD TOWNSHIP
 SHEFFIELD LAKE CITY - LORAIN CO. - OHIO
 SCALE: 1" = 30' JAN. 12-1969 1:00 P.M.
 Gary E. Penfound REG. SURVEYOR