


03-00-037-108-001, 049
03-00-037-A
SCAN # 45257

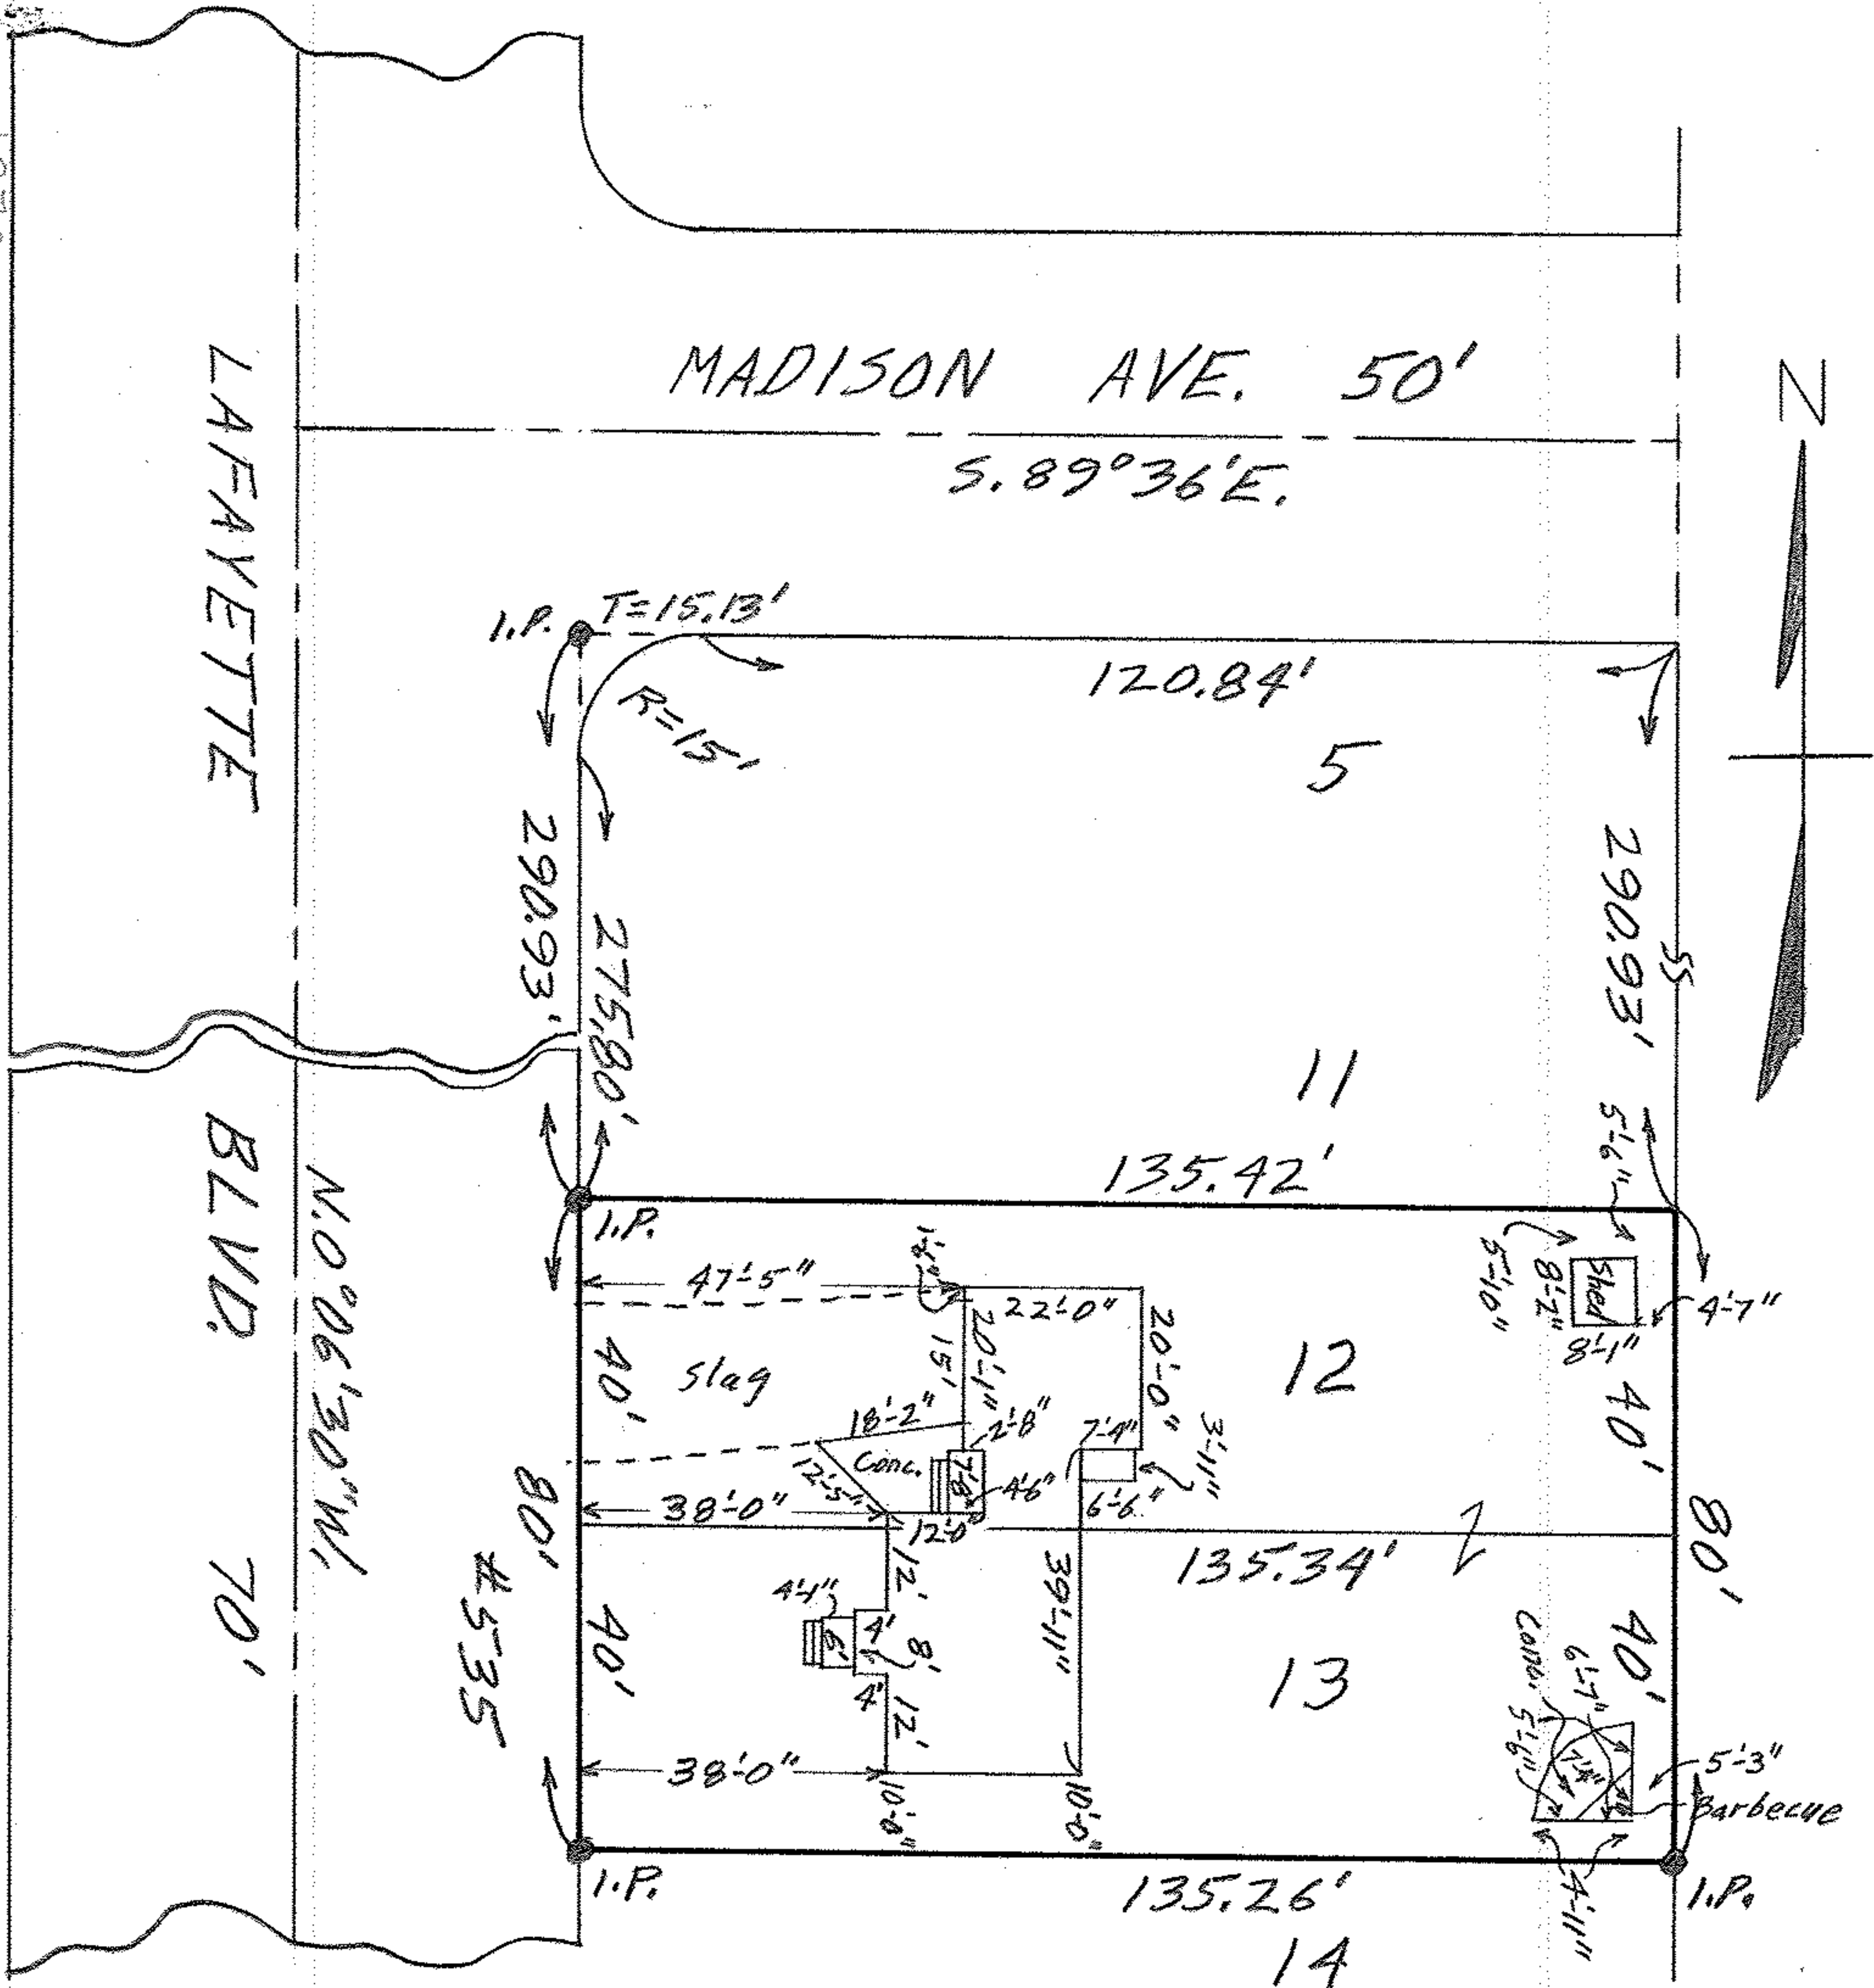

03-00-037-108-001, 049
03-00-037-A
SCAN # 45257

MAP OF SUB-LOTS NO'S. 12 & 13 BLOCK "C"
CORAL BEACH SUB'D. VOL. 11 PGS. 17 & 18

SHEFFIELD LAKE VILLAGE

LORAIN COUNTY OHIO

SCALE: 1" = 30' DEC. 9 - 1965 9:20 A.M.

Mary E. Penfound REG. SURVEYORS
for C. E. Penfound

GL-1253 William & Mary Ellison