
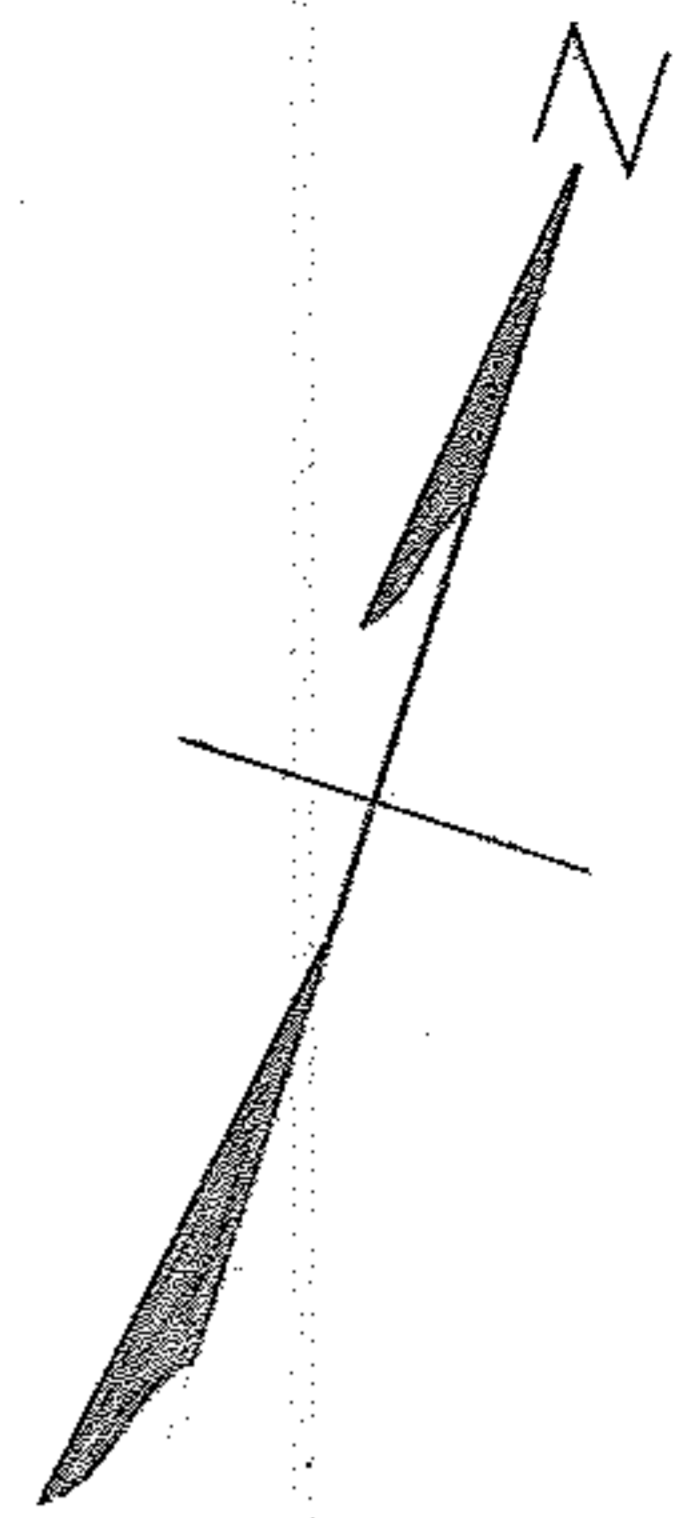


SCAN# 452508
 03-00-038-101-054
 03-00-038-A 5

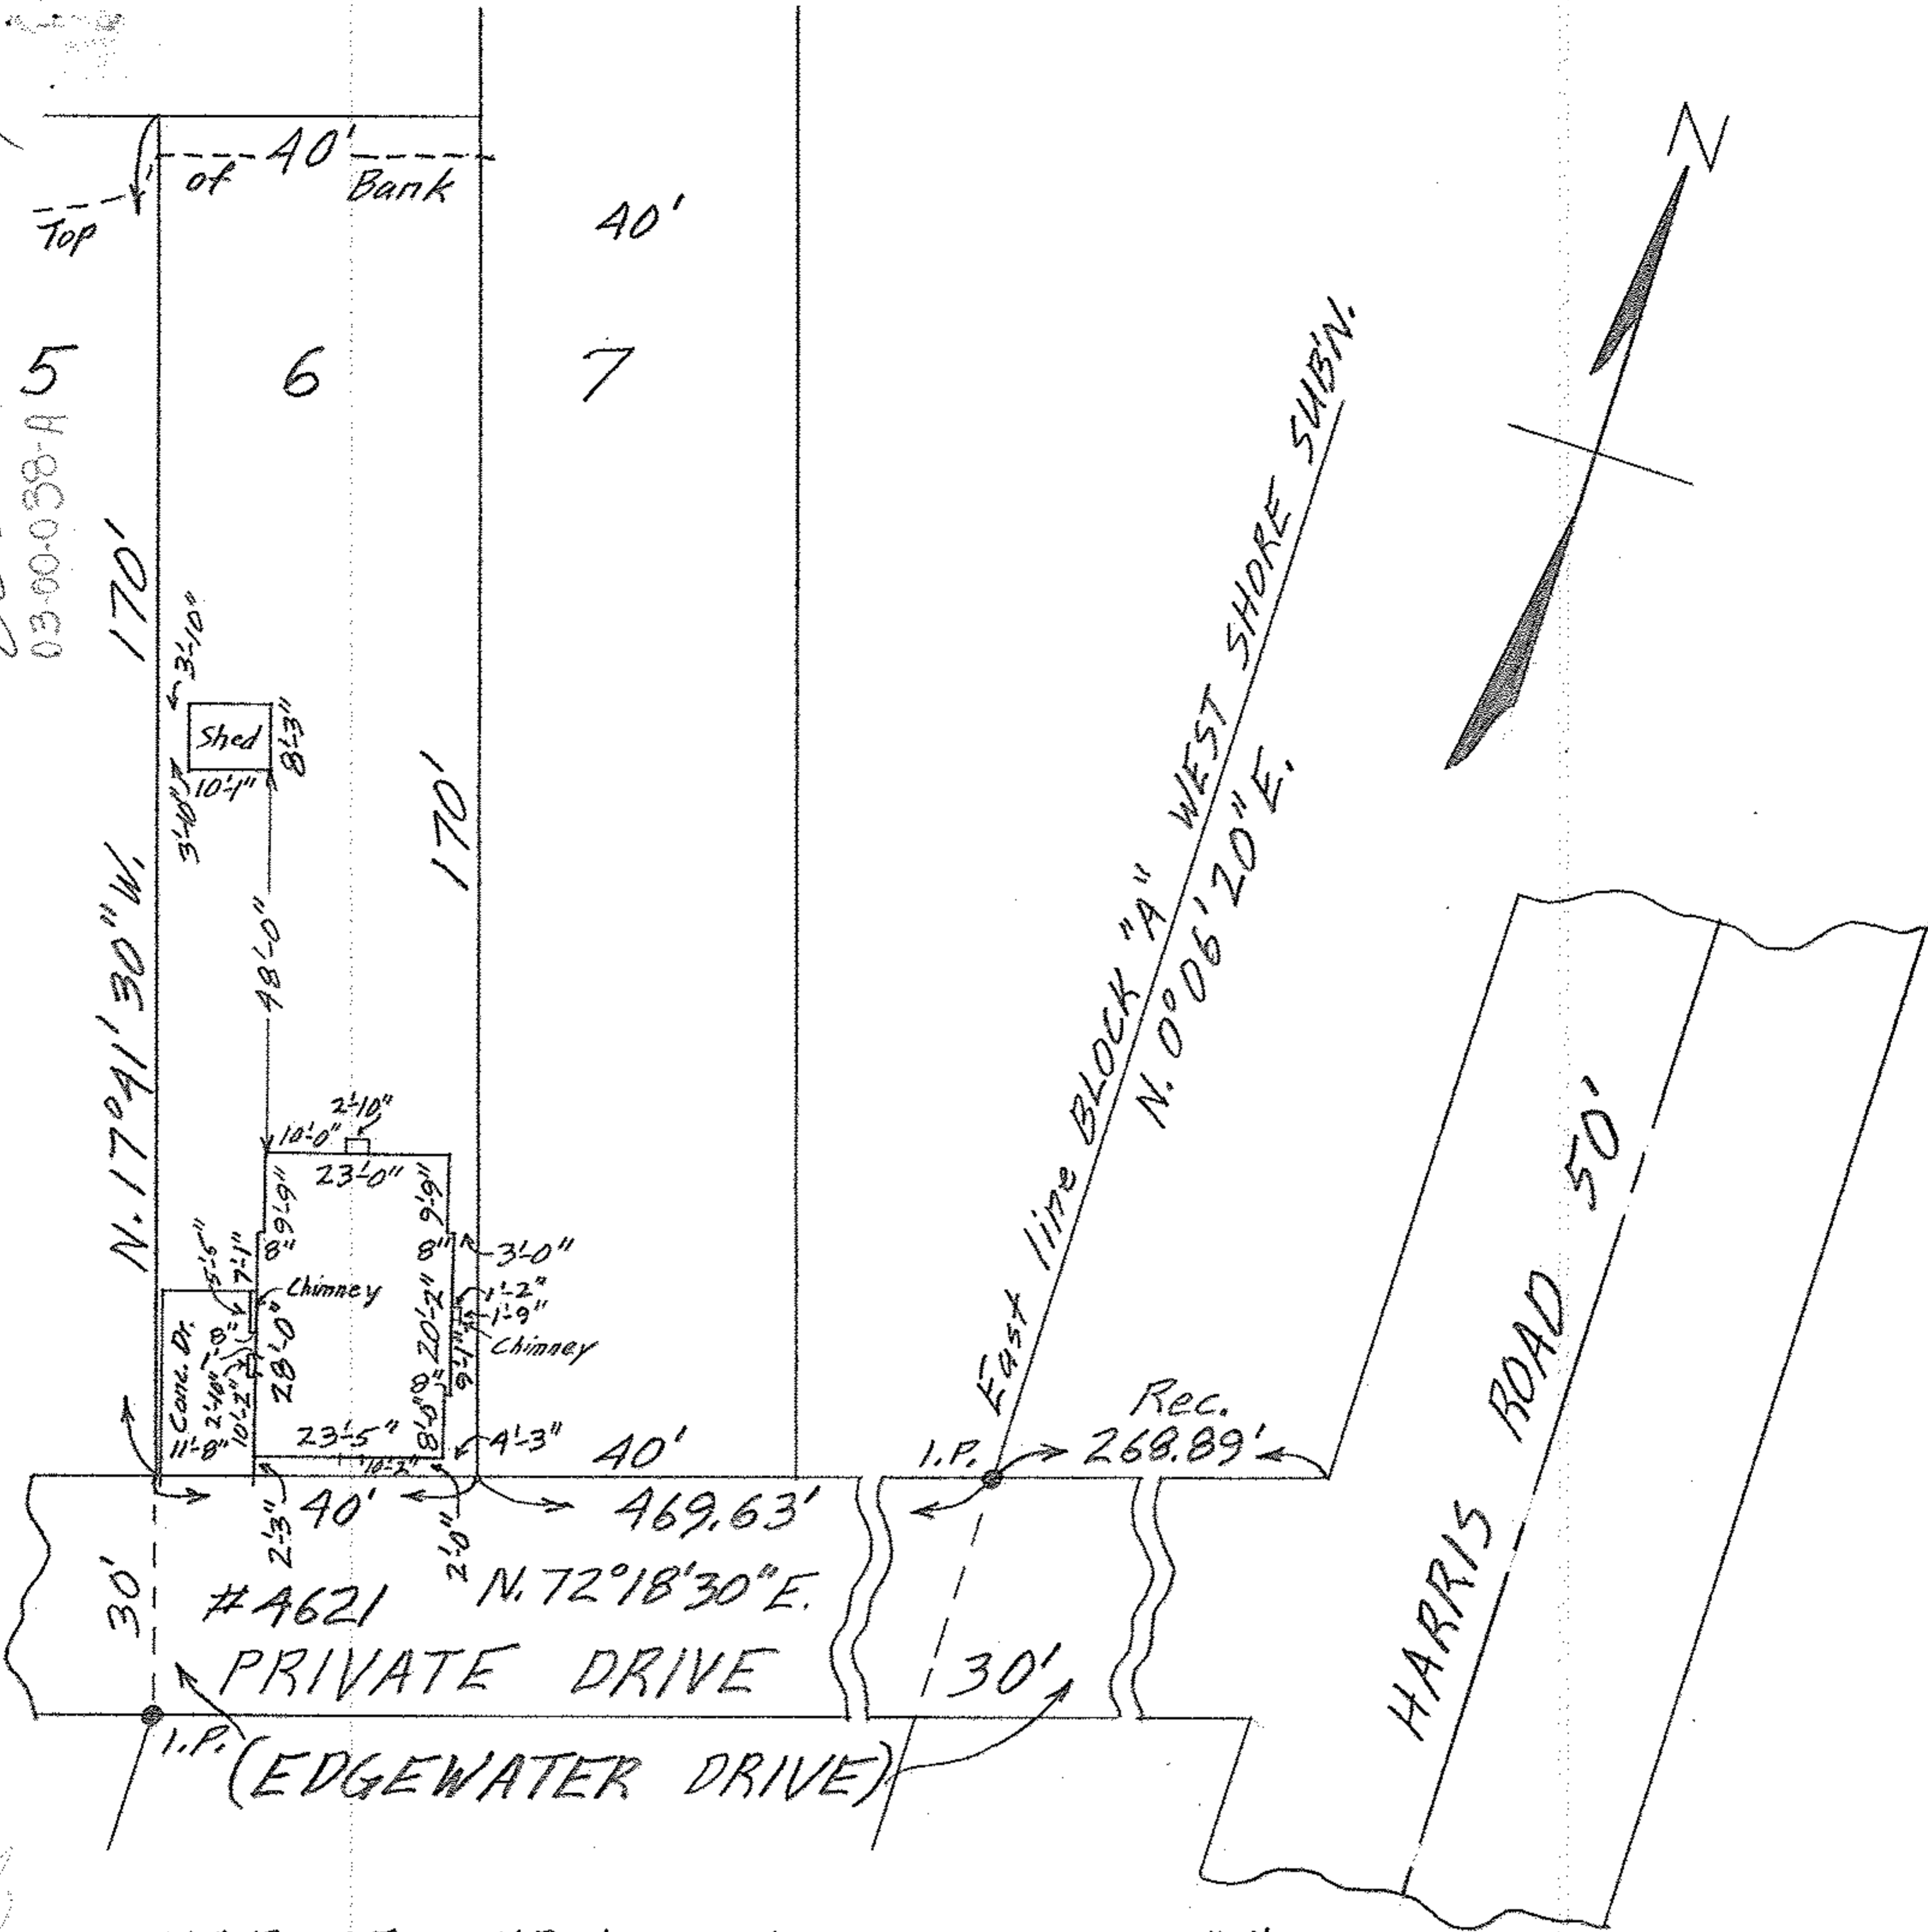

03-00-038-101-054

MAP OF SUB-LOT NO. 6 - BLOCK "A"
 WEST SHORE SUB'N. Vol. 10 Pg. 3 PLATS
 ORIG. LOT 38 SHEFFIELD TOWNSHIP
 SHEFFIELD LAKE VILLAGE
 LORAIN COUNTY OHIO
 SCALE: 1" = 30' NOV. 11-1964 2:00 P.M.
 Gary E. Penfound REG. SURVEYOR
 Martin Wukie