


03-00-038-115-066

03-00-038-B

SCAN # 45260



SCALE: 1"=20'

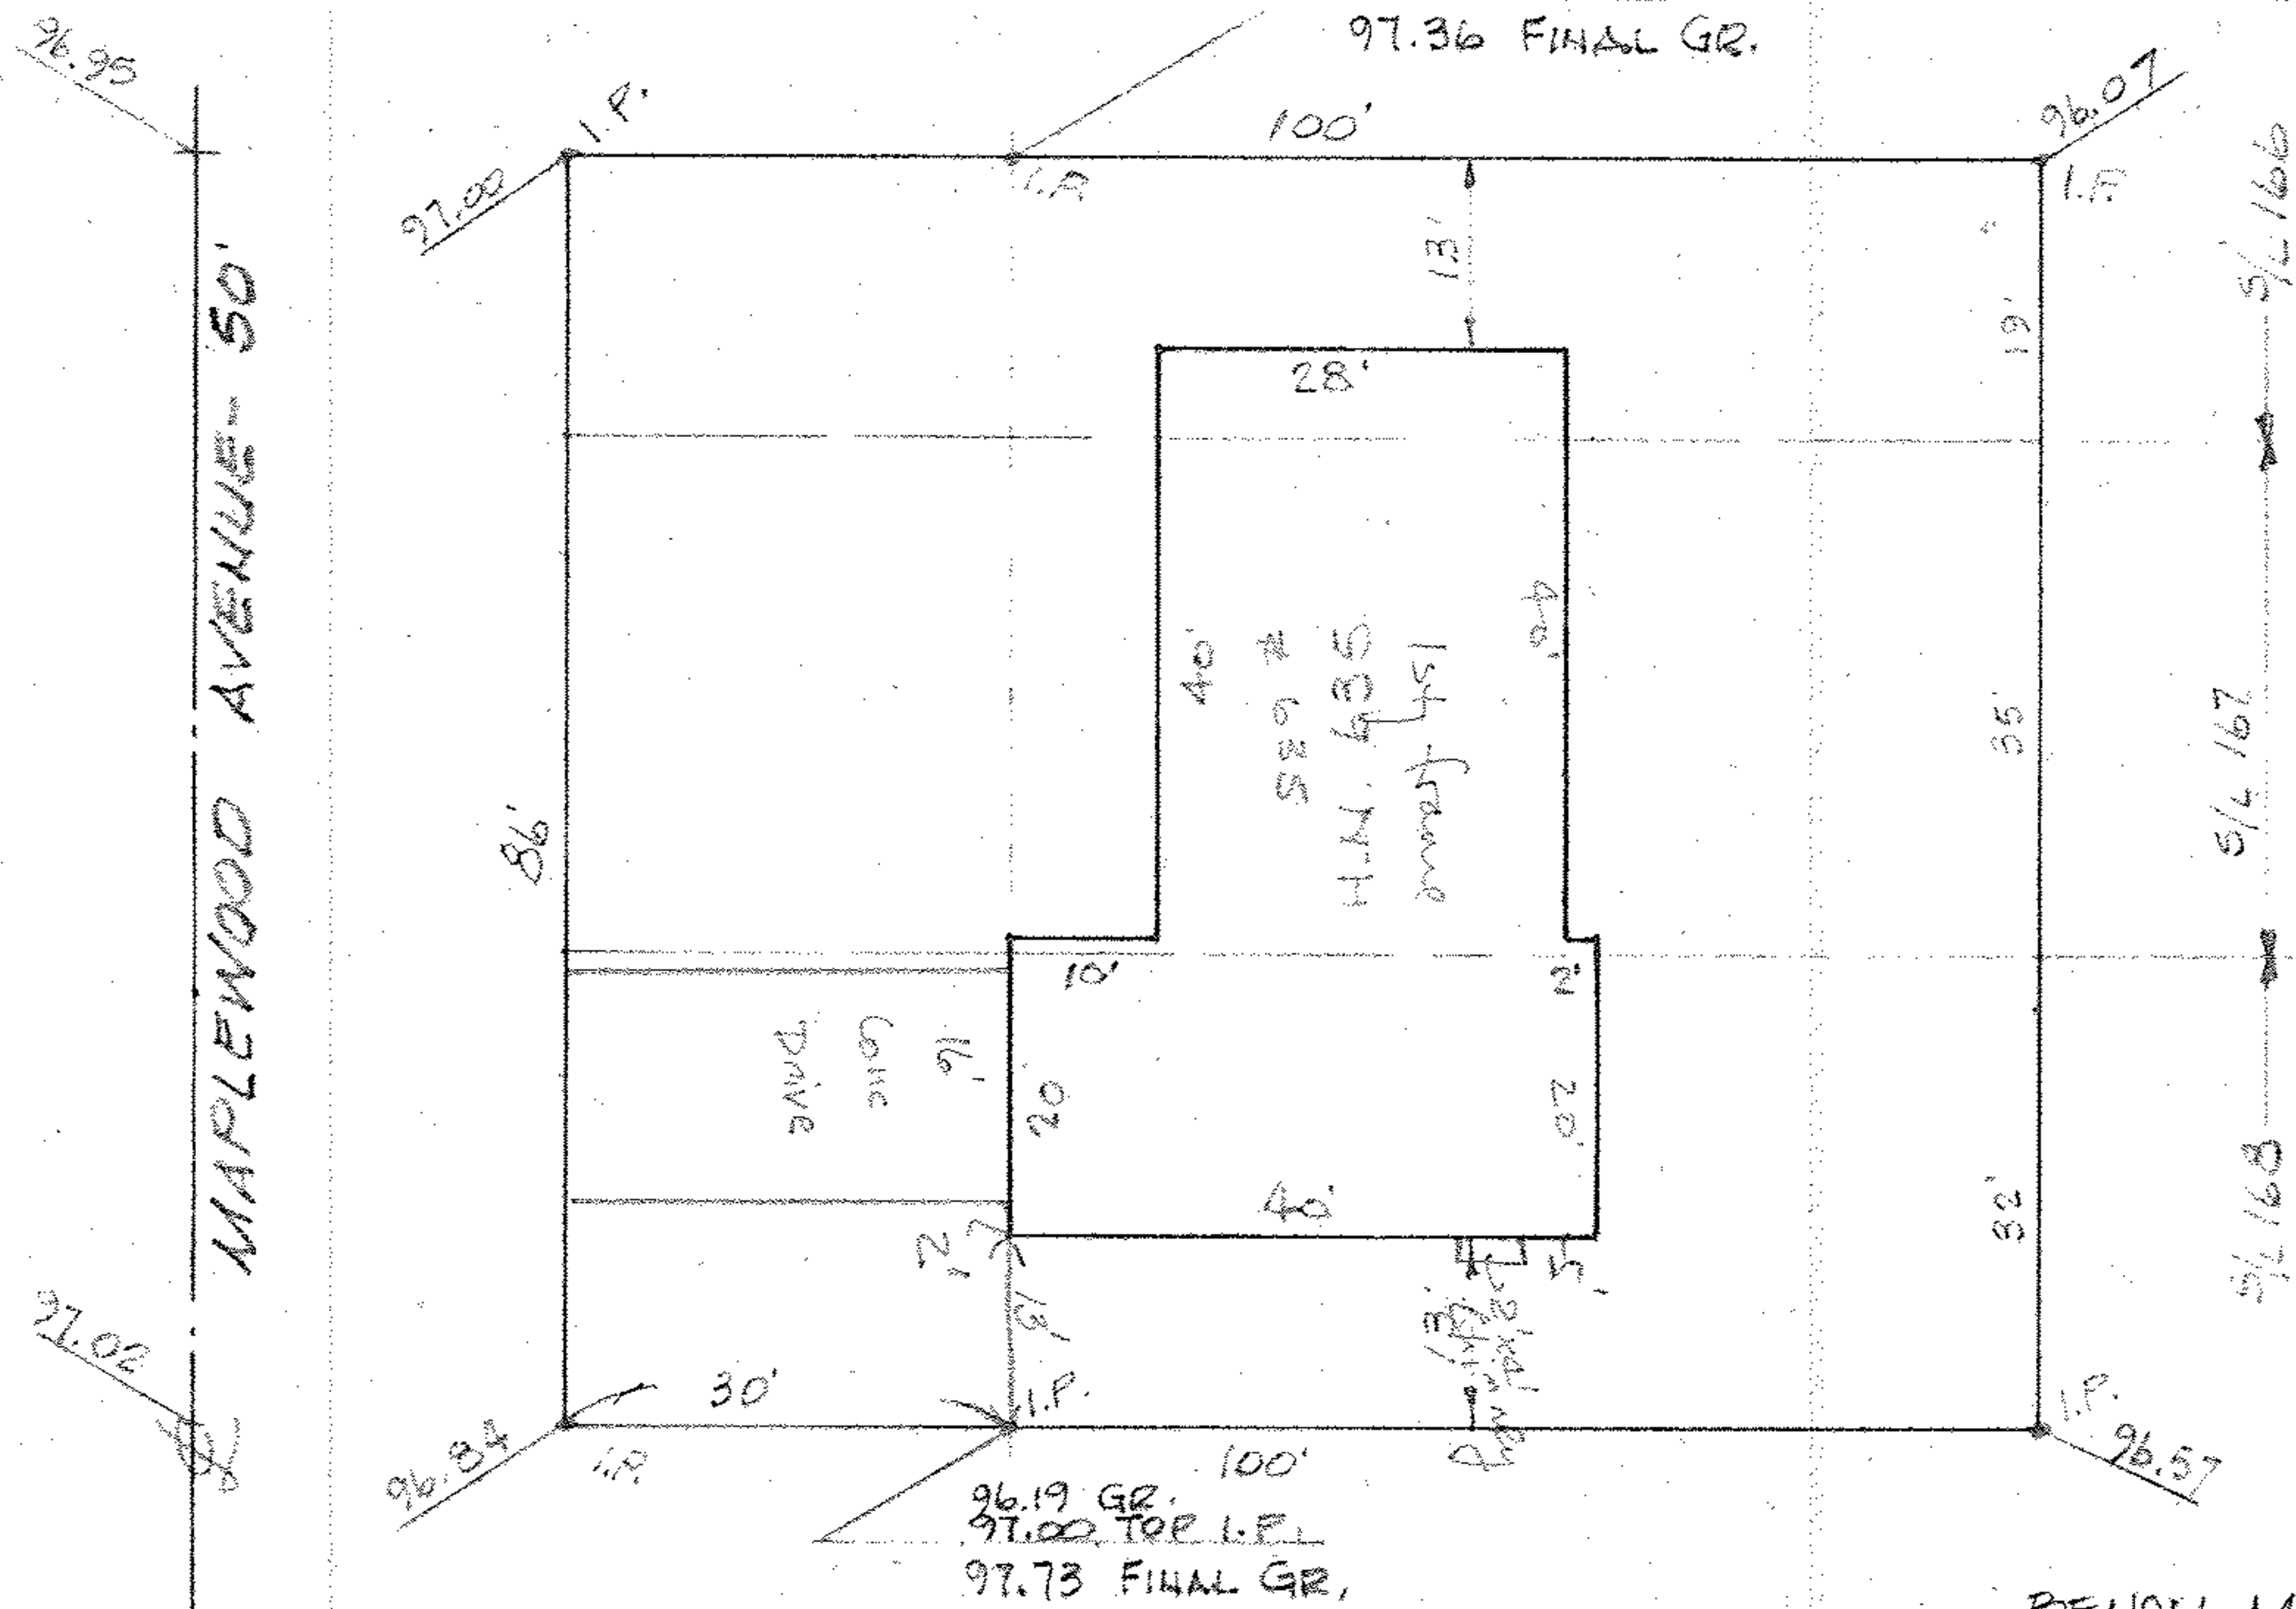

PLOT PLAN

PARTS OF SUBLOTS 166 & 168 AND ALL OF SUBLOT
 167 OF BLOCK "D" IN WEST SHORE SUB'D. - PLAT VOL 10, PG. 3
 CITY OF SHEFFIELD LAKE, LORAIN CO., OHIO

BENCH MARK:

"0" IN OPEN ON HYDRANT LOC.
 ON WEST SIDE OF MAPLEWOOD
 AVE. ELEV. = 100.00

McGLINCHY & ASSOCIATES INC.
 PROFESSIONAL ENGINEER & SURVEYORS
 ELYRIA OHIO
 AUGUST, 1979 #795687