
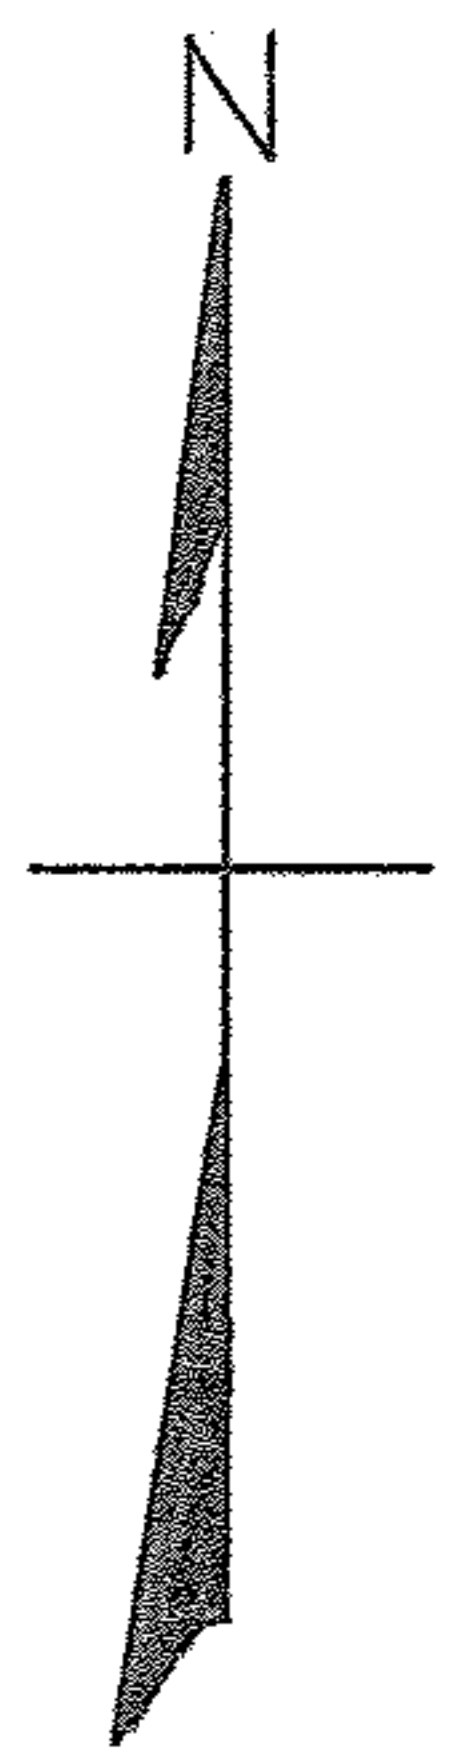


03-00-042-A
03-00-042-A
SWAN # 4526A

03-00-042-A

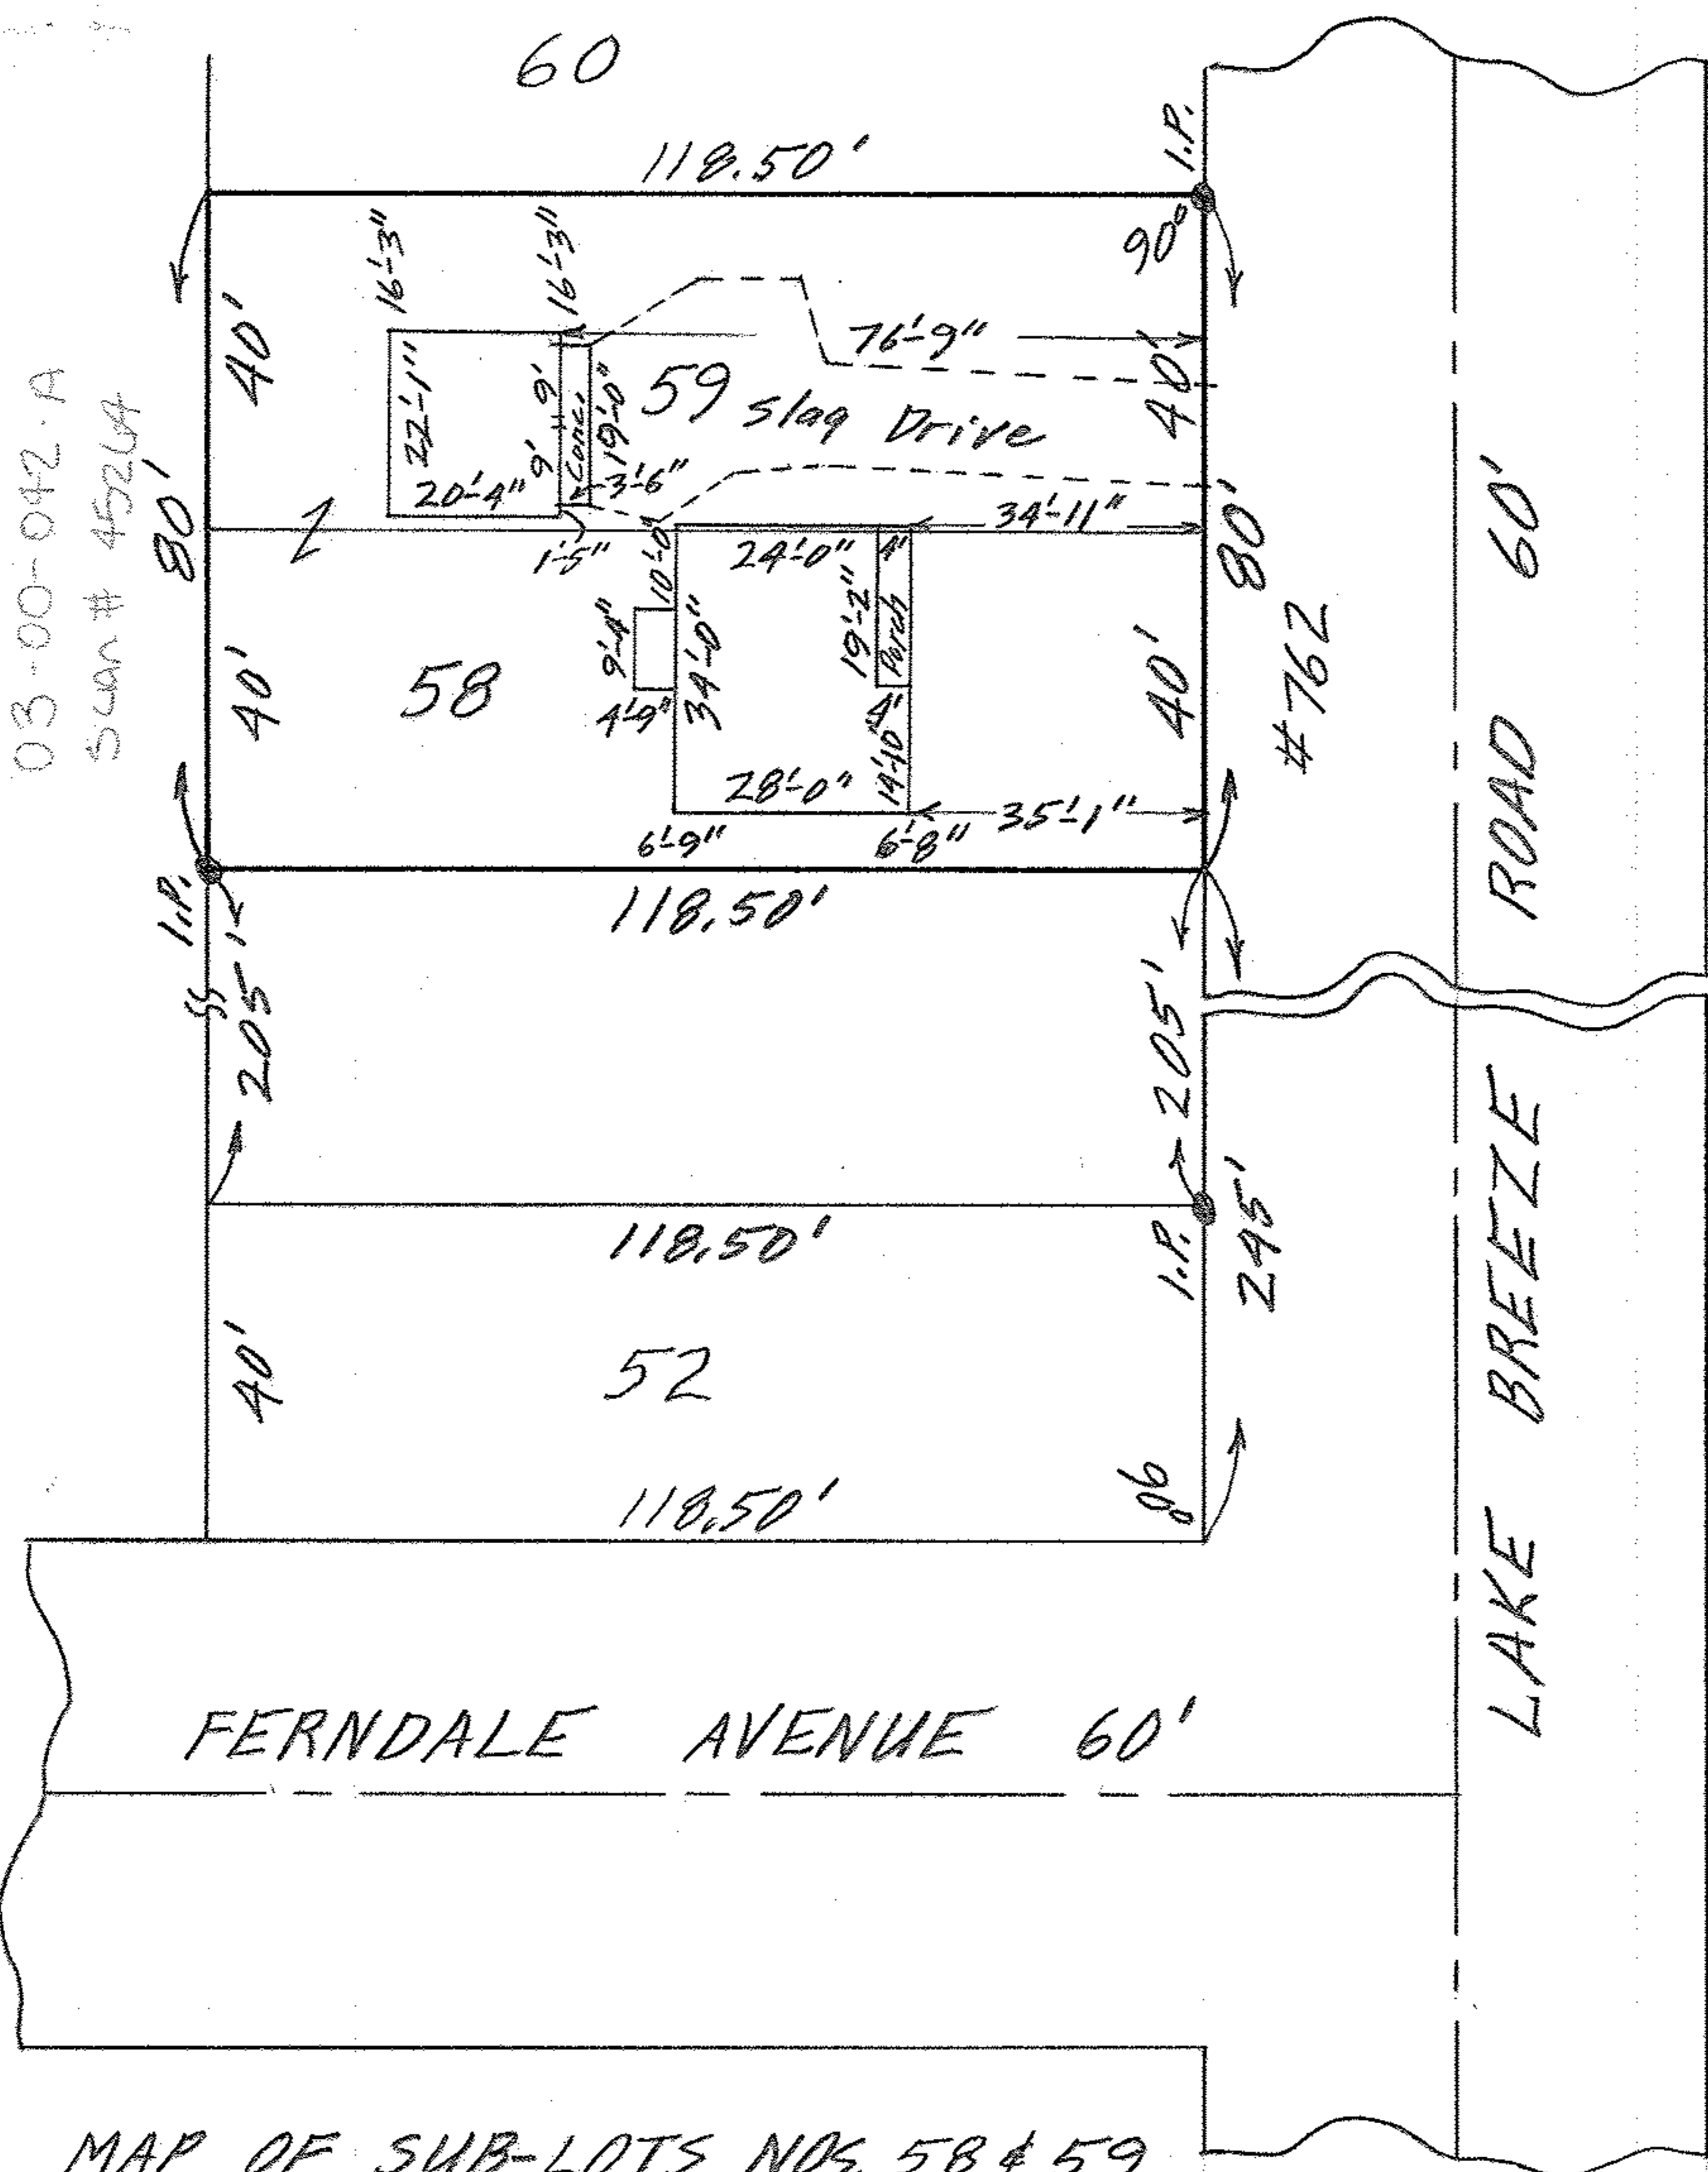

MAP OF SUB-LOTS NOS. 58 & 59
 LAKE BREEZE ALL'T. VOL. 10 Pg. 21
 SHEFFIELD LAKE CITY
 LORAIN COUNTY OHIO
 SCALE: 1"=30' JULY 3-1965 11:40 A.M.
 Gary E. Penfound REG. SURVEYOR
 Robert J. & Catherine Martin