


03-00-046-102-009

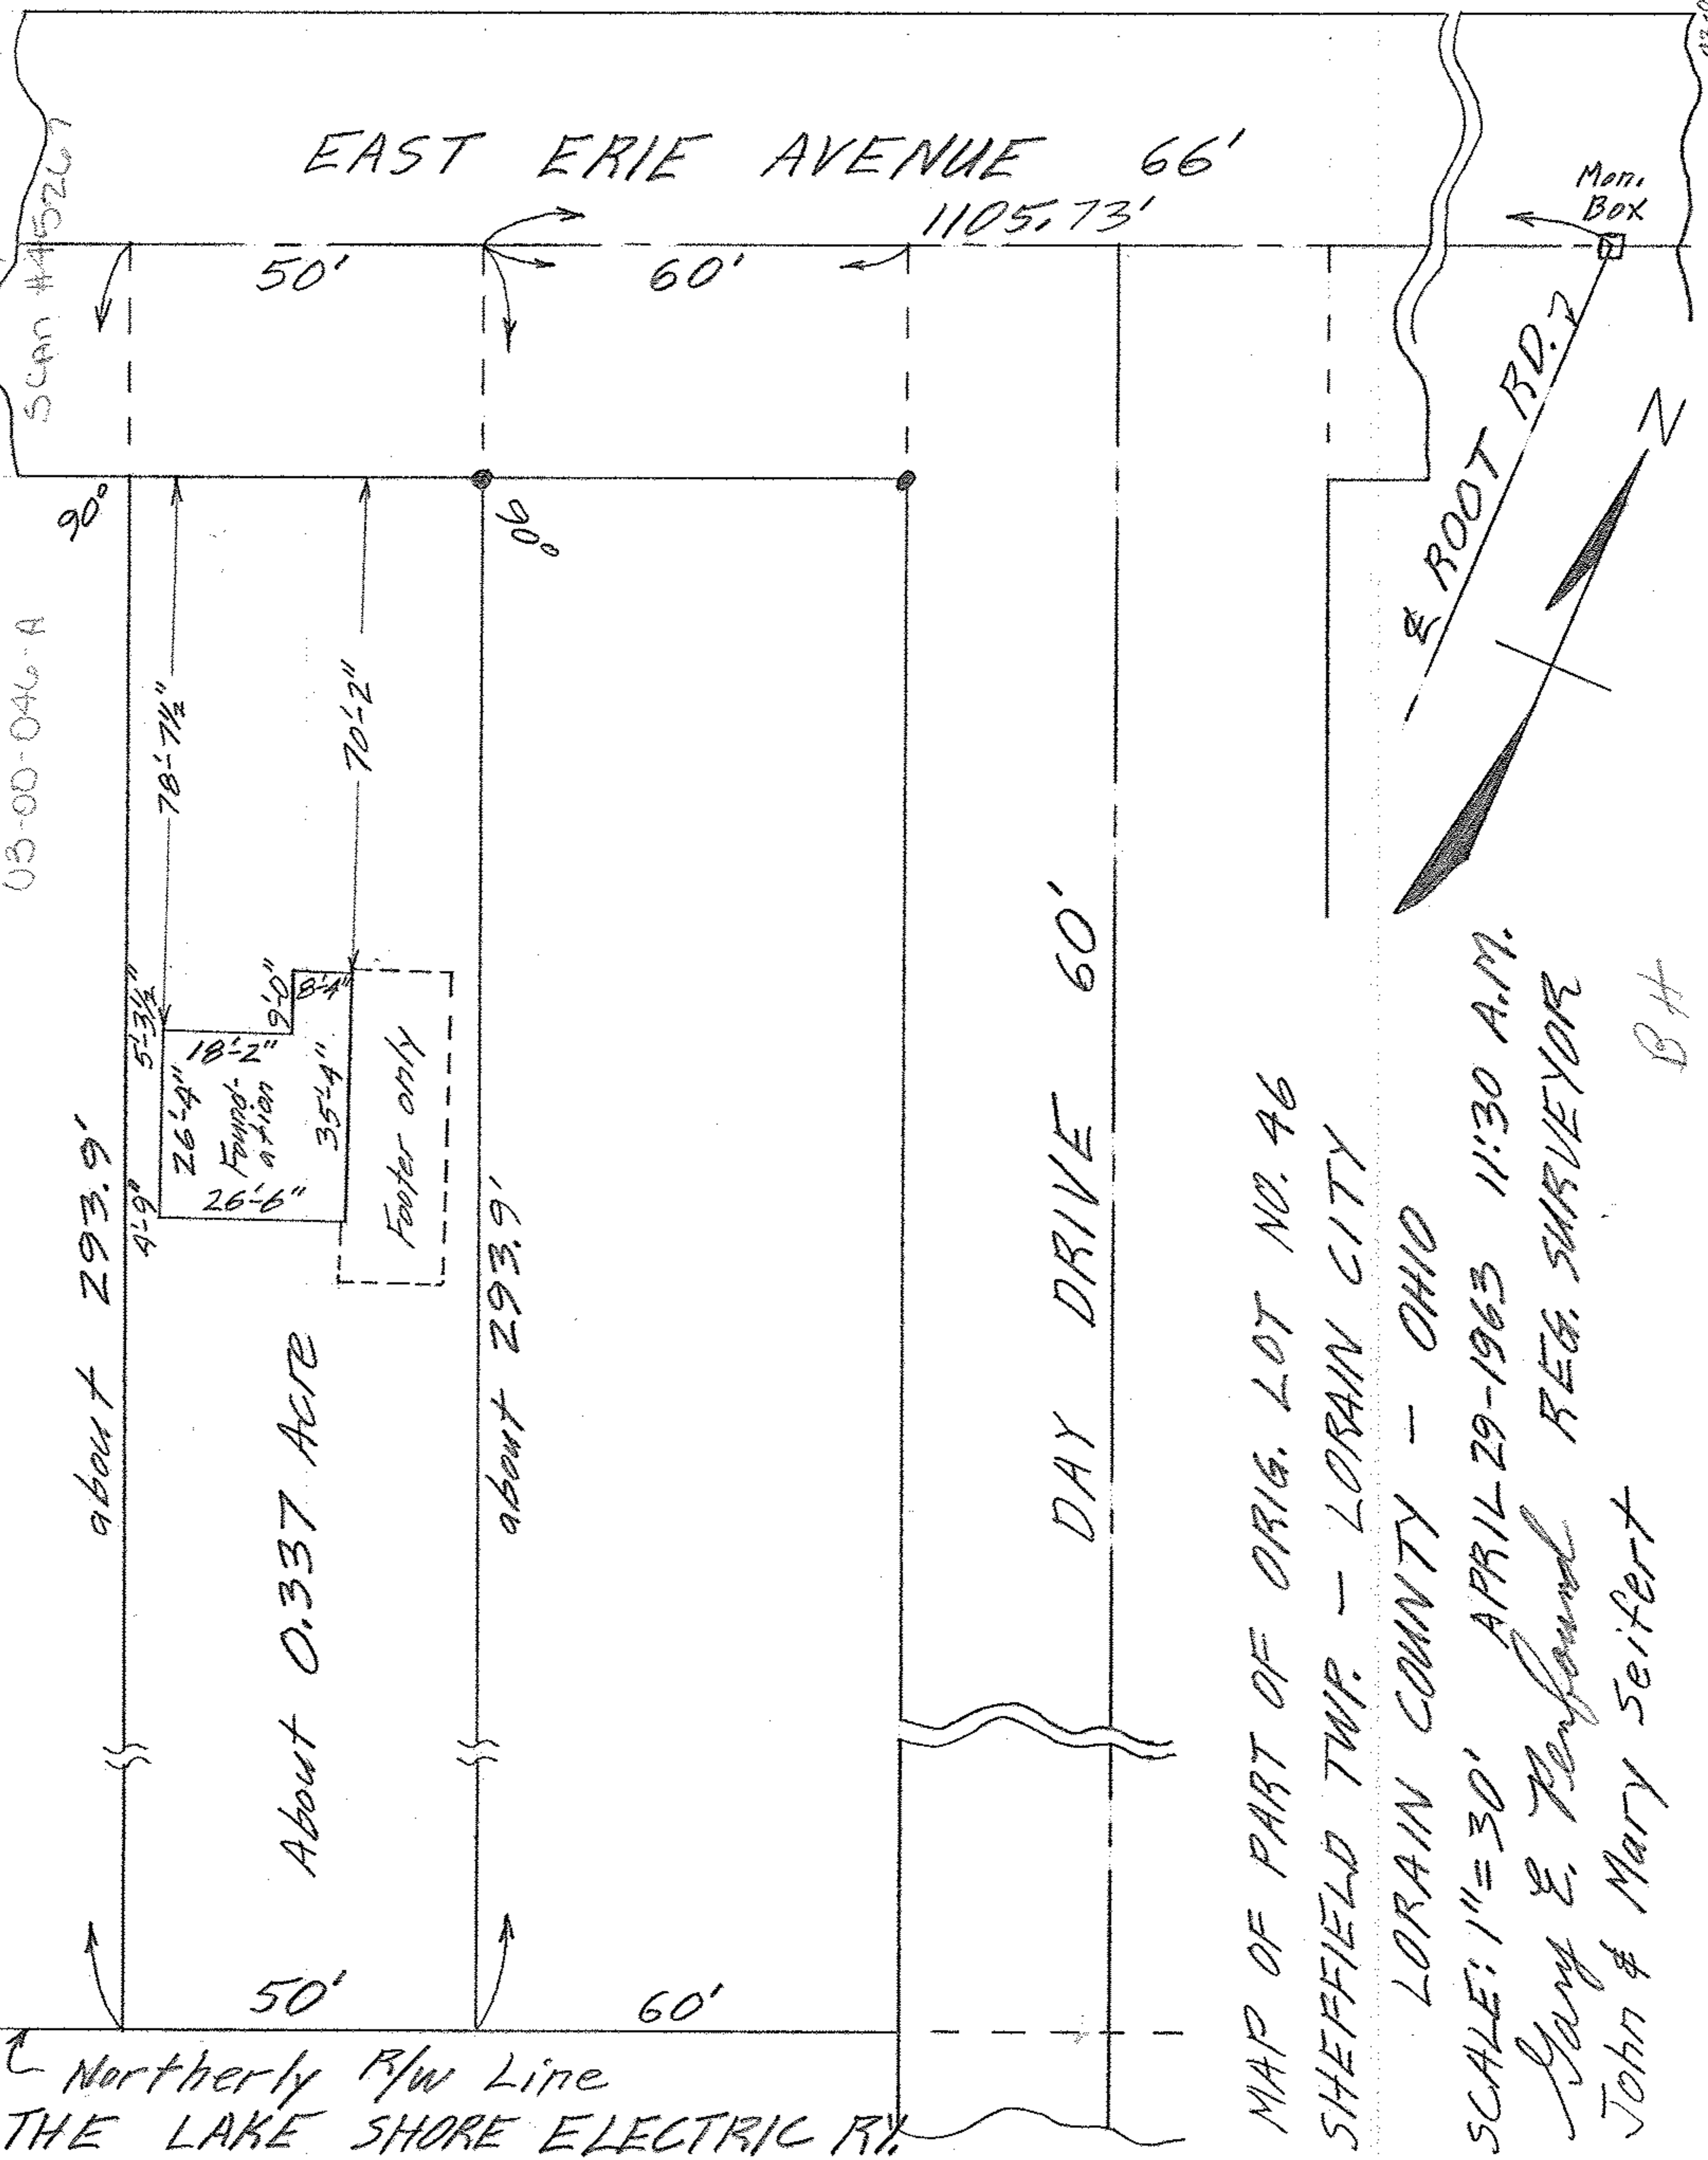

← Northerly R/W Line  
 THE LAKE SHORE ELECTRIC RY.

03-00-046-A

about 293.9'

About 0.337 Acre

about 293.9'

DAY DRIVE 60'

EAST ERIE AVENUE 66'

1105.73'

Mem. Box

E FOOT B.D. 2

BH

MAP OF PART OF ORIG. LOT NO. 46  
 SHEFFIELD TWP. - LORAIN CITY

LORAIN COUNTY - OHIO  
 SCALE: 1"=30' APRIL 29-1963 11:30 A.M.  
 Gary E. Penfound REG. SURVEYOR  
 John & Mary Seifert

03-00-046