


03-00-046-113-003  
03-00-046B

Scan # 45270

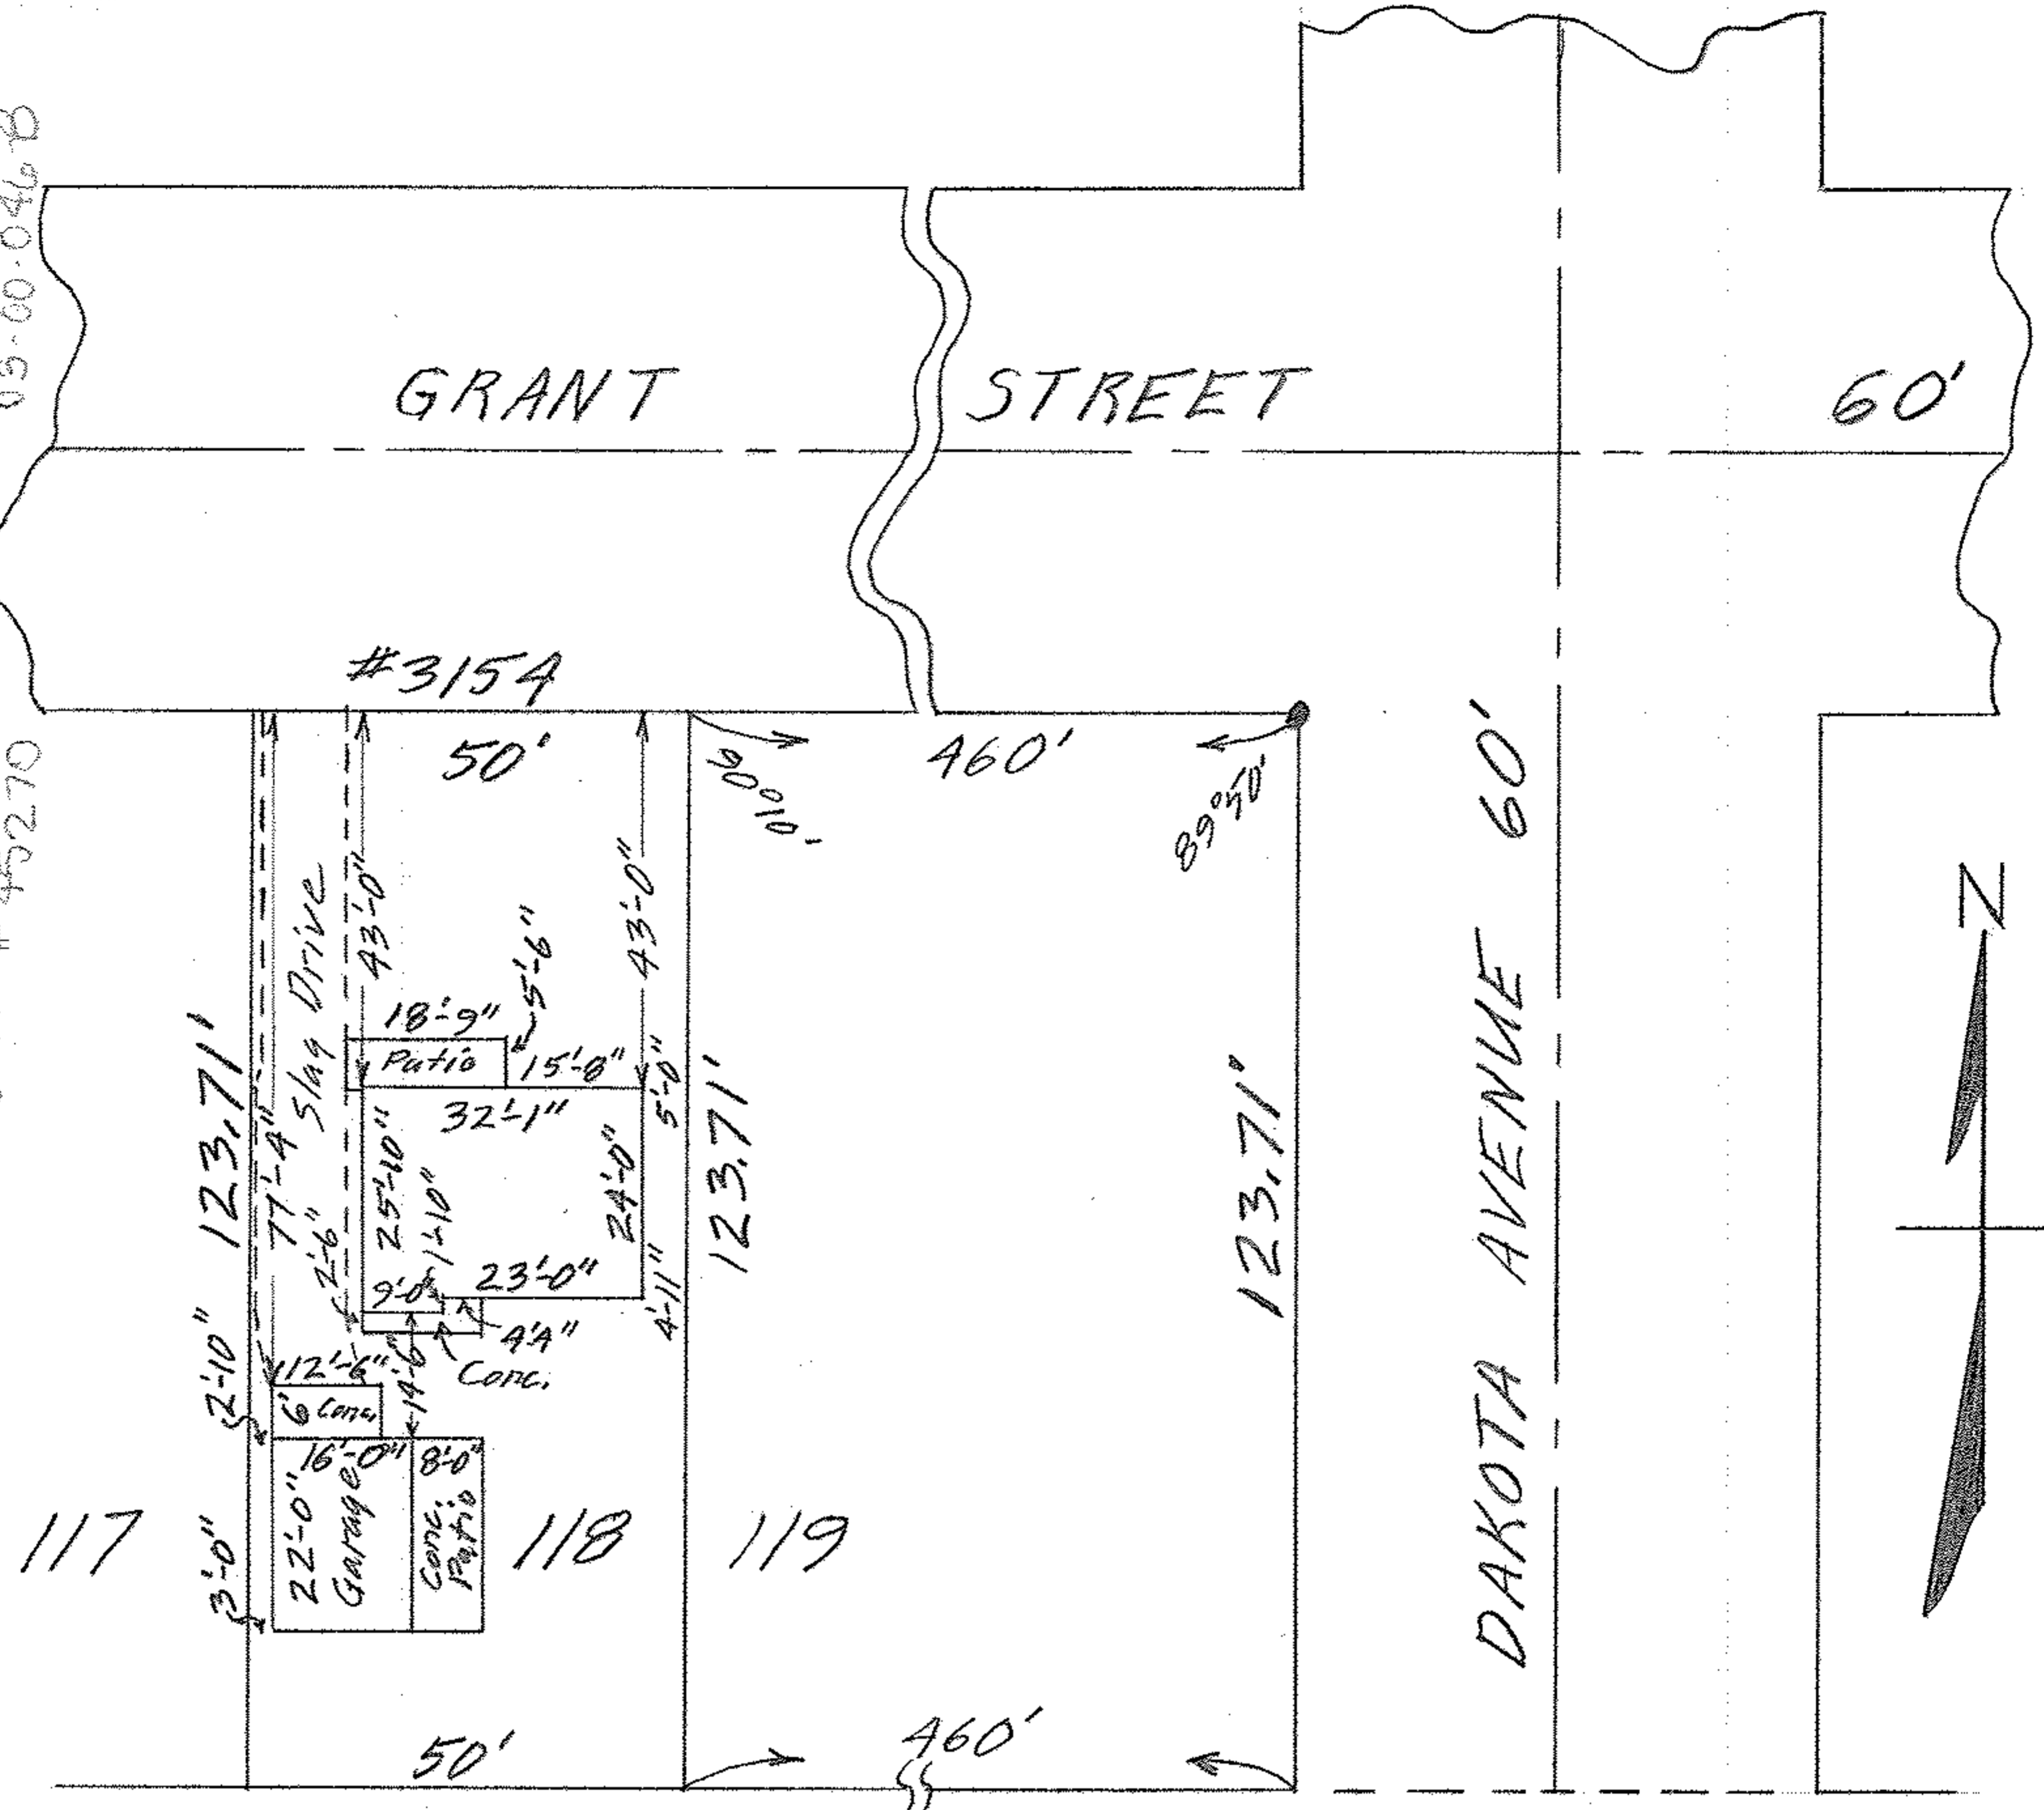

MAP OF SUB-LOT NO. 118

PEASEDALE ALL'T. Vol. 15 Pg. 69 PLATS  
ORIG. LOT 46 SHEFFIELD TOWNSHIP  
LORAIN CITY - LORAIN COUNTY - OHIO

SCALE: 1"=30' APRIL 6-1963 11:00 A.M.

Gary E. Penfound REG. SURVEYOR

Judd M. & Rita C. Moore

BH