


03-00-046-118-00-3

03-00-046-3  
SCN # 45273

0300-046

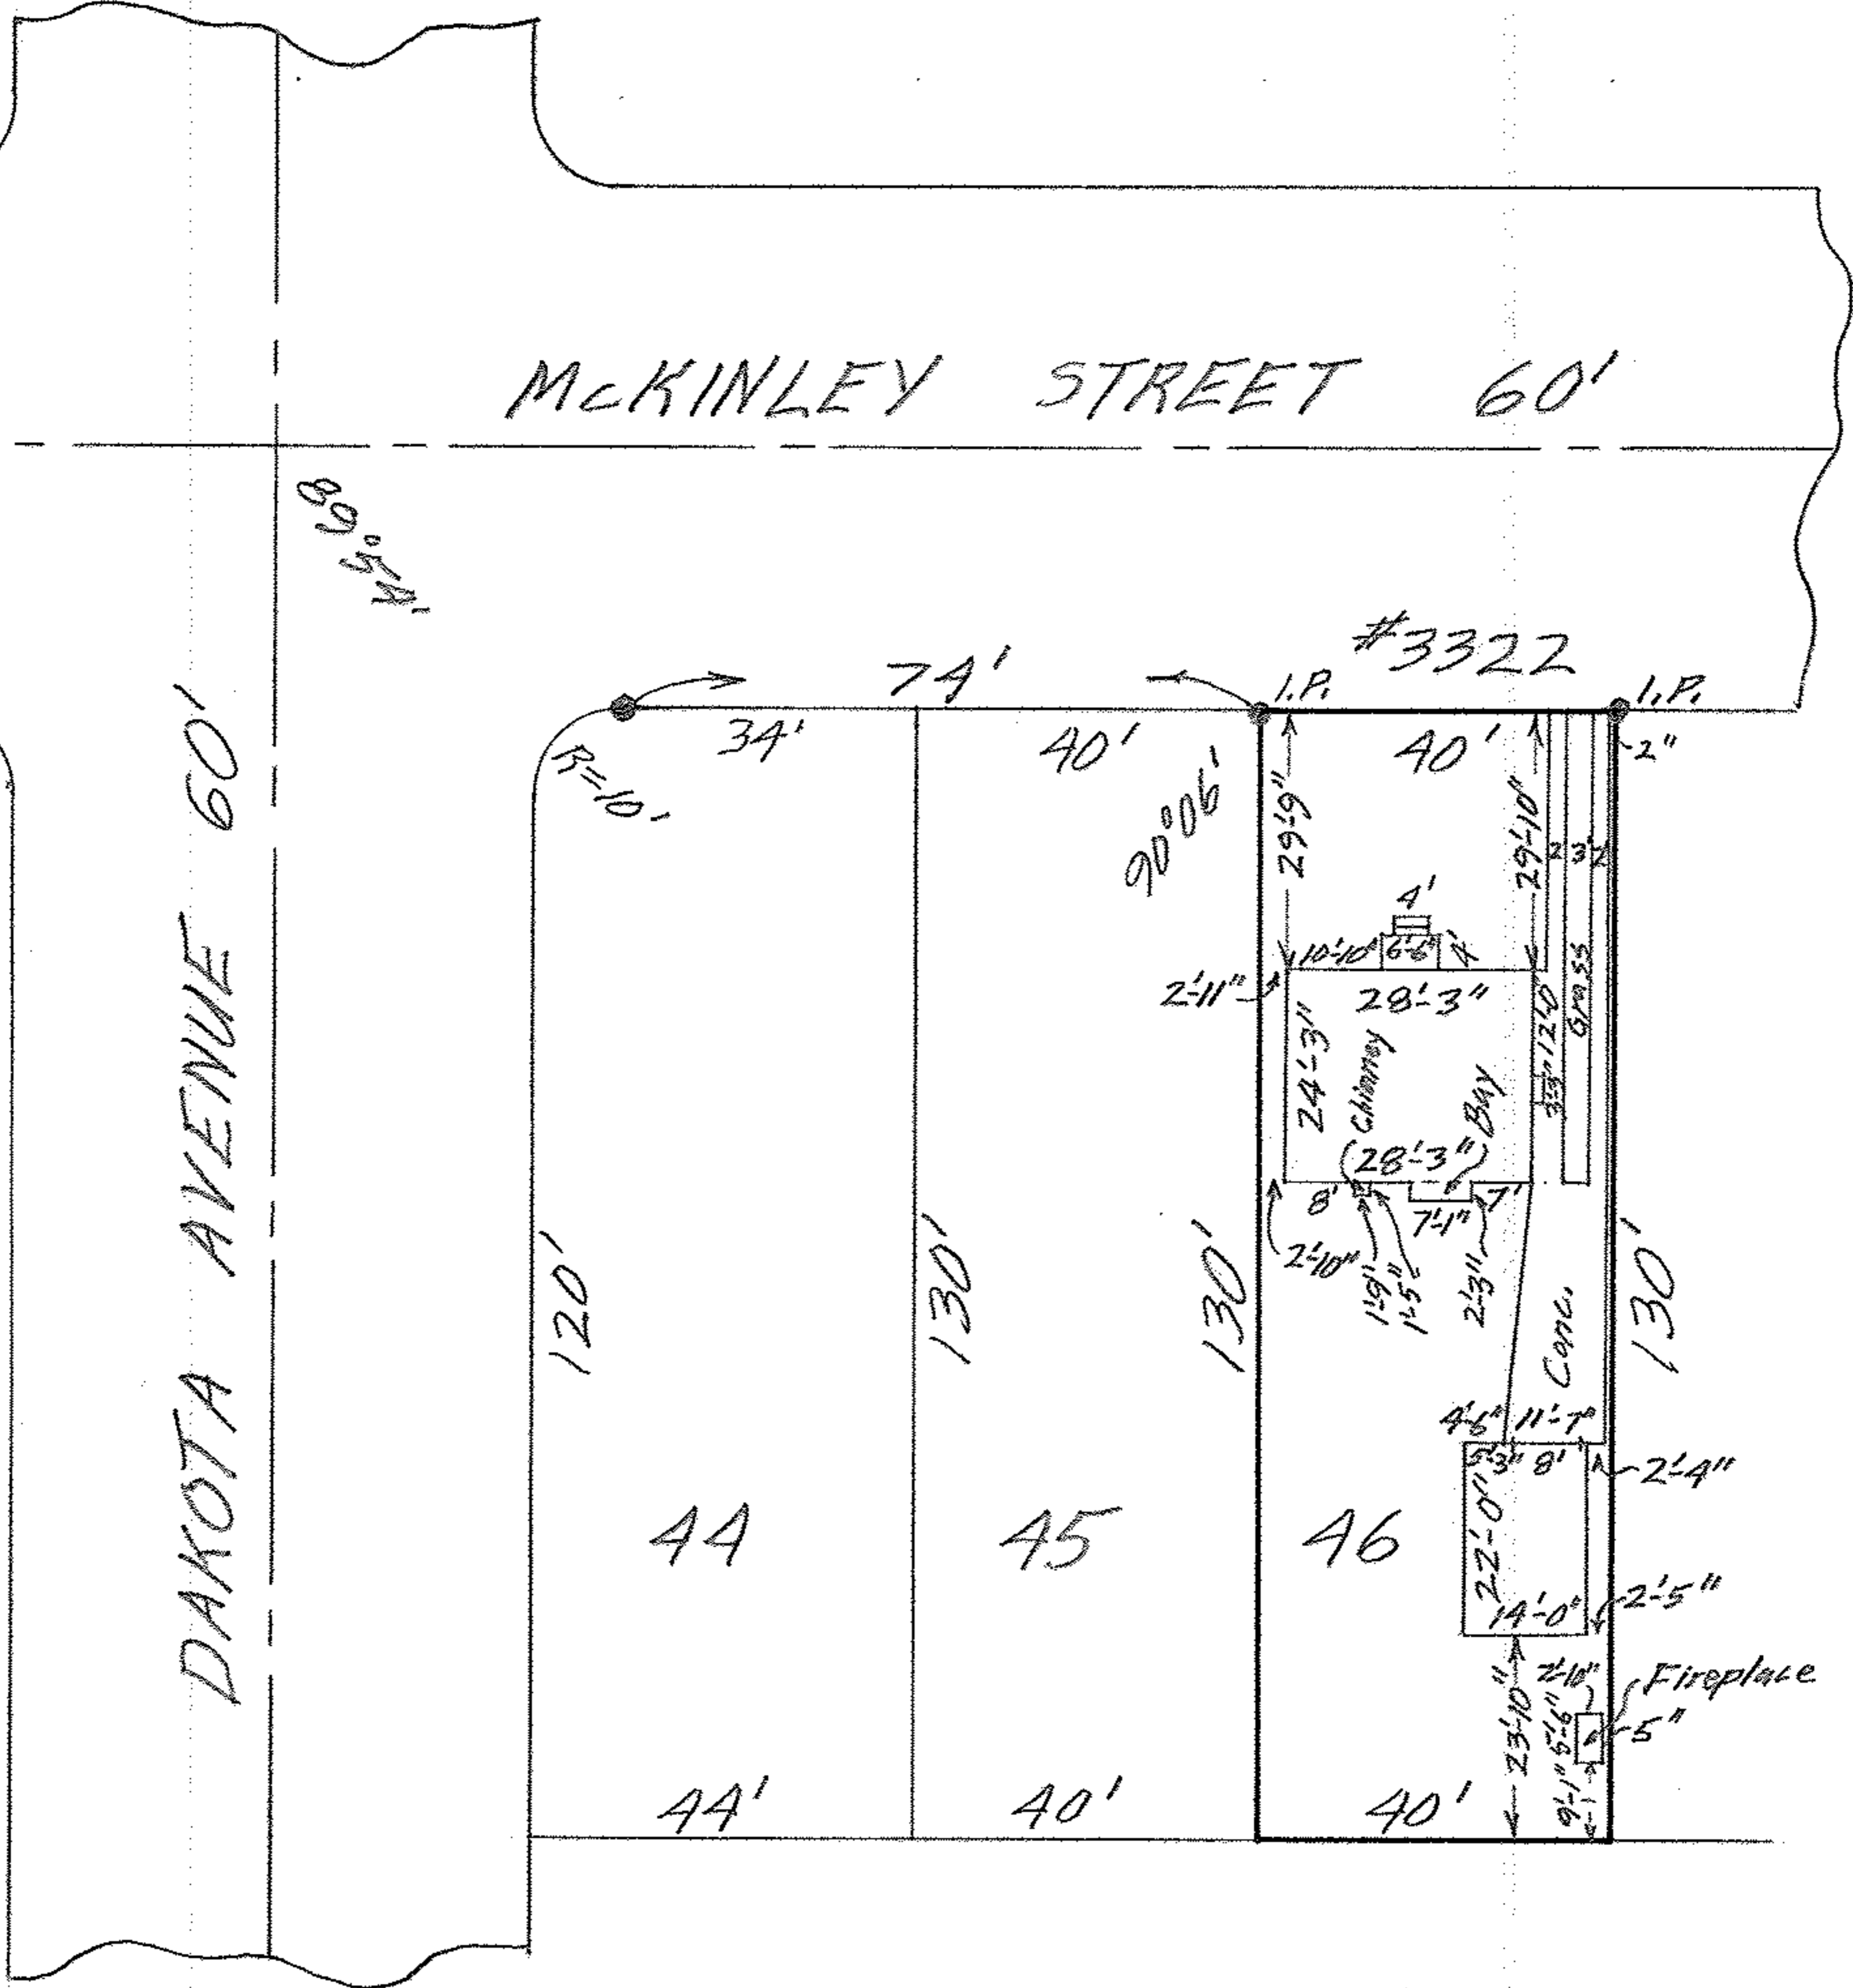

MAP OF SUB-LOT NO. 46  
 EASTHAVEN SUB'N. VOL. 9 P. 4 PLATS  
 ORIG. LOT NO. 46 SHEFFIELD TWP.  
 LORAIN CITY - LORAIN COUNTY - OHIO  
 SCALE: 1" = 30' AUG. 5-1965 11:00 A.M.  
 Mary E. Penfound REG. SURVEYOR

OHIO BAR TITLE INSURANCE CO.  
 Milton Friedman, Agent  
 Order No. 1223 Daisy Lazevich