


03-00-047-118-018

03-00-047-10

SCAN # 45270

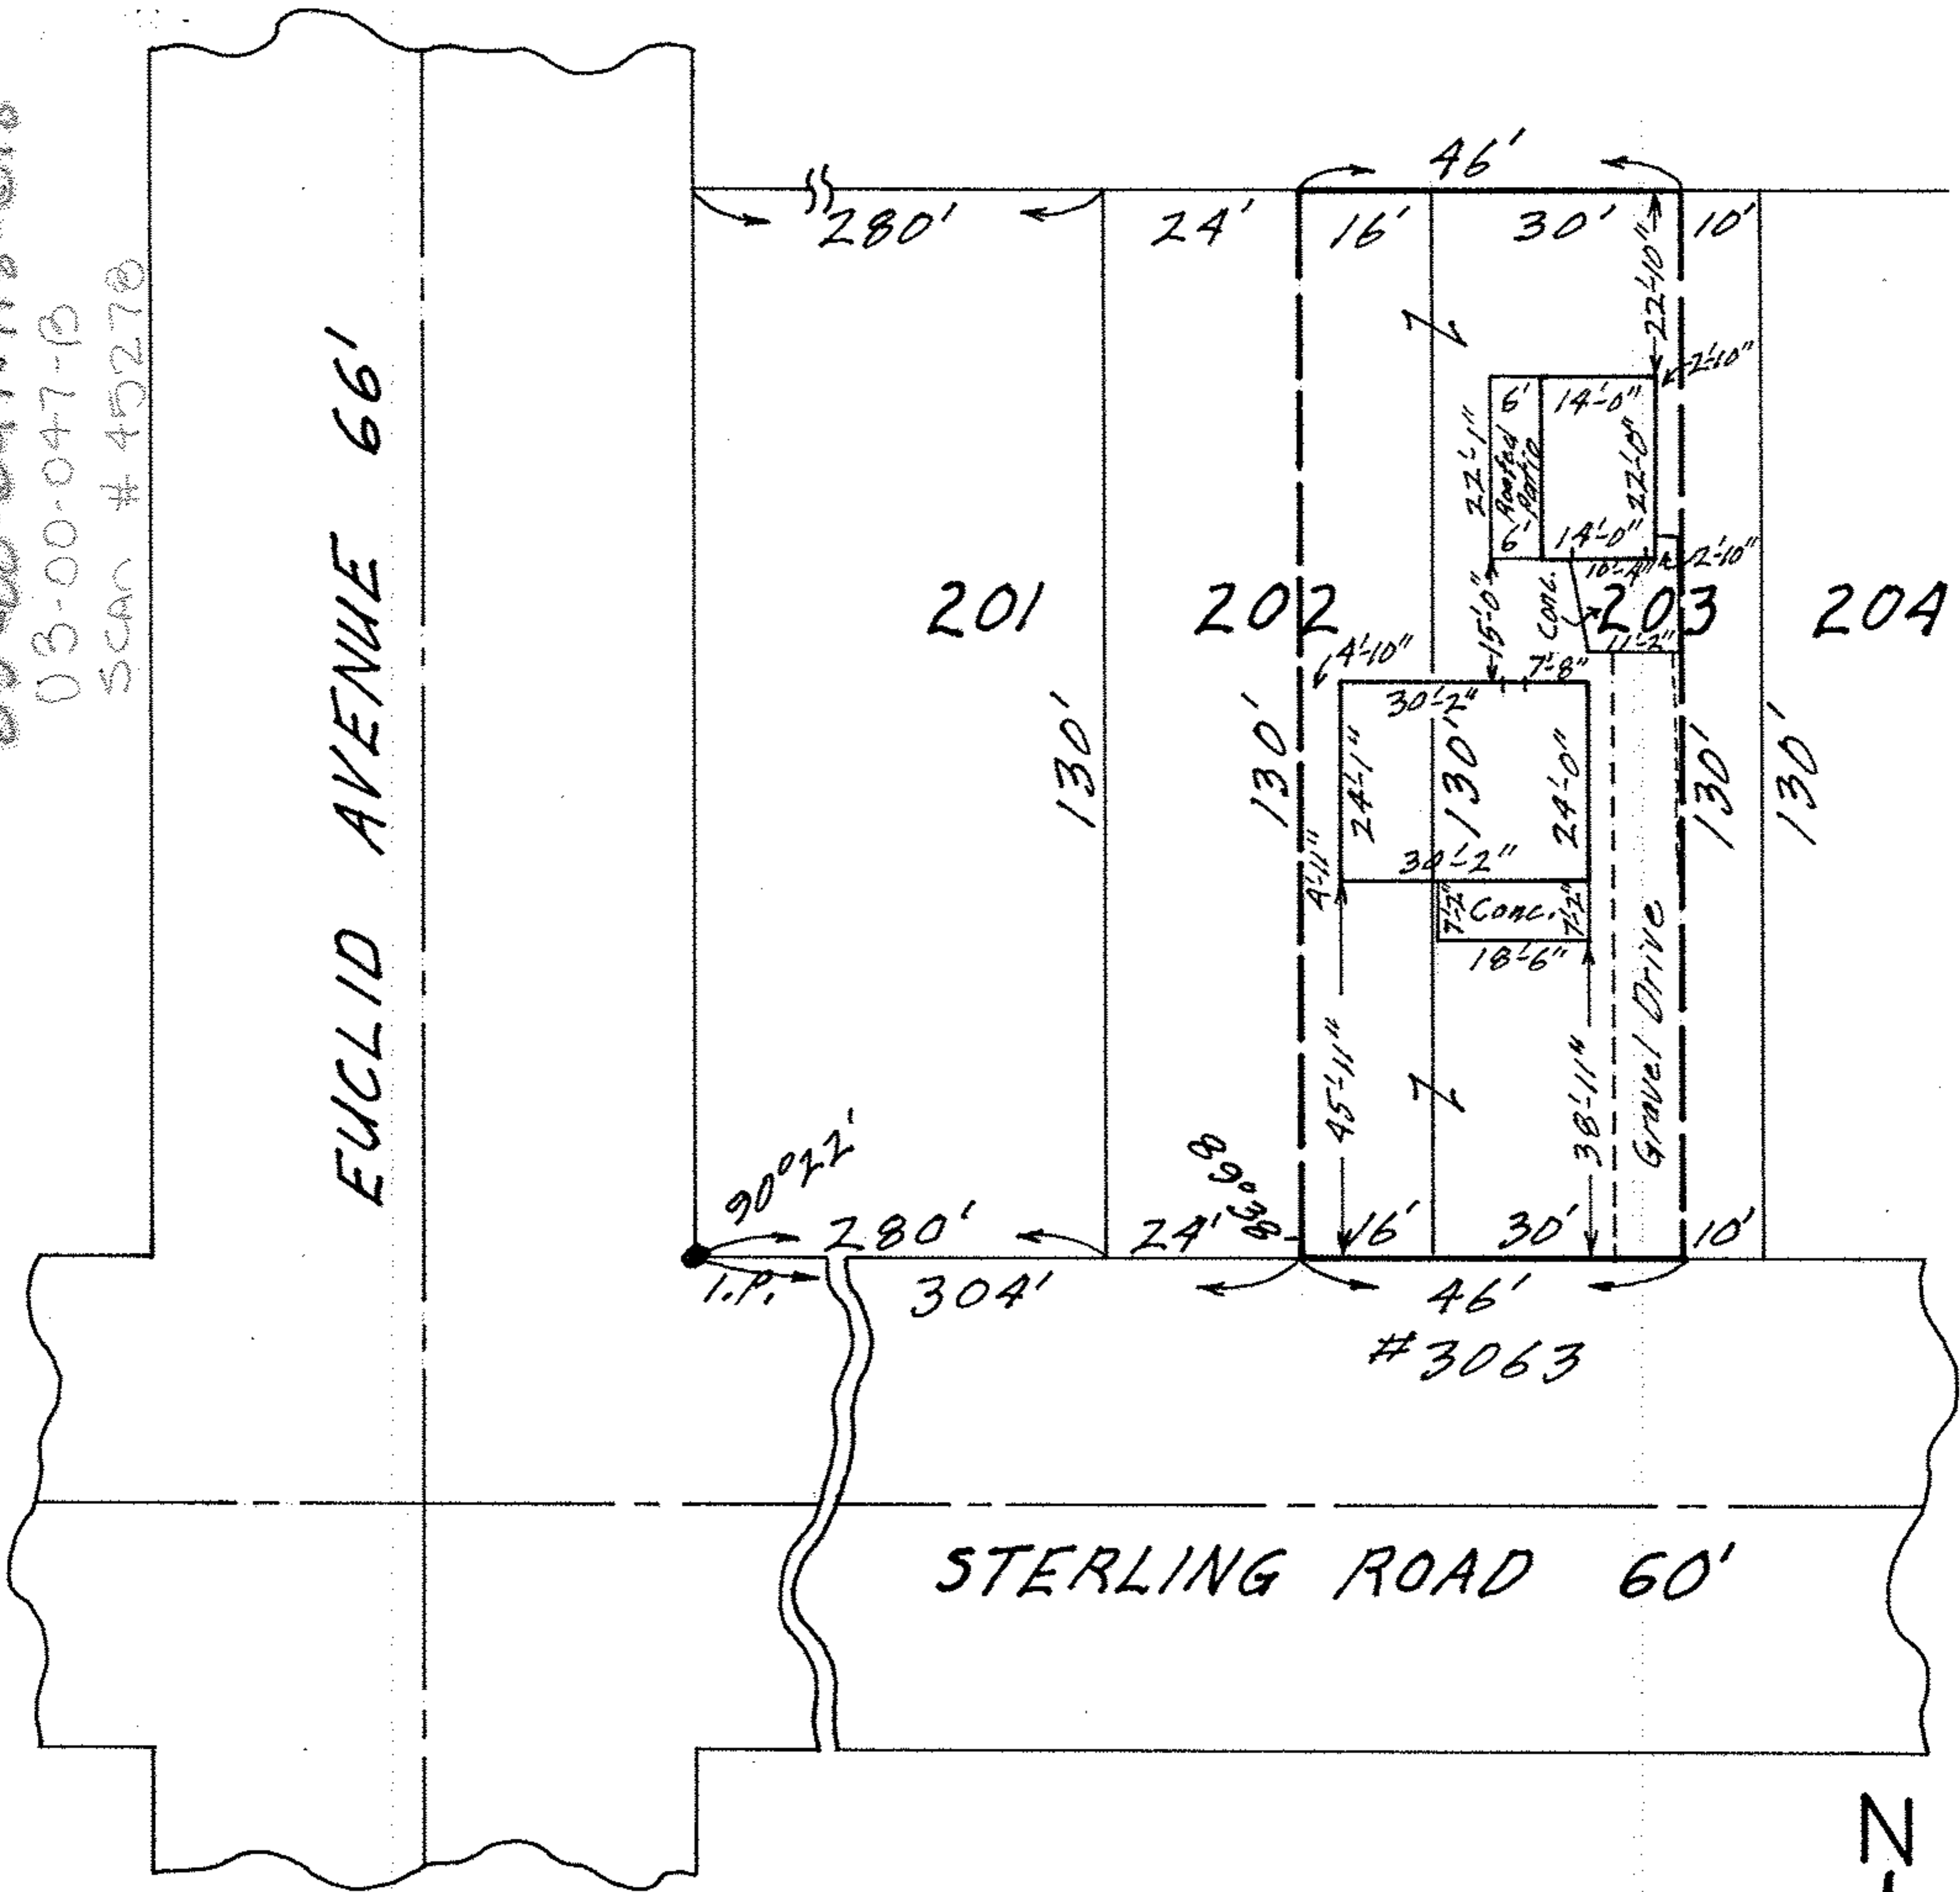

MAP OF THE EASTERLY 16 FEET OF SUB-LOT  
 NO. 202 AND WESTERLY 30 FEET OF SUB-LOT NO. 203  
 EASTHAVEN SUB'N. NO. 2 VOL. 13 PG. 32  
 O.L. 47 SHEFFIELD TWP. - LORAIN CITY  
 LORAIN COUNTY OHIO

SCALE: 1" = 30' MAY 17-1968 8:15 P.M.  
 Gary E. Penfound REG. SURVEYOR

Order No. 1780 David & Deborah Solomon

03-00-047 MF