


03-00-048-104-004
 03-00-048
 SCAN # 45280

MISSOURI AVENUE 60'

Easement to Ohio Public Service Co. and Lorain Telephone Co.

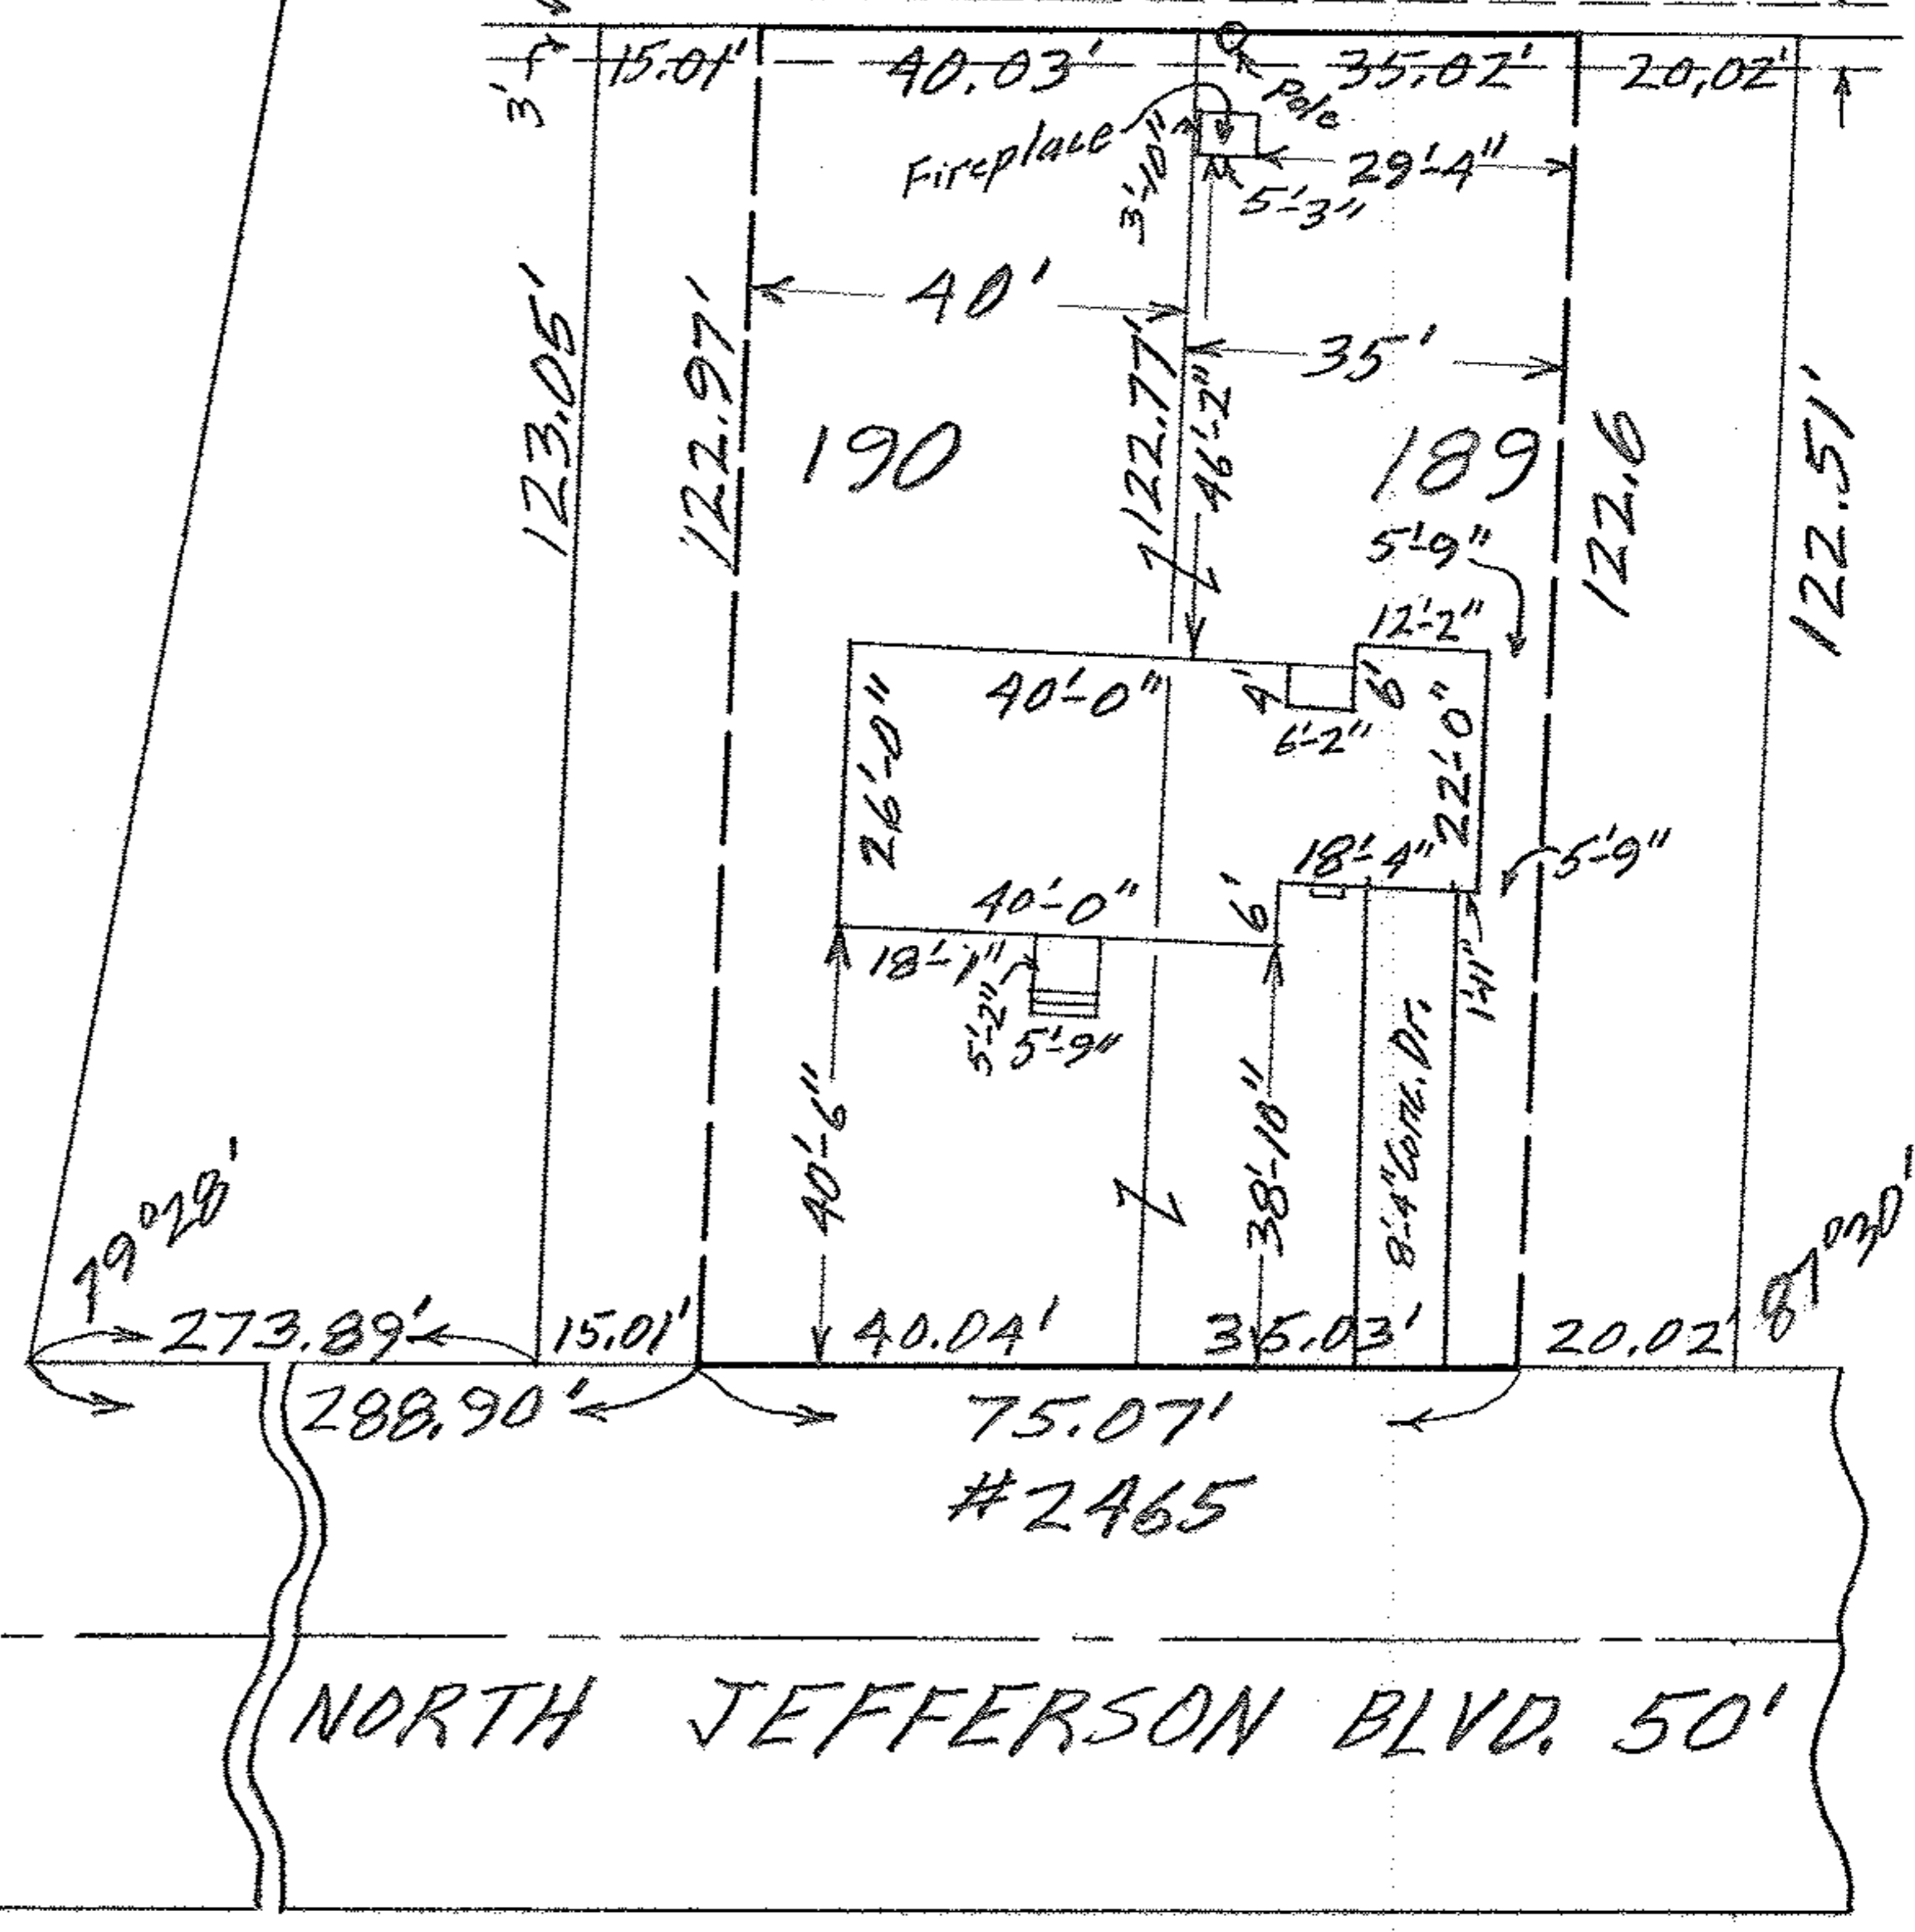

MAP OF EASTERLY 40 FEET OF SUB-LOT
 NO. 190 AND WESTERLY 35 FEET OF SUB-LOT
 NO. 189 IN HOY-LO-MAE ALL'T., SECOND ADD'N.
 VOL. 14 PG. 12 PLATS
 ORIG. LOTS 48 & 49 SHEFFIELD TWP.
 LORAIN CITY - LORAIN COUNTY - OHIO
 SCALE: 1"=30' MAY 20-1965 12:30 P.M.
 Gary E. Penfound REG. SURVEYOR

Rollin R. & Mary W. Bishop

BH

03-00-049