
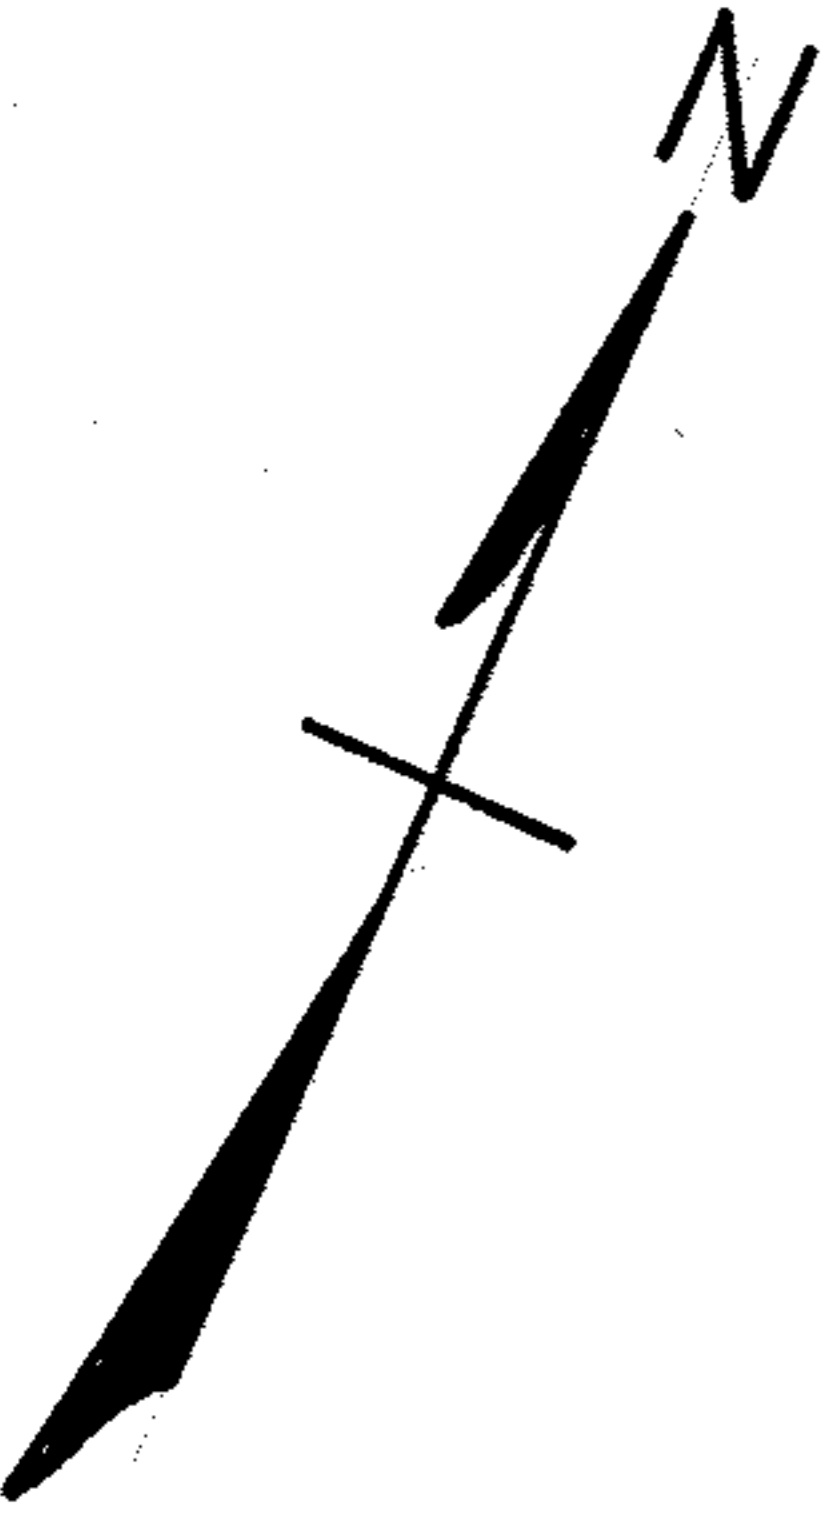


03-00-048-104-011  
 03-00-048  
 SCAN # 45281

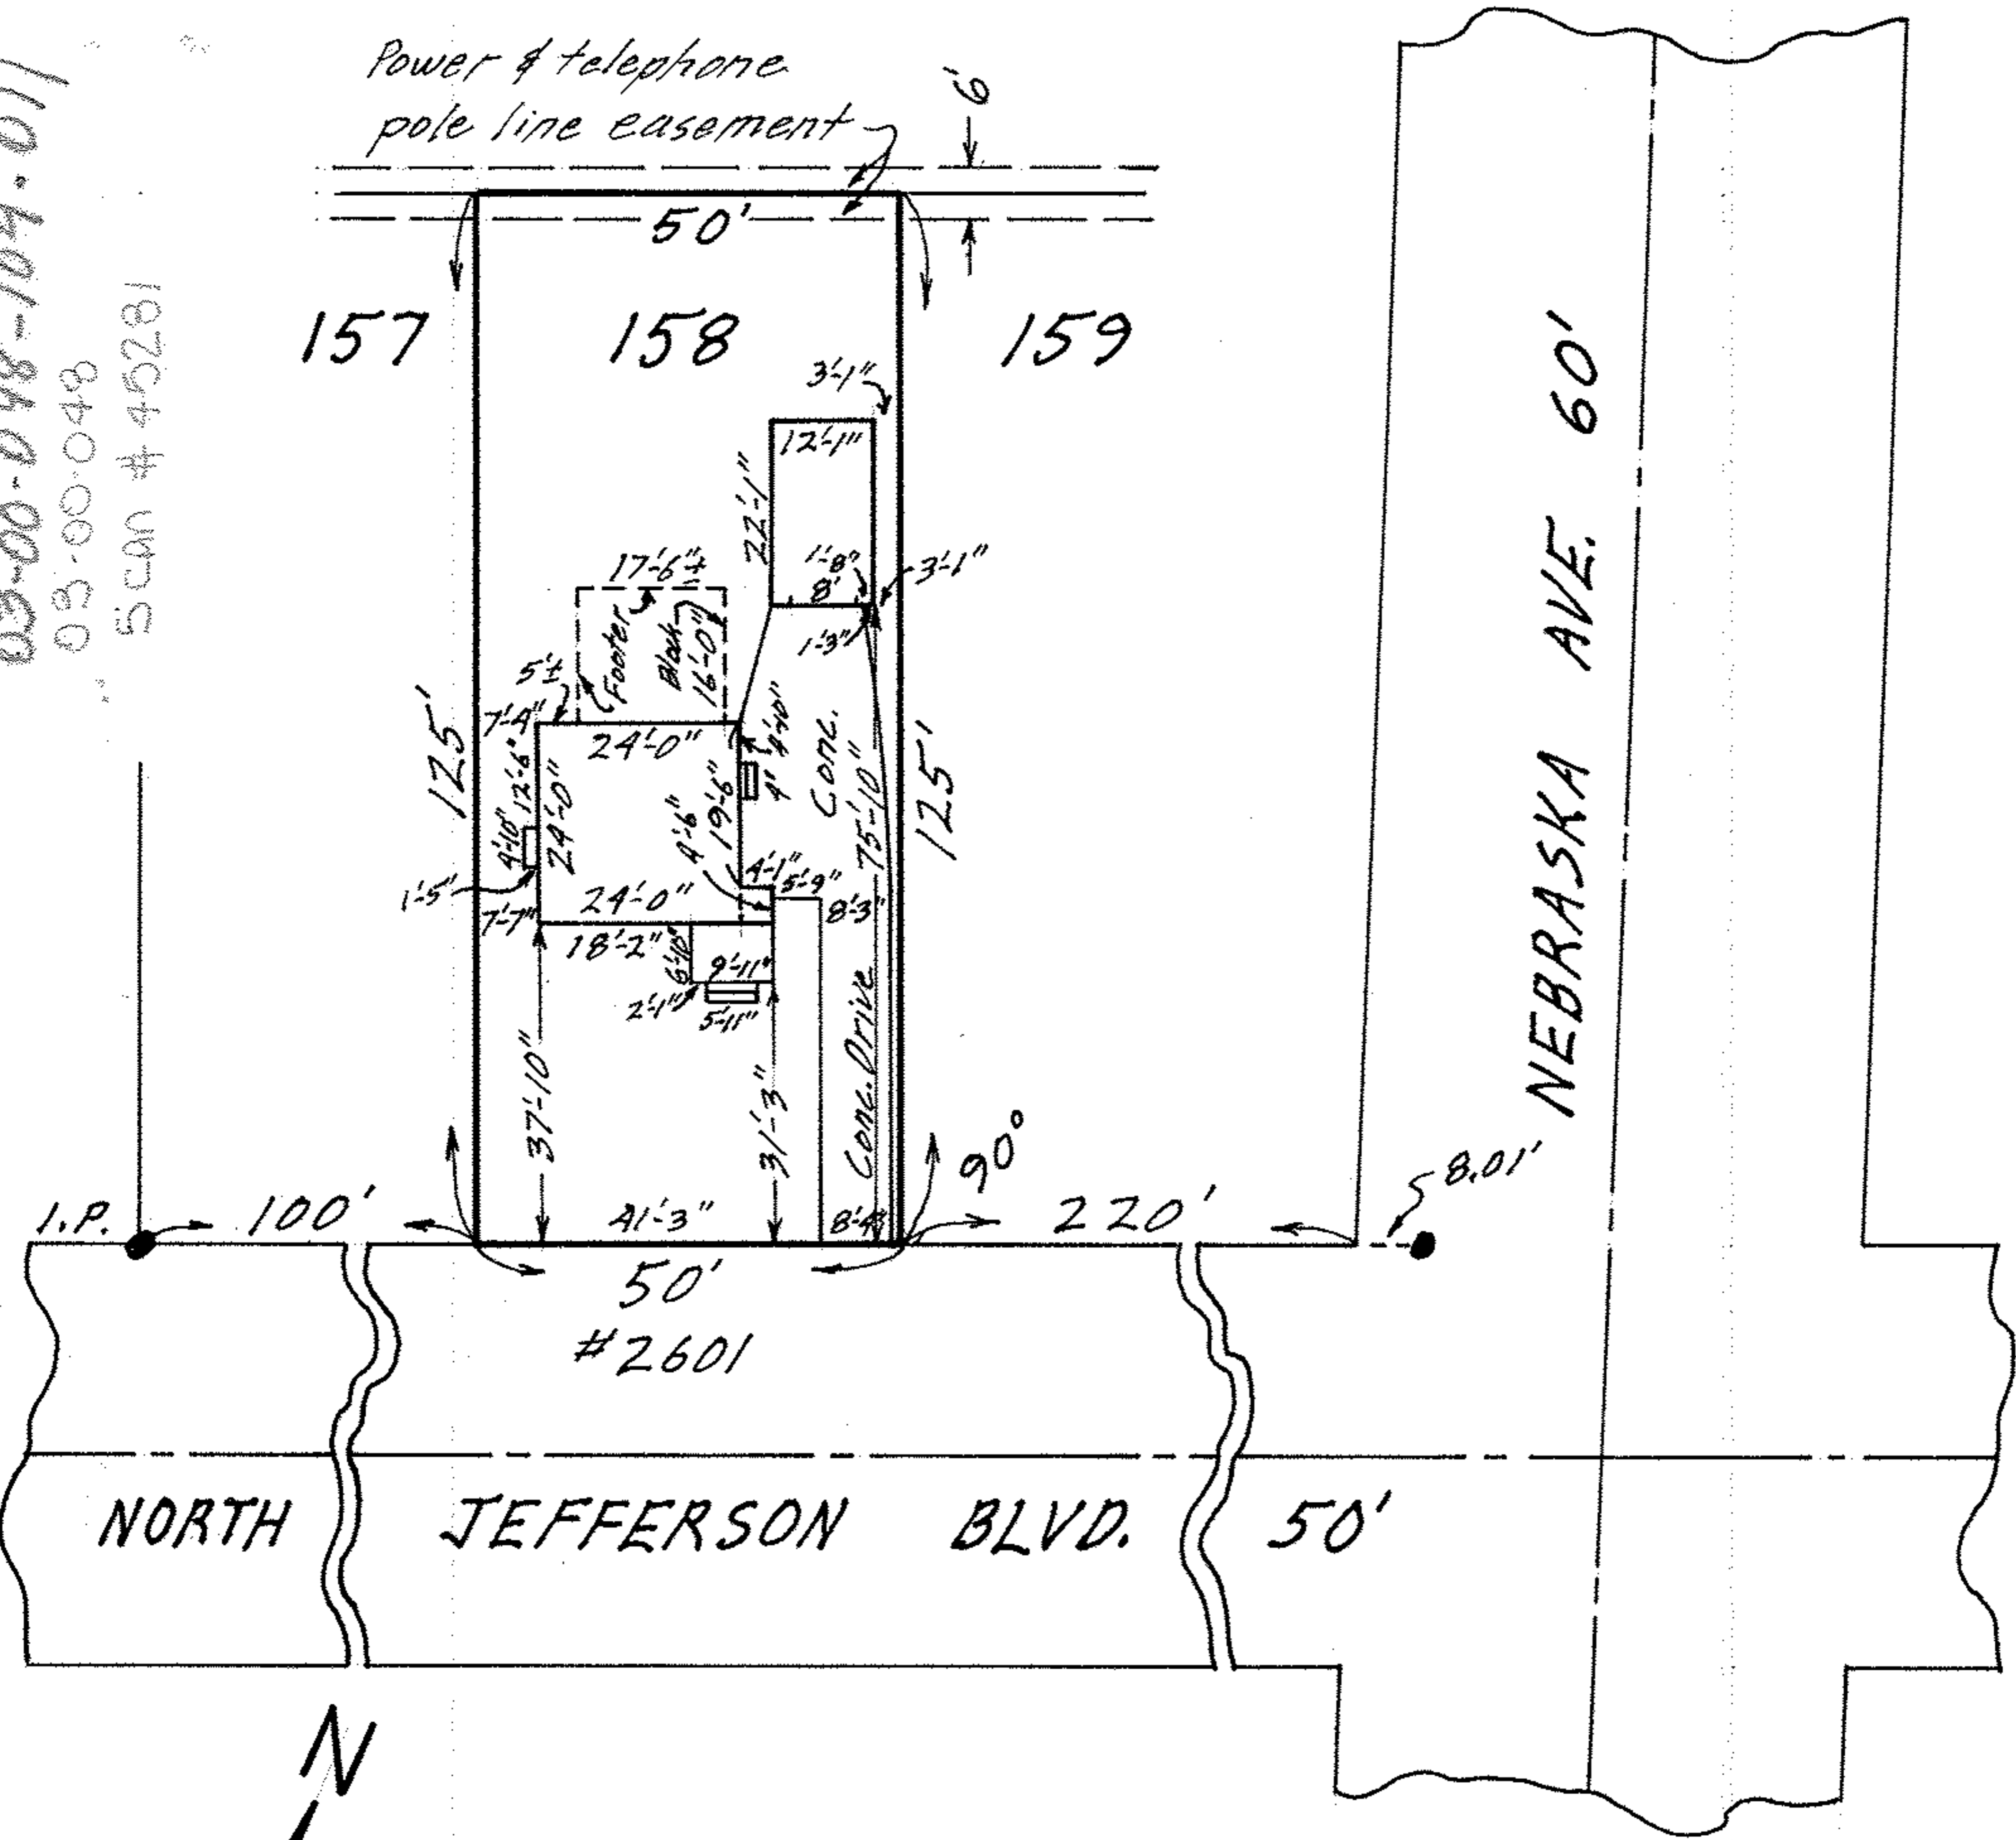

MAP OF SUB-LOT NO. 158  
 HOY-LO-MAE ALL'T., FIRST ADD'N. Vol. 13 Pg. 39  
 SHEFFIELD TWP. - LORAIN CITY  
 LORAIN COUNTY OHIO  
 SCALE: 1" = 30' MAY 16-1967 12:15 P.M.  
 Gary E. Penfound REG. SURVEYOR

Russell & Marianne Provenza