


03-00-048-108-017
 03-00-048
 SCAN# 45282

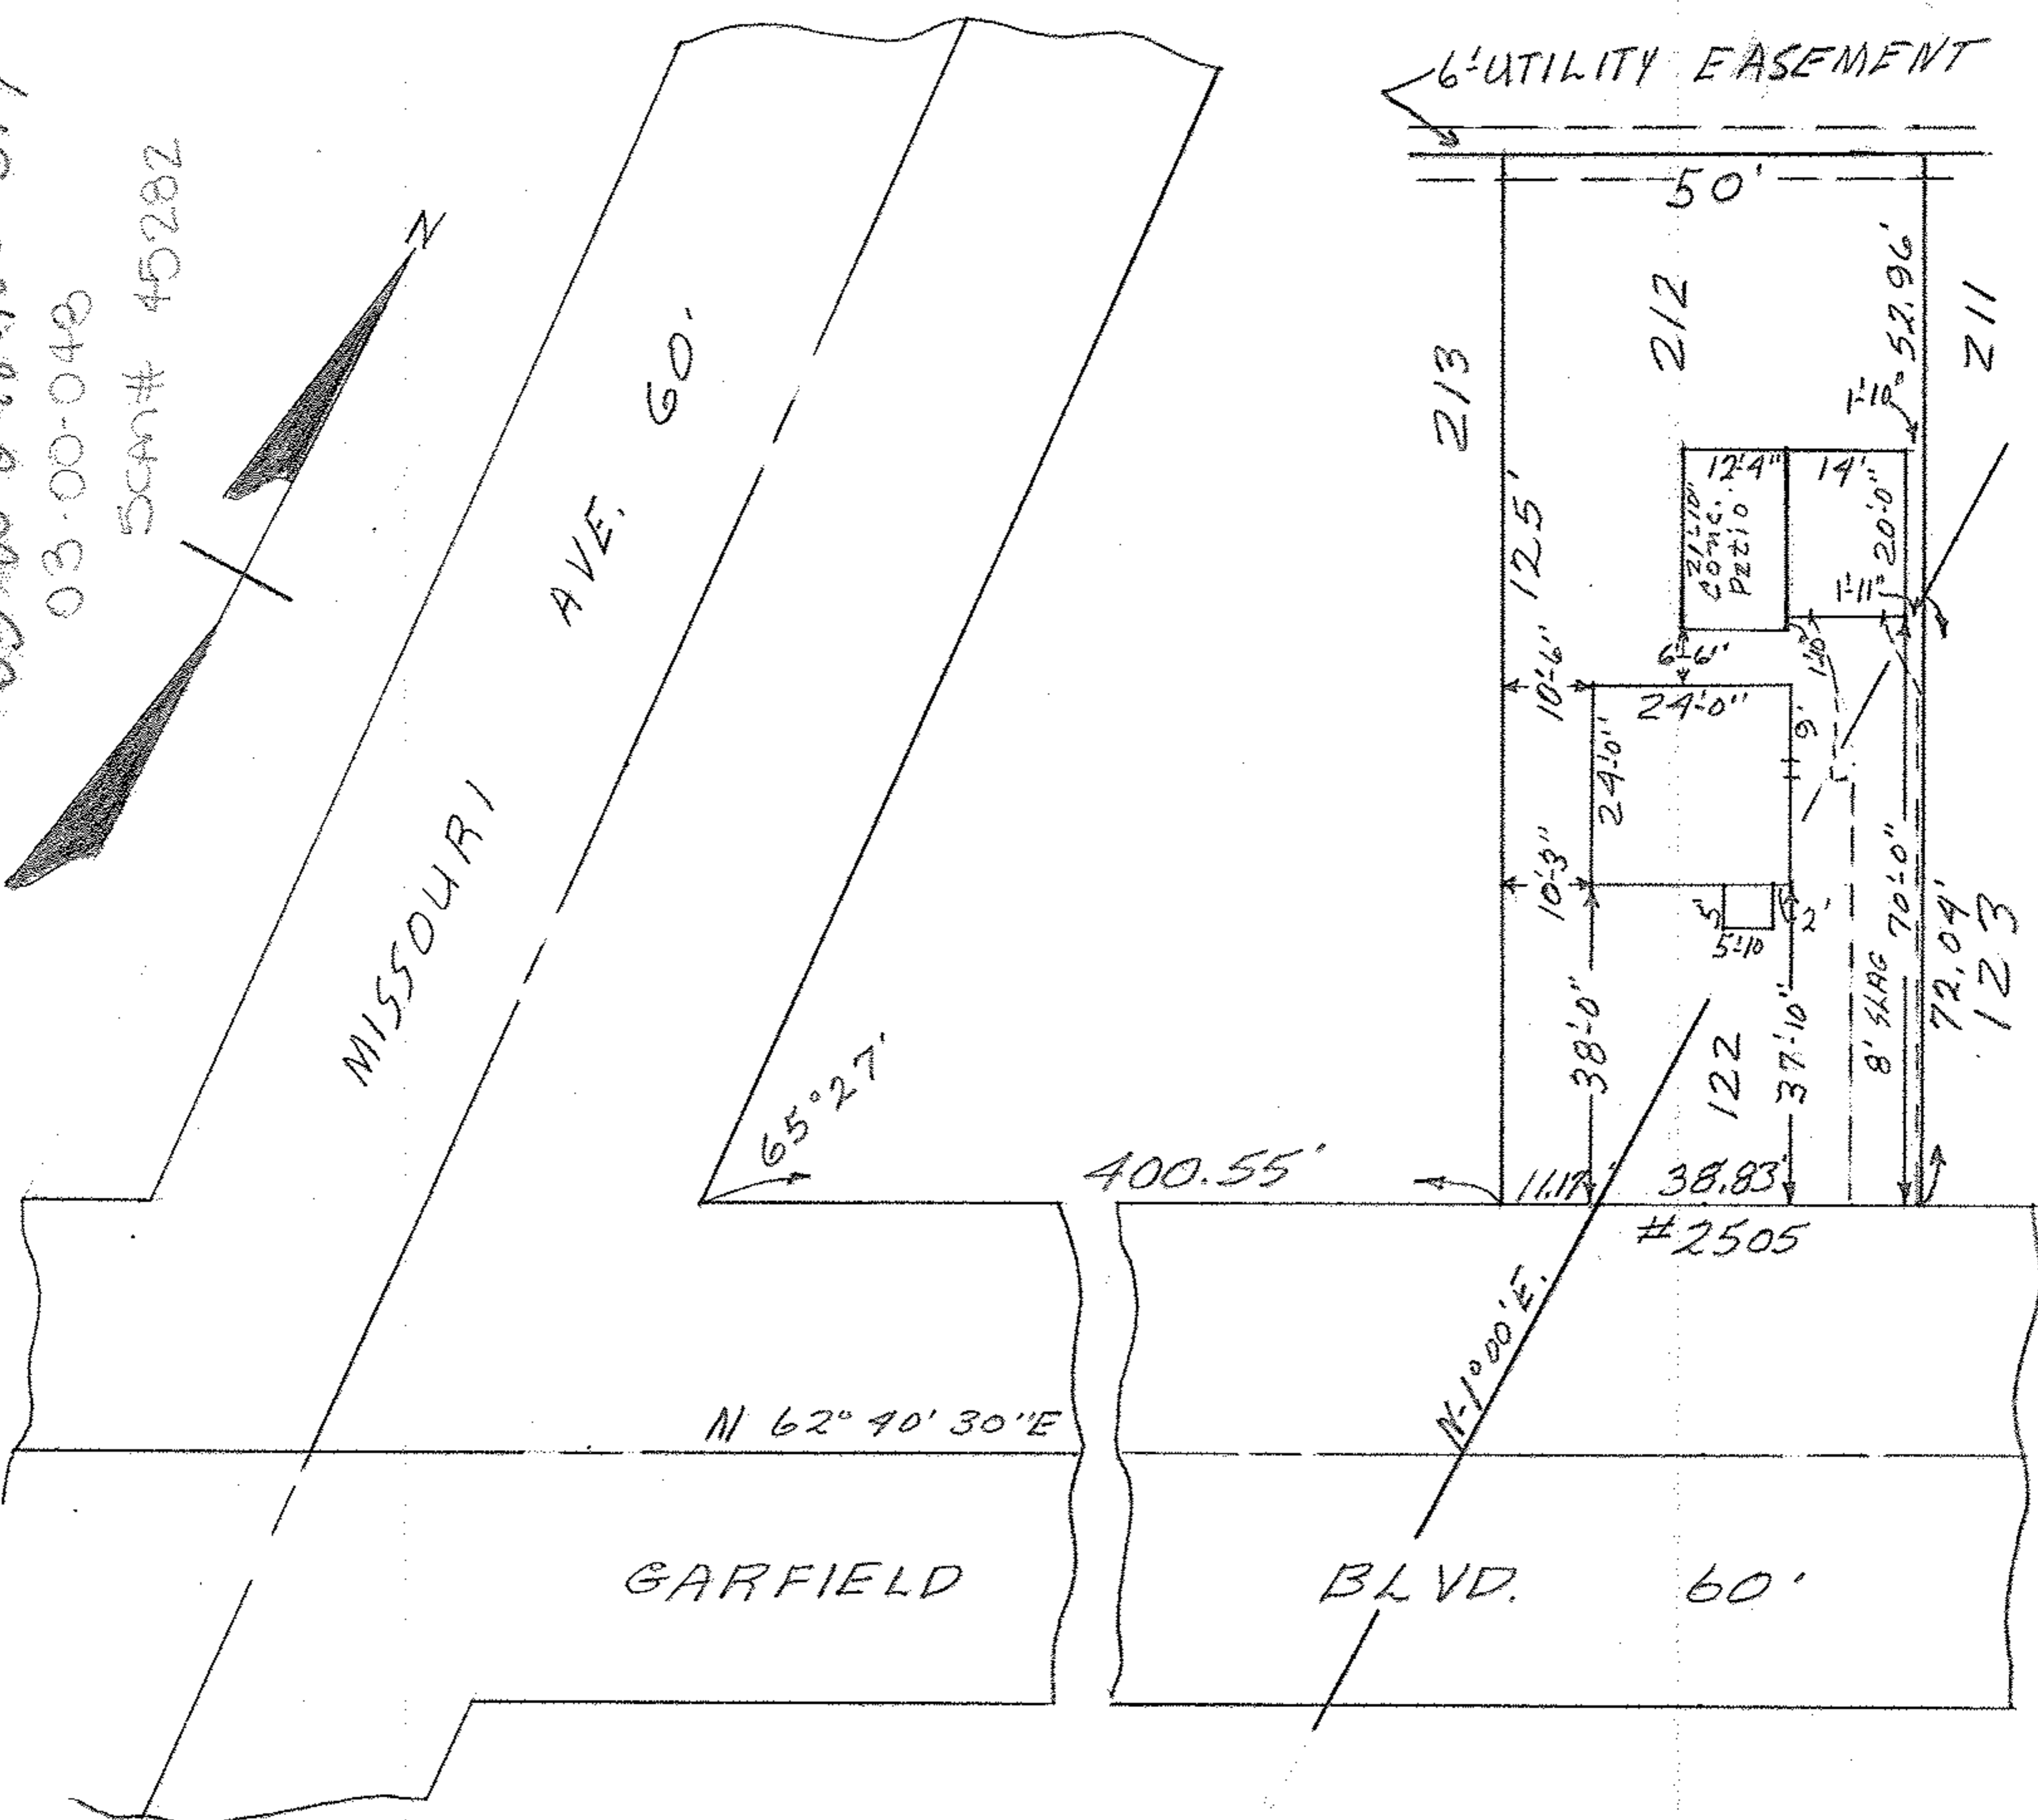

MAP OF SUB-LOT 122
 HOY-LO-MAE ALL'T No 1. Vol. 13 Pg. 39
 AND SUB-LOT 212 HOY-LO-MAE ALL'T No 2
 Vol. 14 Pg. 12. ORIG. LOTS 48 & 49 SHEFFIELD TWP.
 LORAIN CITY LORAIN COUNTY-OHIO
 Scale: 1"=30' AUGUST, 14, 1961 1:15 P.M.

Mary E. Penfound Registered Surveyor.

BARNEY & MILDRED HENKIN BH