


03-00-048-112-006  
03-00-048  
SCAN # 45283

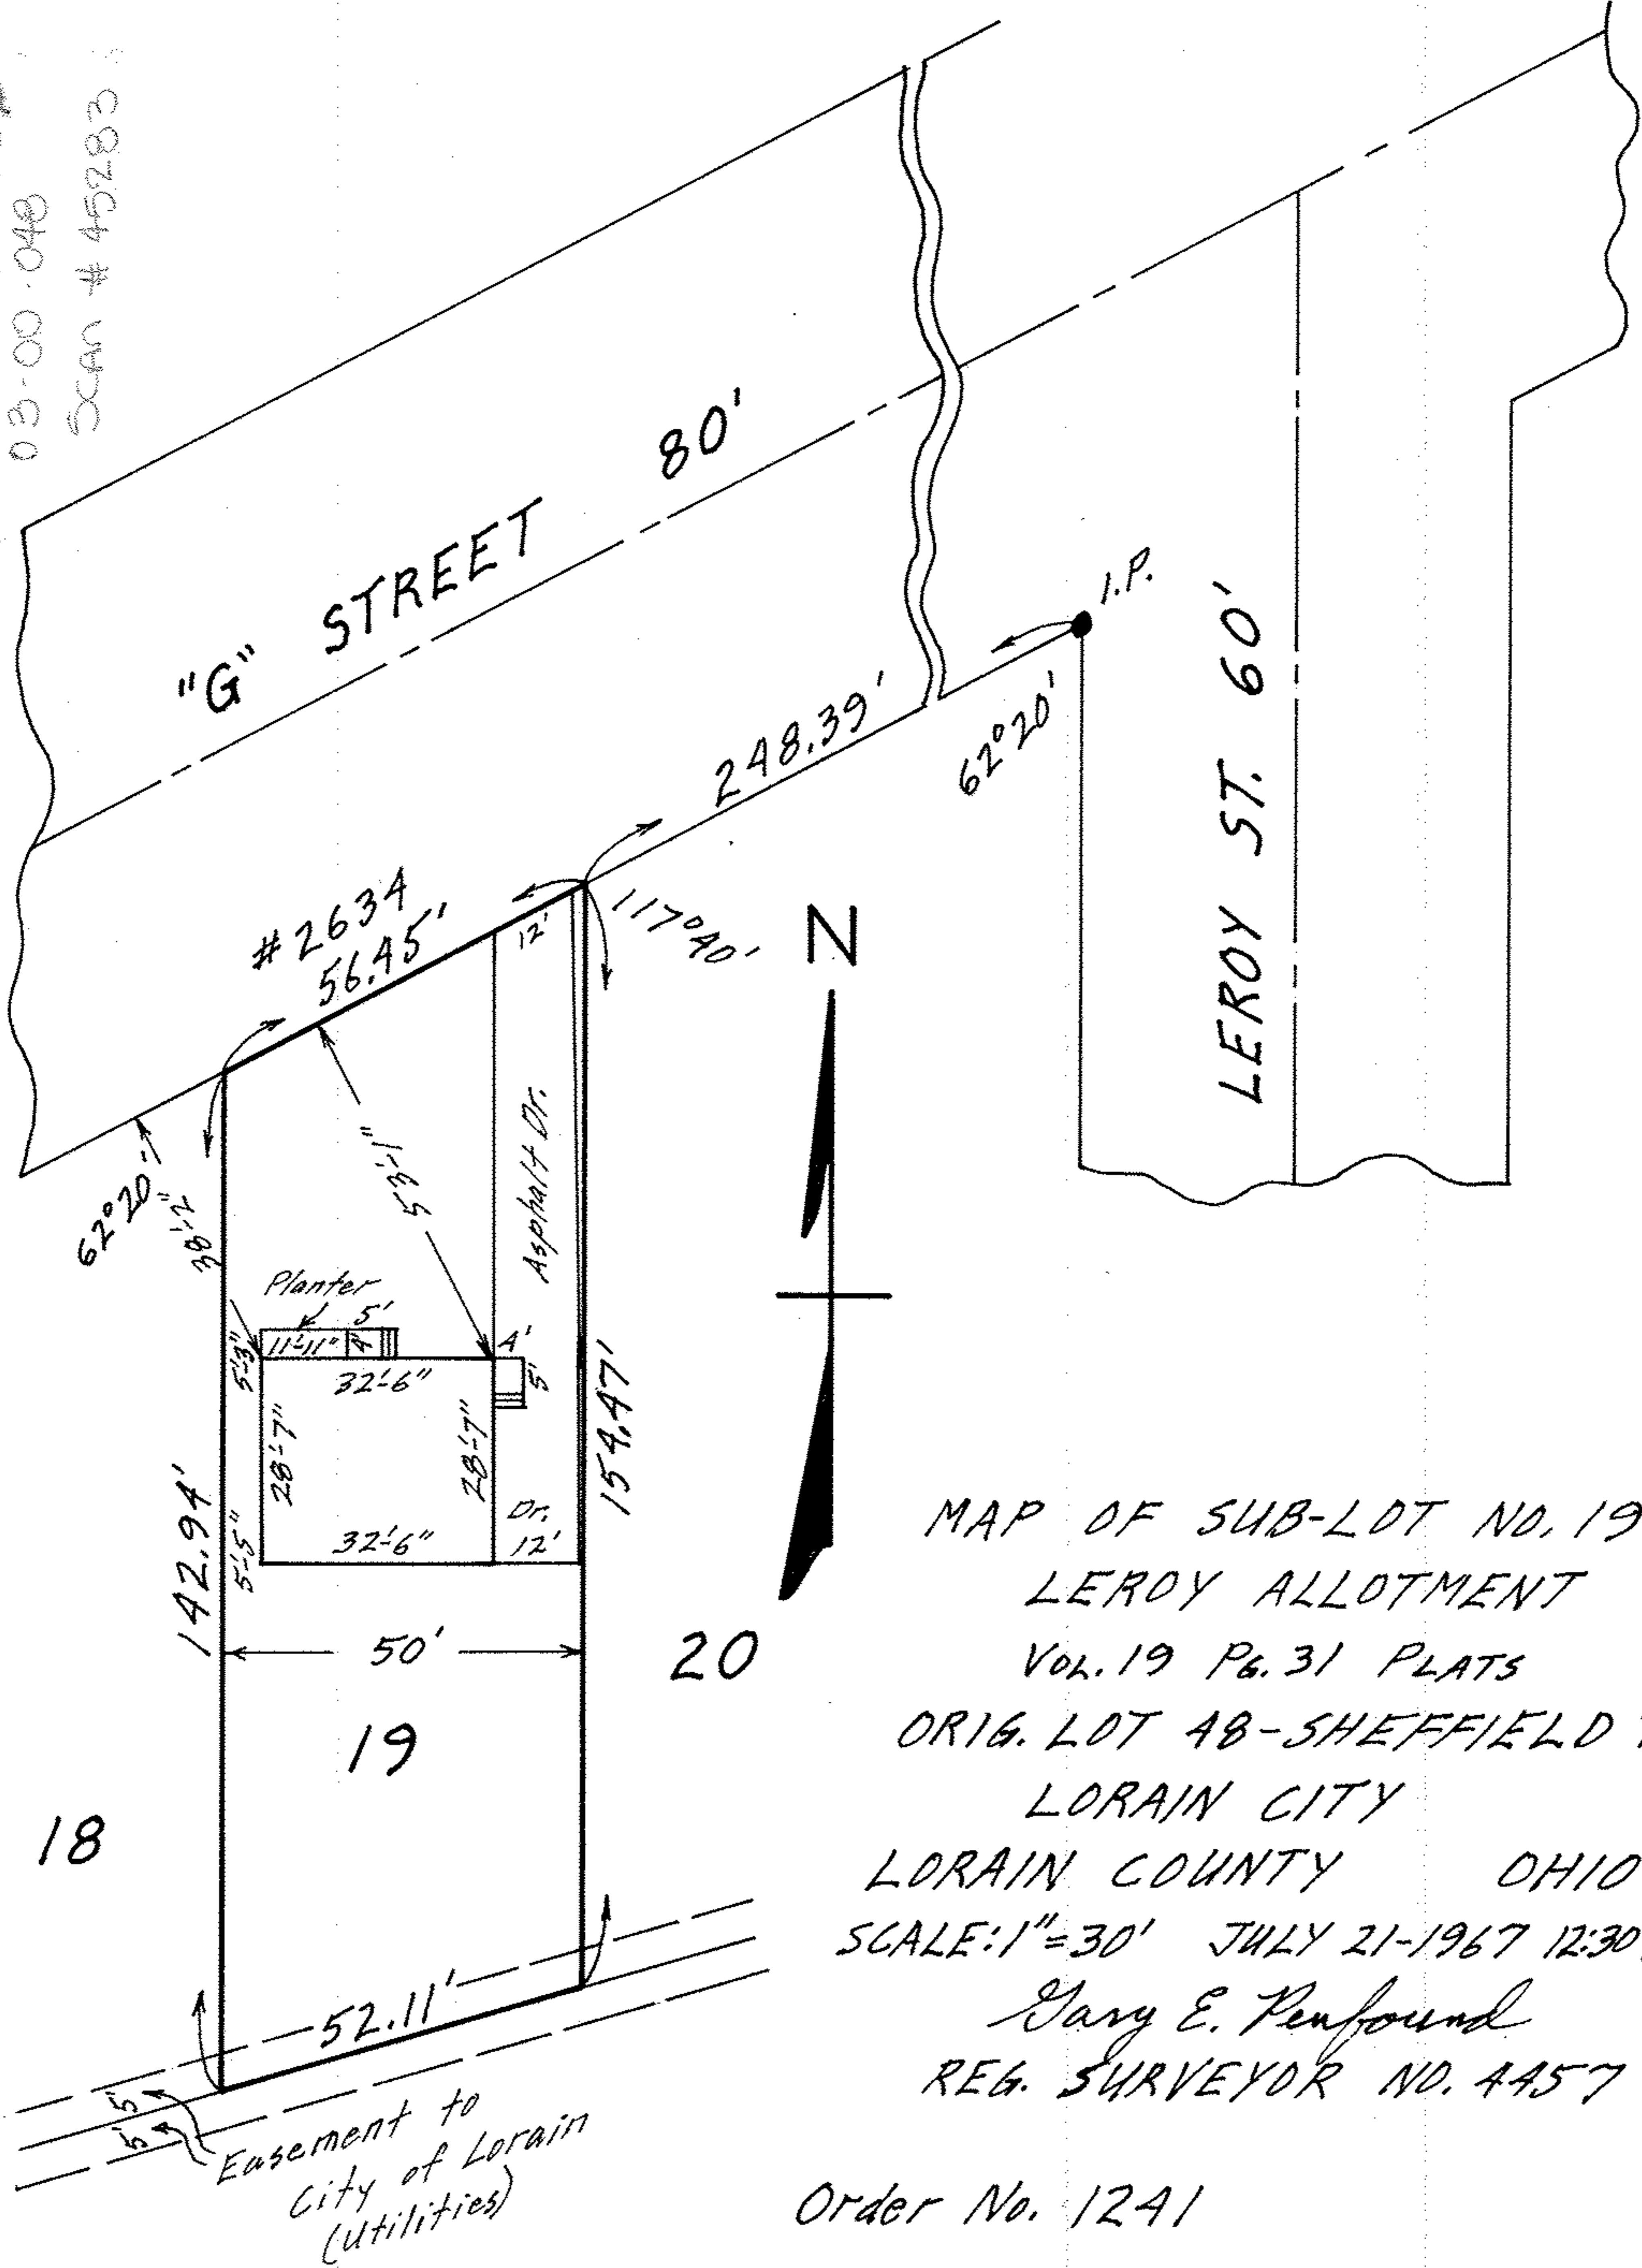

MAP OF SUB-LOT NO. 19  
 LEROY ALLOTMENT  
 Vol. 19 Pg. 31 PLATS  
 ORIG. LOT 48-SHEFFIELD TWP.  
 LORAIN CITY  
 LORAIN COUNTY OHIO  
 SCALE: 1"=30' JULY 21-1967 12:30 P.M.  
 Gary E. Penfound  
 REG. SURVEYOR NO. 4457

Order No. 1241