


SCAN# 45234 03-00-049-104-003

EAST ERIE AVENUE 66'

MISSOURI AVE. 60'

#2426

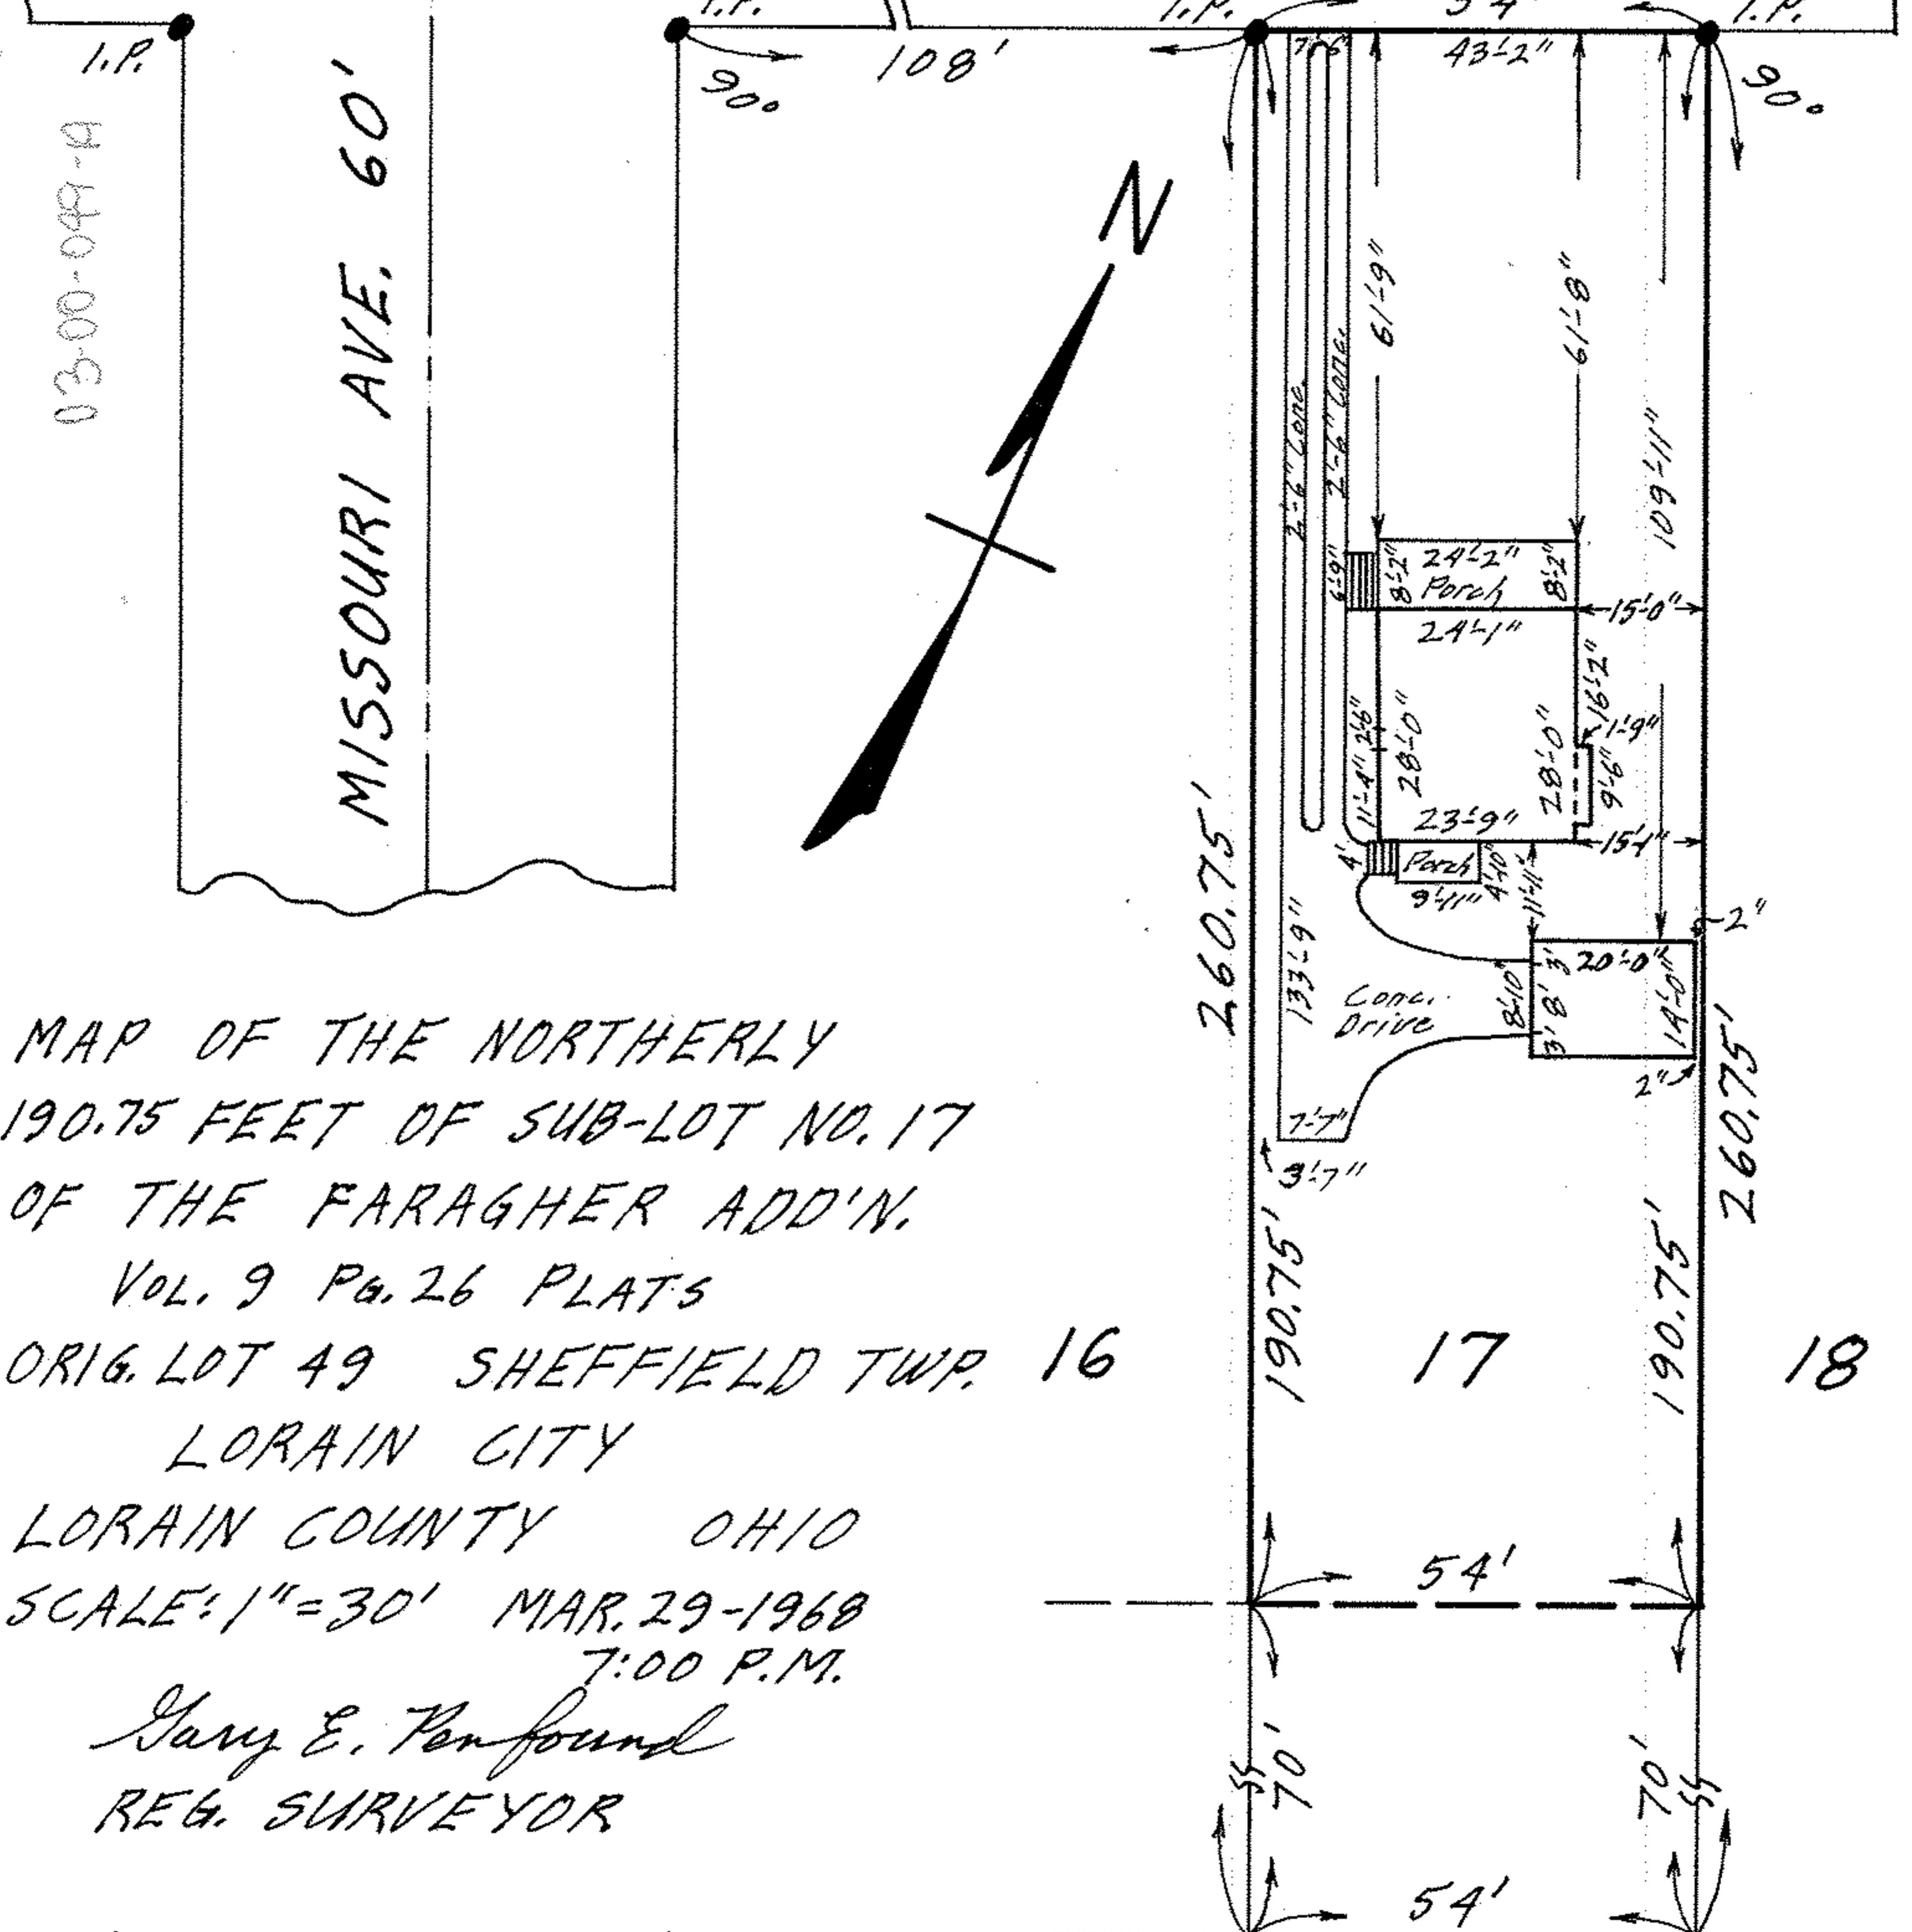

MAP OF THE NORTHERLY
190.75 FEET OF SUB-LOT NO. 17
OF THE FARAGHER ADD'N.

VOL. 9 Pg. 26 PLATS

ORIG. LOT 49 SHEFFIELD TWP. 16

LORAIN CITY

LORAIN COUNTY OHIO

SCALE: 1"=30' MAR. 29-1968

7:00 P.M.

Gary E. Penfound

REG. SURVEYOR

Alexander E. Negriz

03-00-049