


03-00-049-120-004
03-00-049-0
SCAN #45288

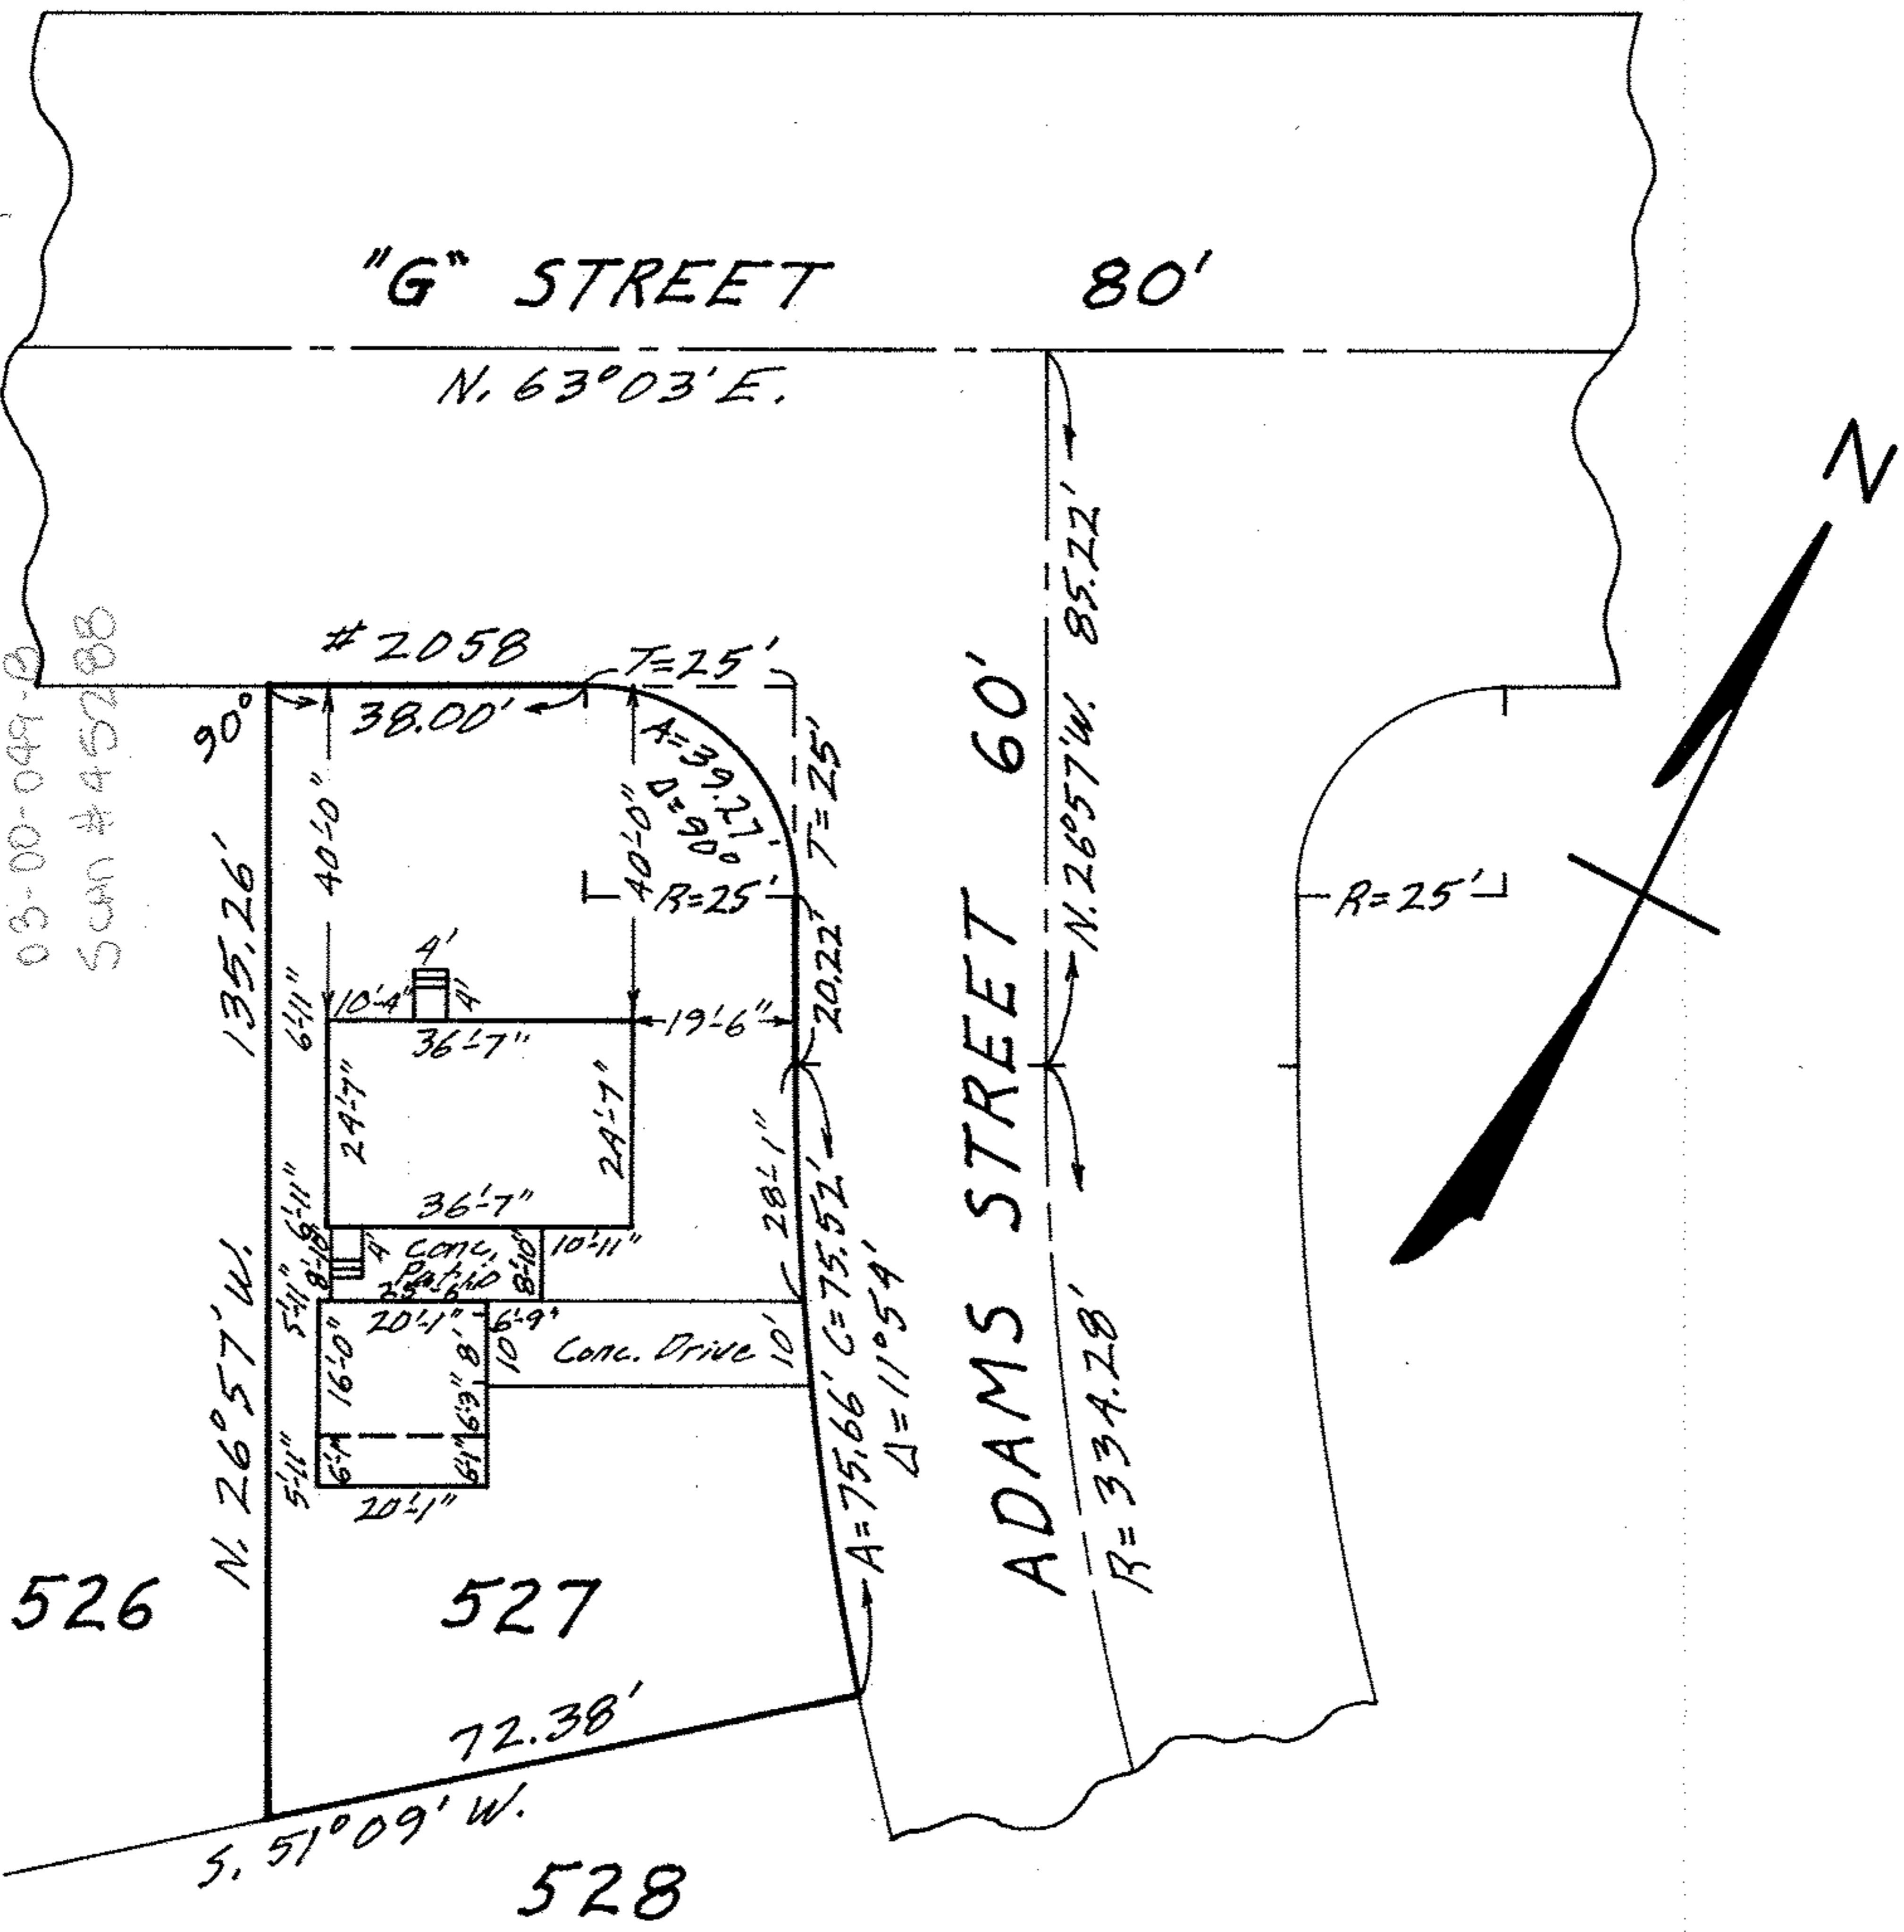

MAP OF SUB-LOT NO. 527

HOY-LO-MAE ALL'T., 5TH ADD'N. VOL. 22 P. 86
ORIG. LOT 49 - SHEFFIELD TWP. - LORAIN CITY
LORAIN COUNTY OHIO

SCALE: 1" = 30' JULY 21-1967 2:15 P.M.

Gary E. Penfound REG. SURVEYOR

James M. & Shirley Sue Harris