


03-00-050
 SCAN # 45292
 050-00-00
 03-00-050

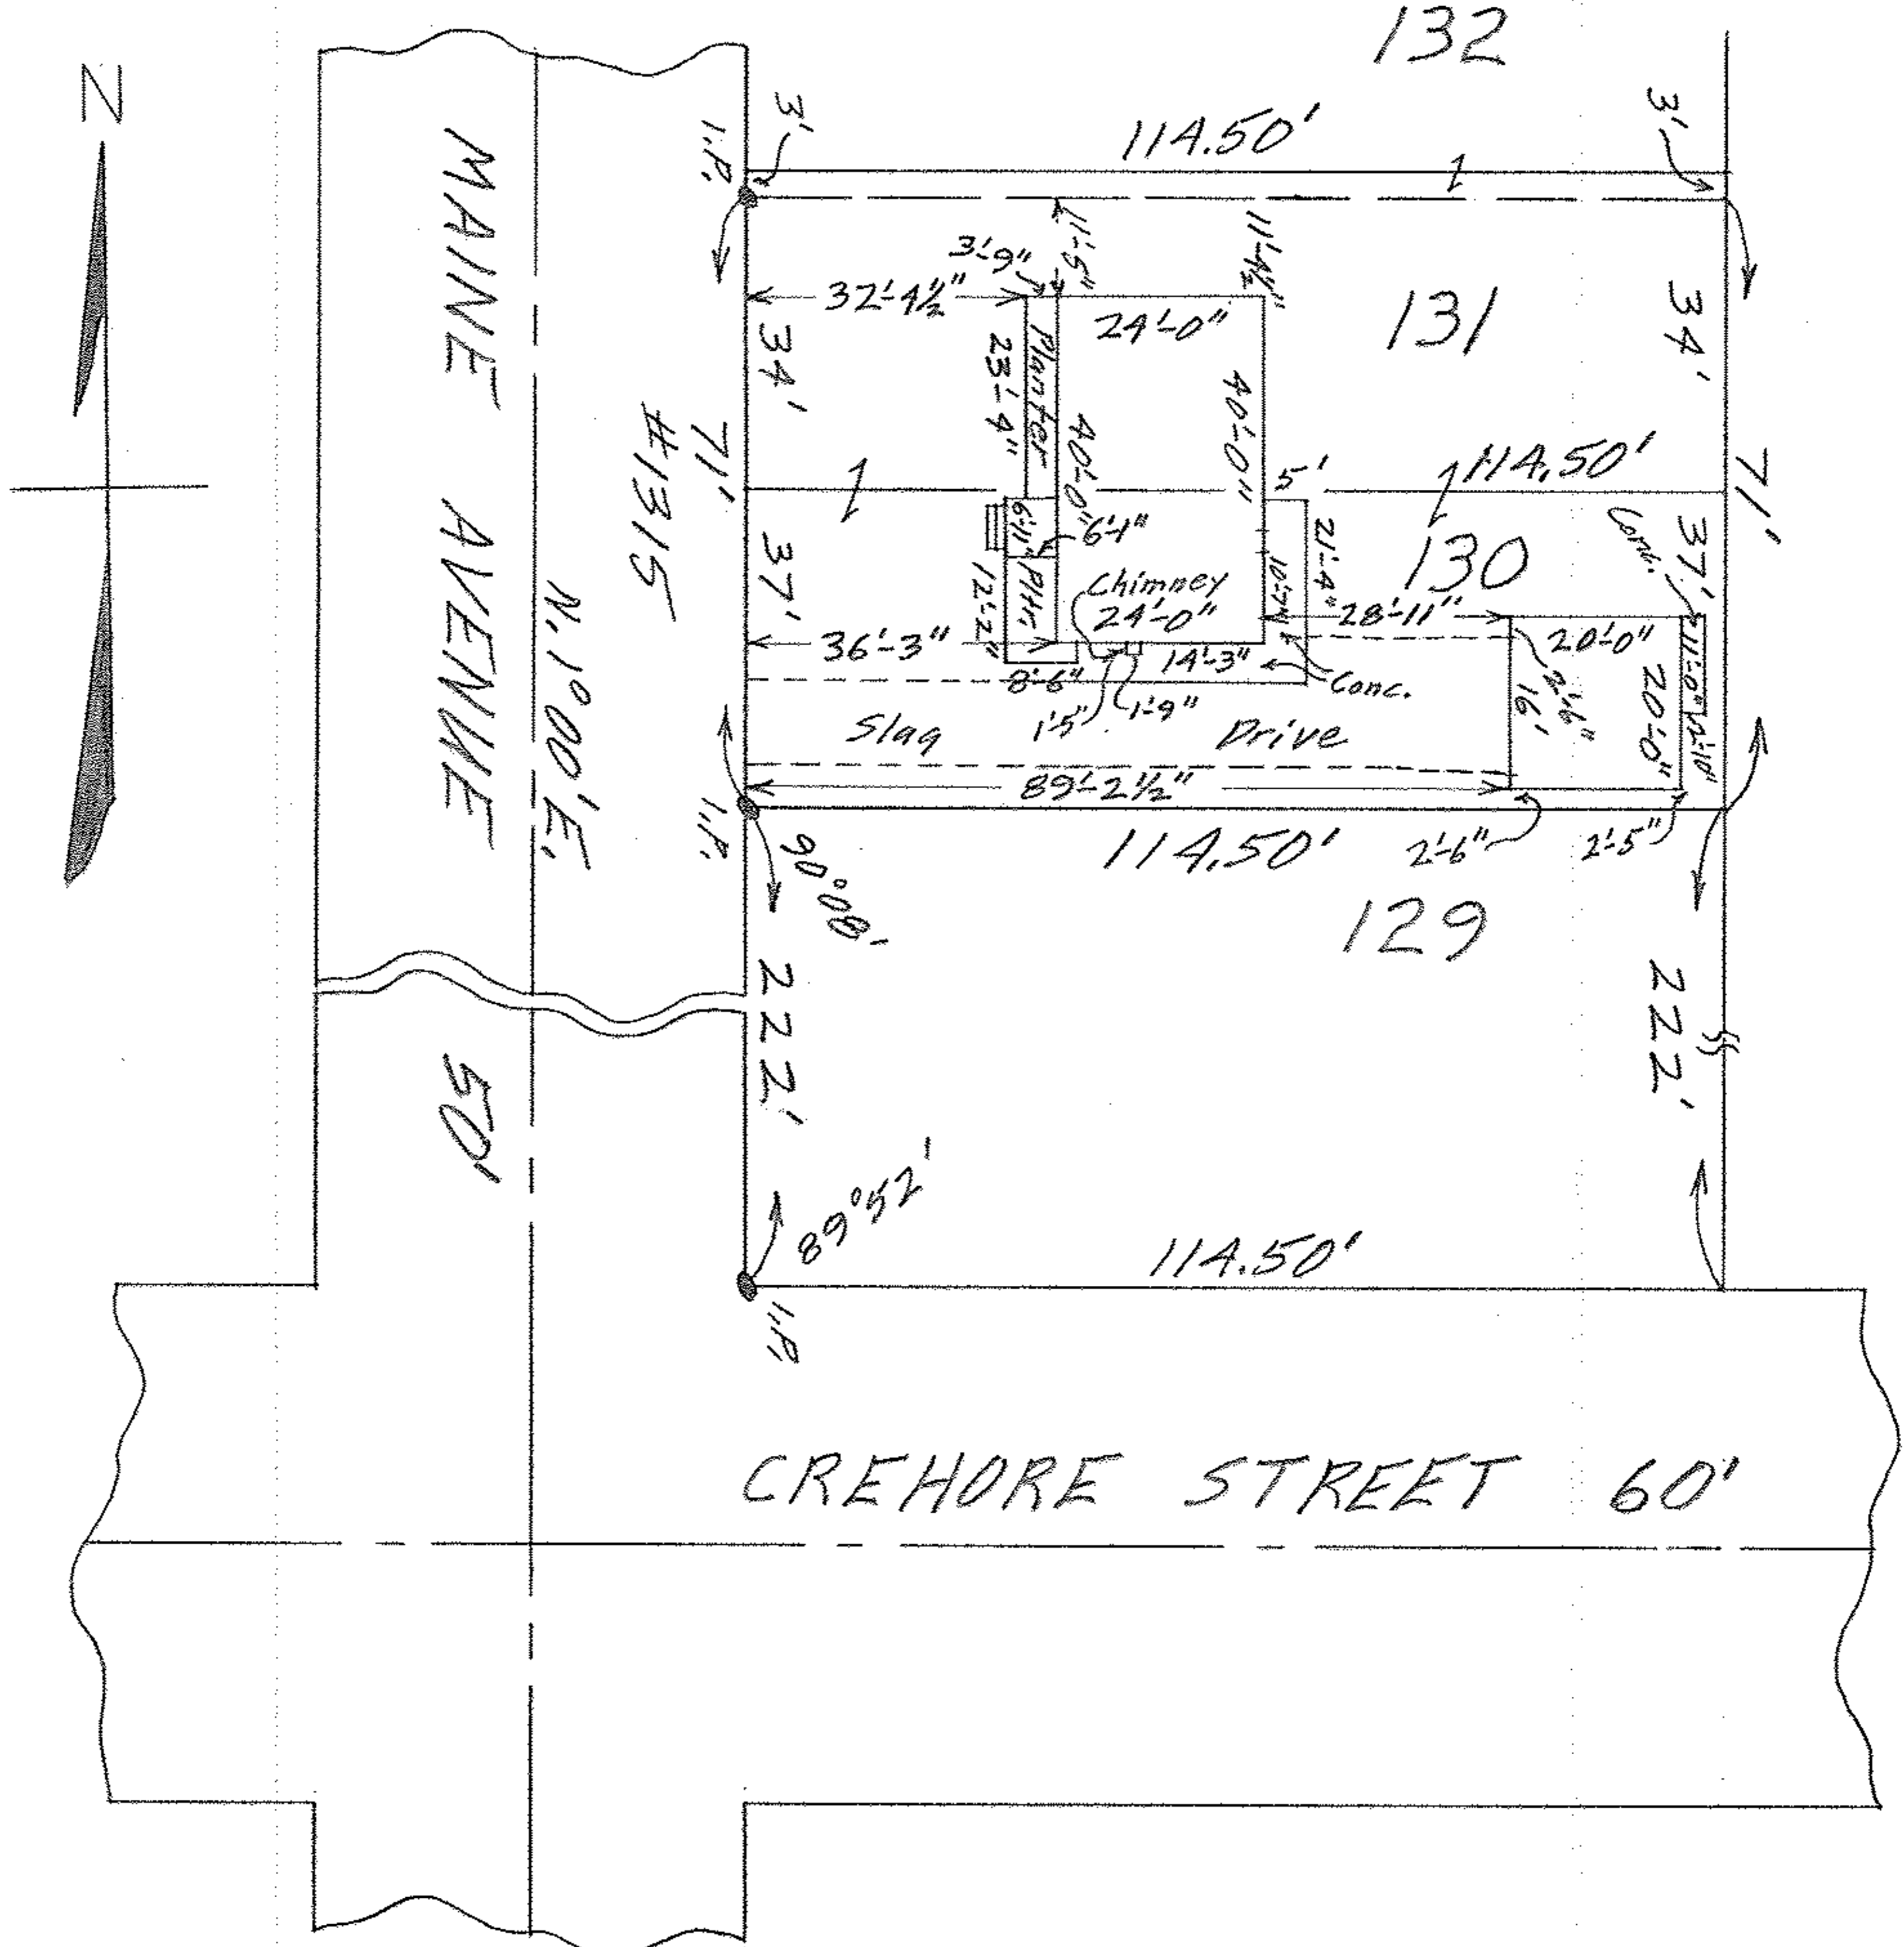

MAP OF SUB-LOT NO. 130 AND SOUTHERLY 34 FEET
 OF SUB-LOT NO. 131 OF COLORADO PARK ALLOTMENT
 VOL. 9 PG. 12 PLAT RECORDS - ORIG. LOT 50 SHEFFIELD TWP.
 LORAIN CITY - LORAIN COUNTY - OHIO
 SCALE: 1"=30' SEPT. 17-1964 7:15 P.M.
 Mary E. Penfound REG. SURVEYOR
 John L. & Lorene Bracy