
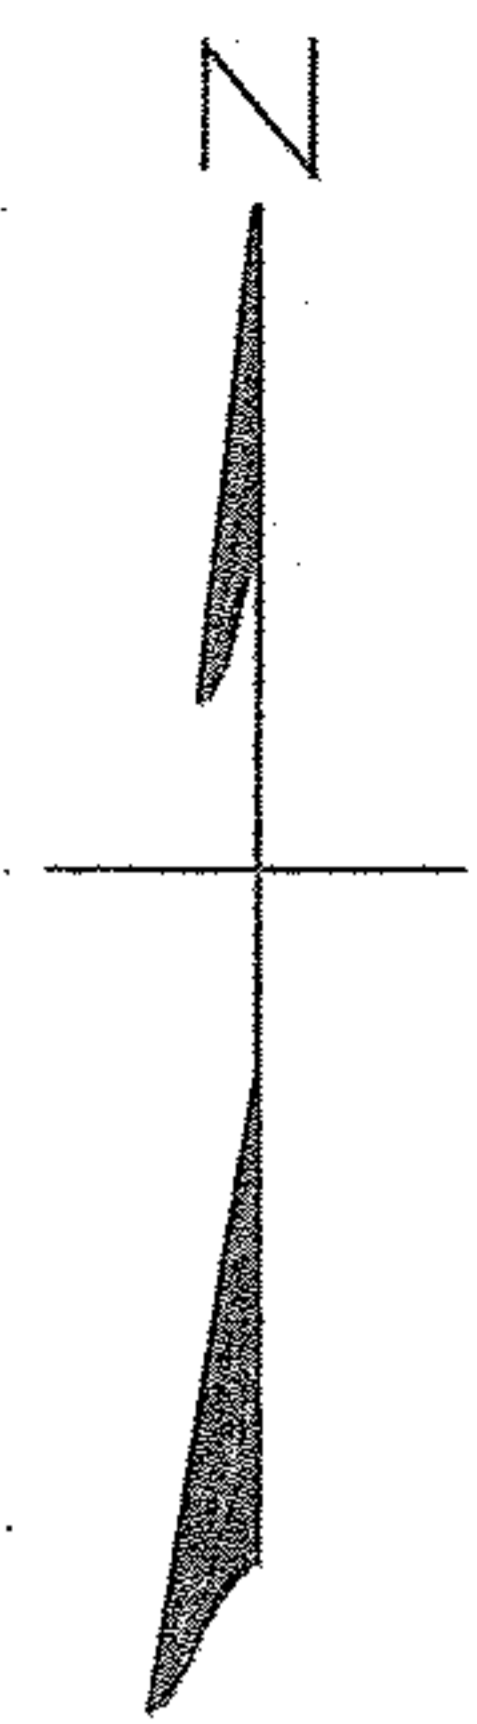


03-00-050-110-020

03-00-050
SCAN # 45293

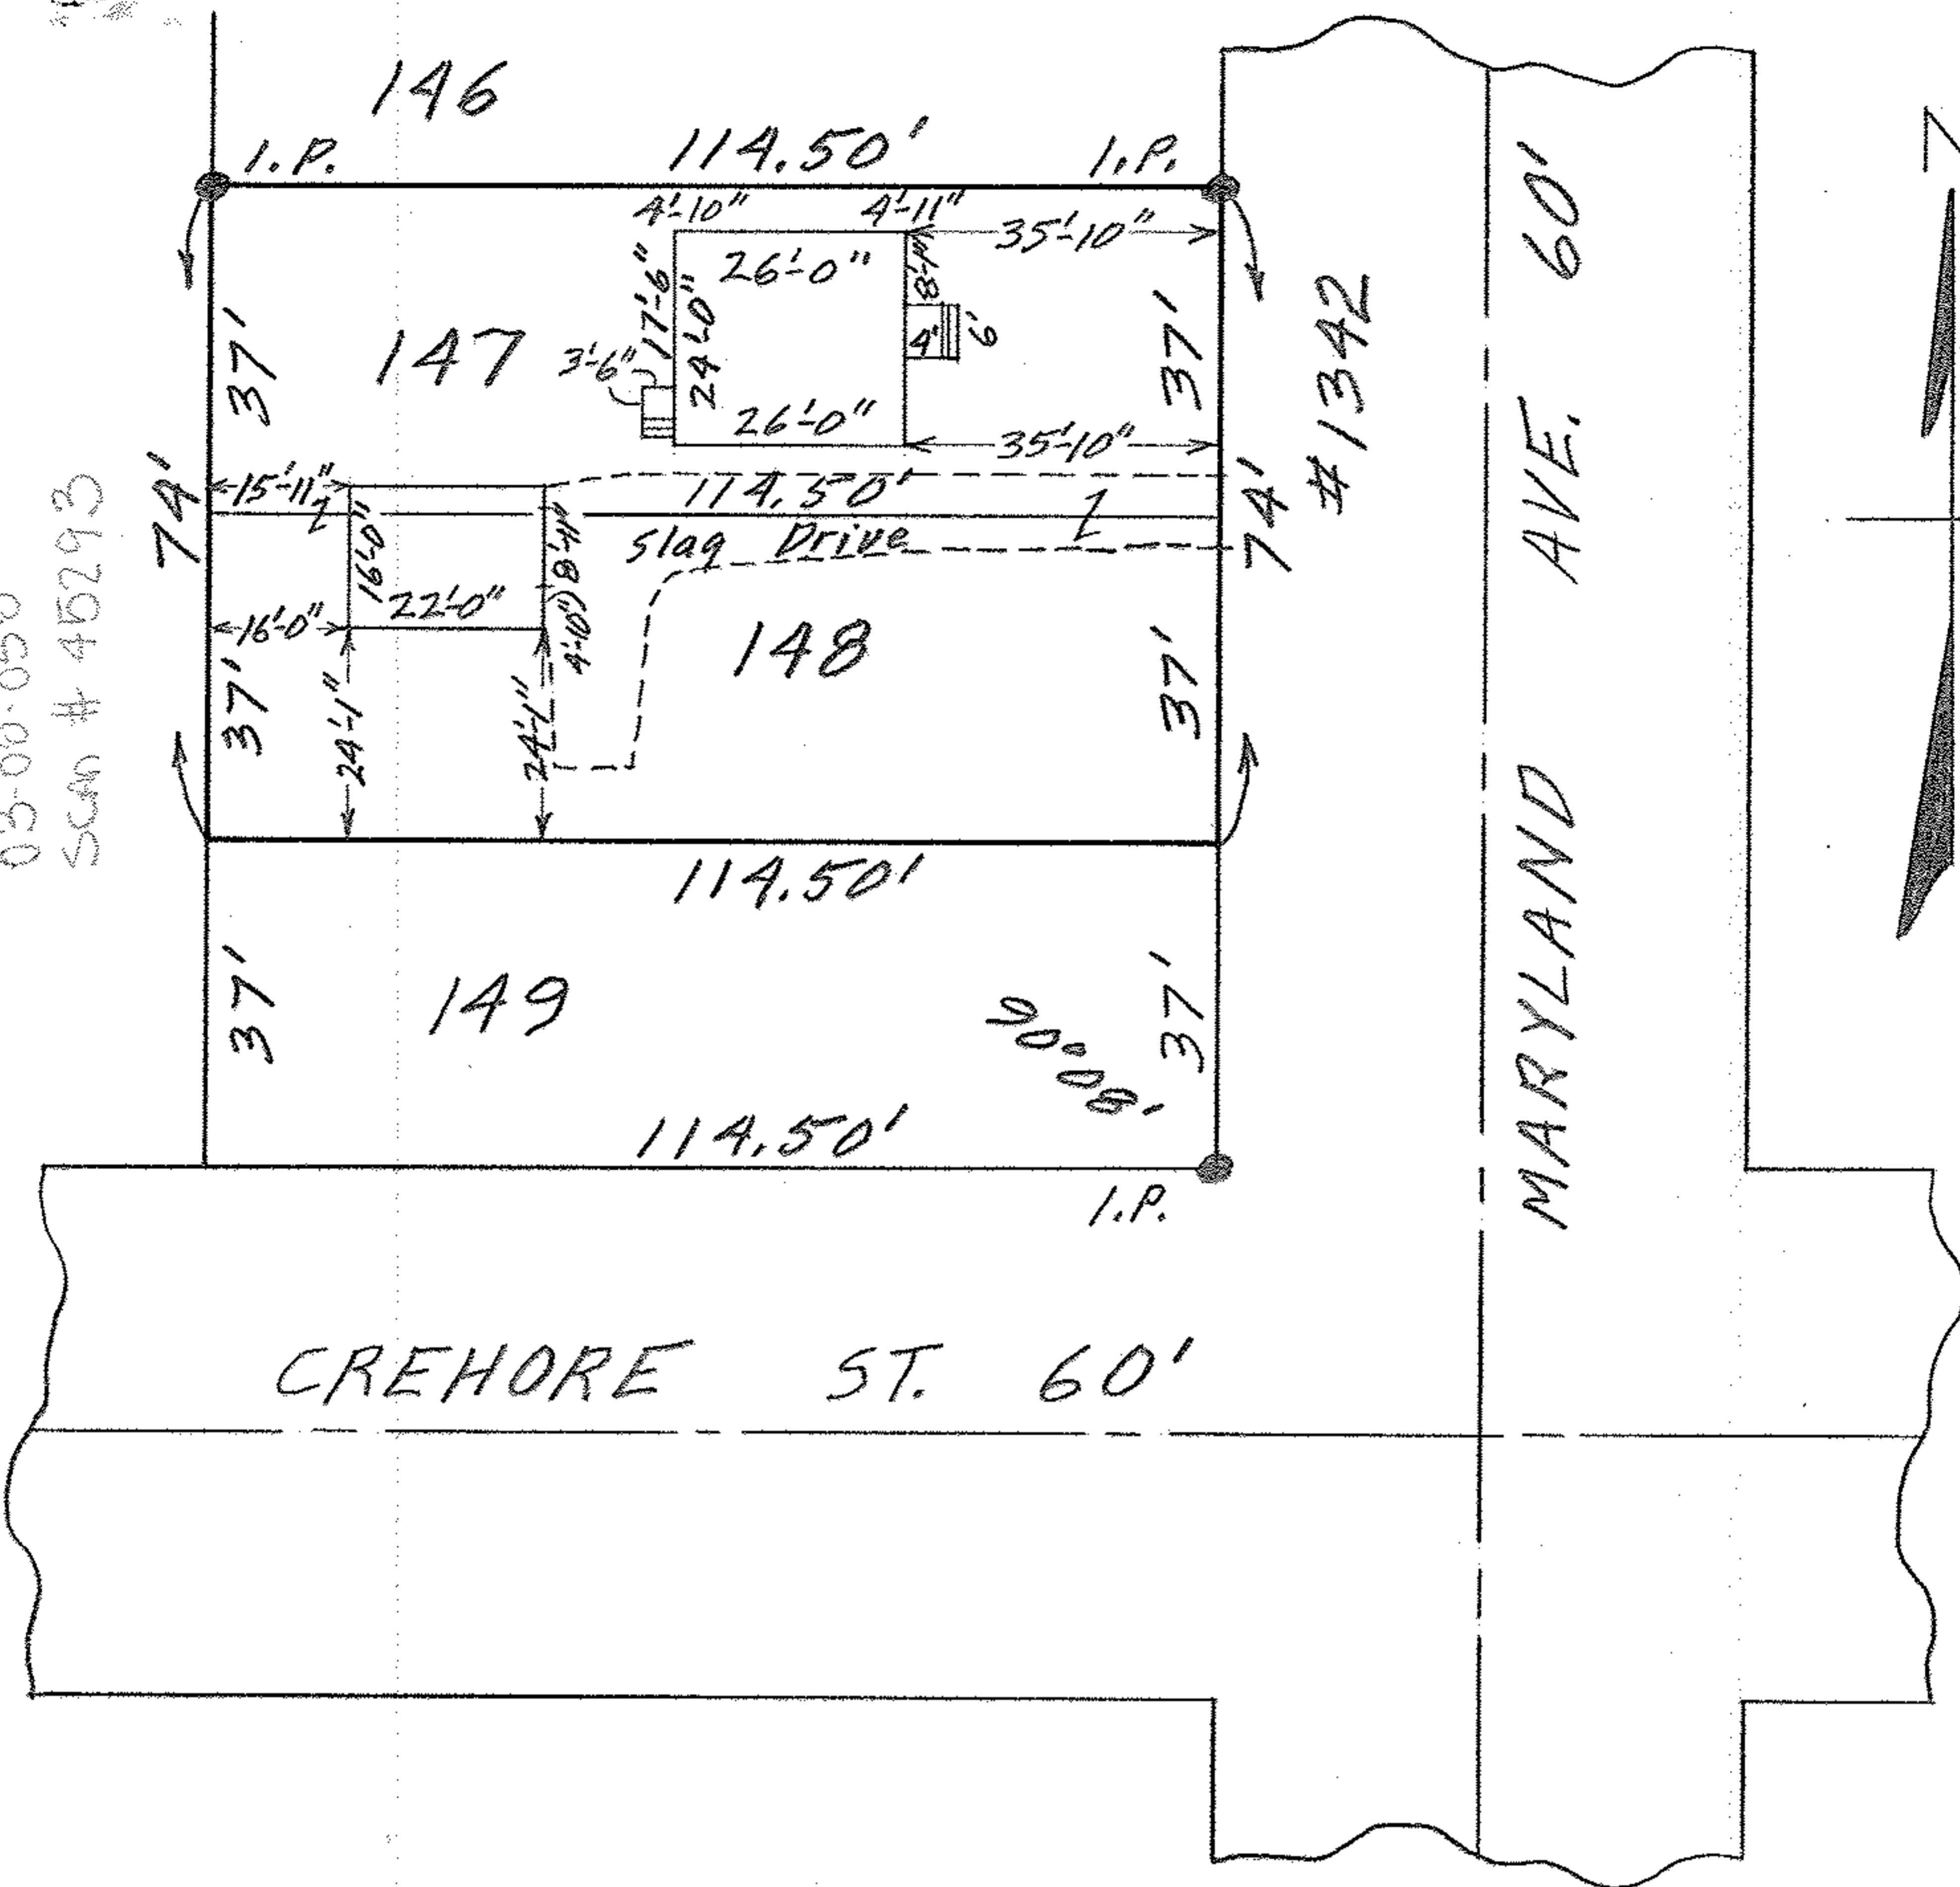

MAP OF SUB-LOTS NO.'S 147 & 148
 COLORADO PARK ALL'T. VOL. 9 PG. 12
 ORIG. LOT NO. 50 SHEFFIELD TWP.
 LORAIN CITY - LORAIN COUNTY - OHIO
 SCALE: 1"=30' DEC. 2-1965 9:15 A.M.

Gary E. Penfound
 for C. E. Penfound REG. SURVEYORS

GL-1418 A.C. & Frances Wood