



03-00-055AD 7012
 03-00-055-A
 Scan # 45297

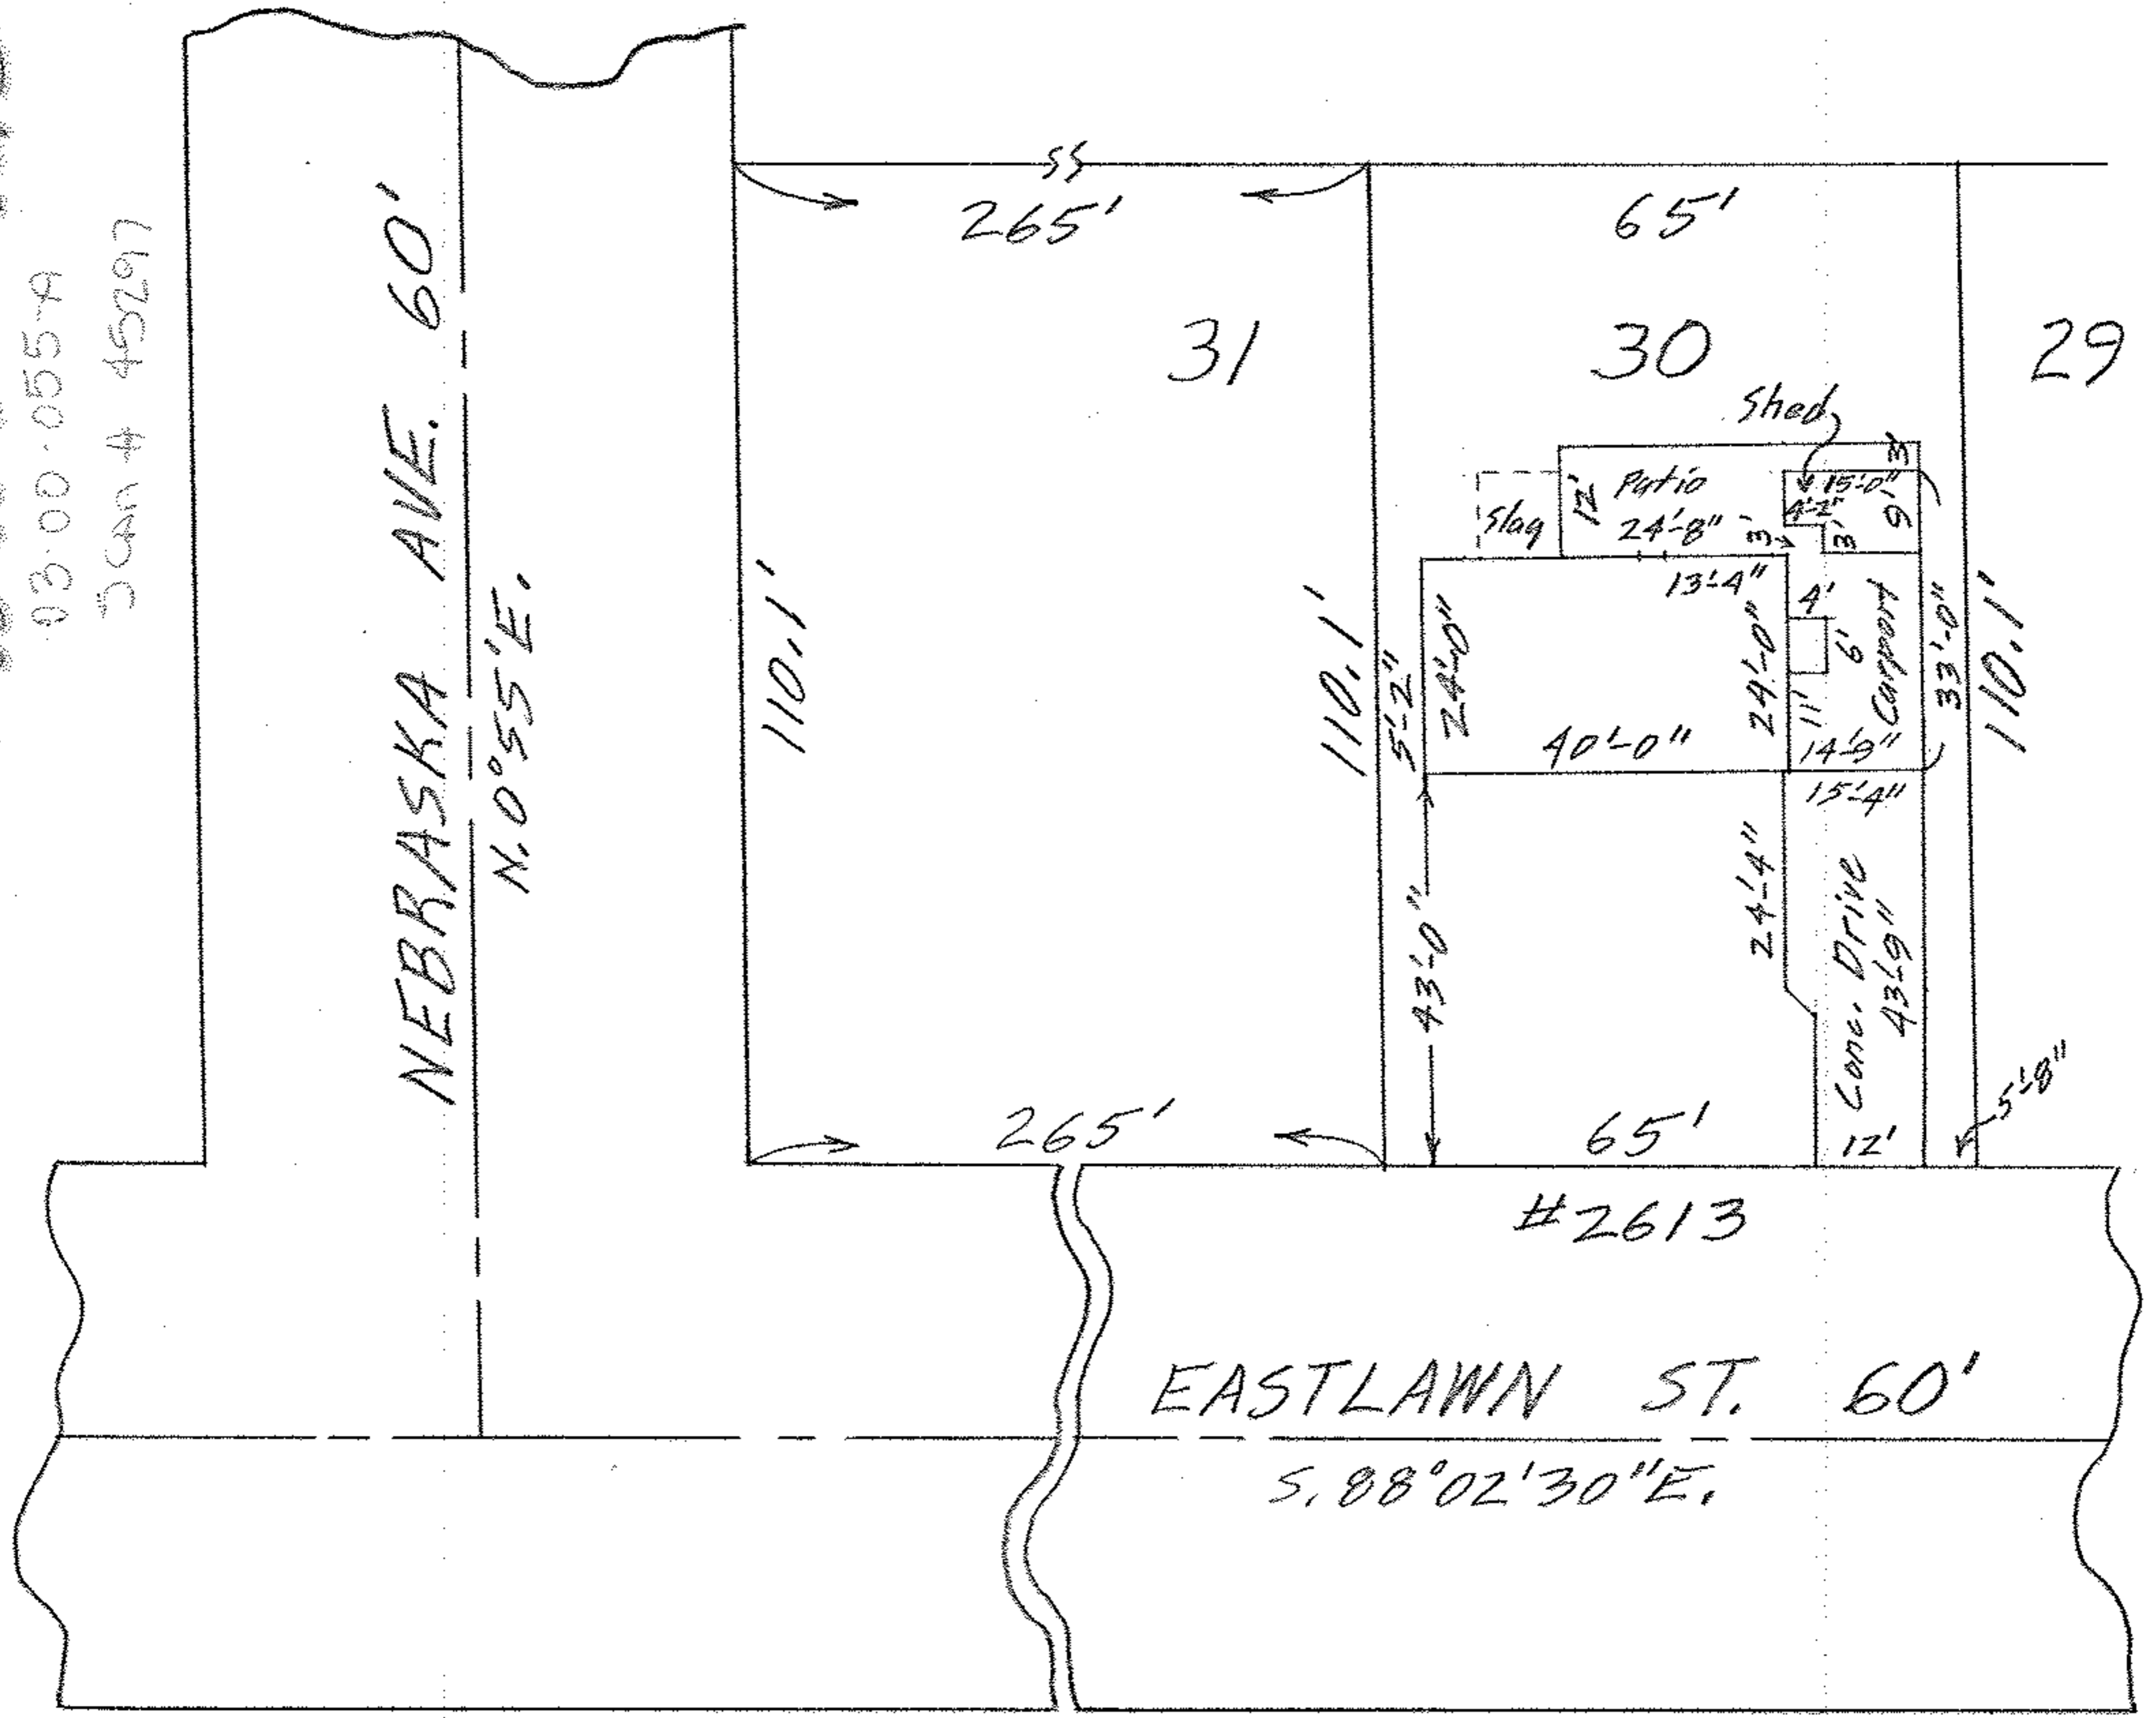

MAP OF SUB-LOT NO. 30

LARKWOOD SUB'N. NO. 3 Vol. 19 Pg. 11
 ORIG. LOT NO. 55 - SHEFFIELD TWP.
 LORAIN CITY - LORAIN COUNTY - OHIO
 SCALE: 1"=100' APRIL 4-1964 11:45 A.M.
 Gary E. Penfound
 for C. E. Penfound REG. SURVEYOR

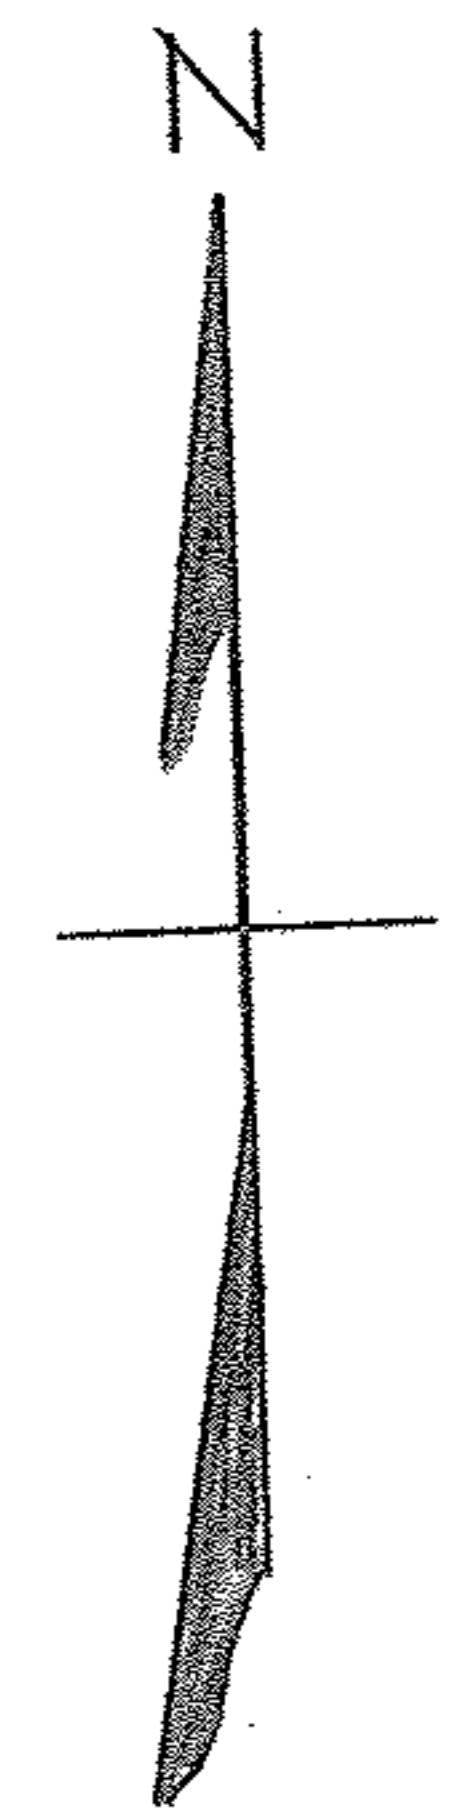

E-13119