


03-00-056-104-036, 037

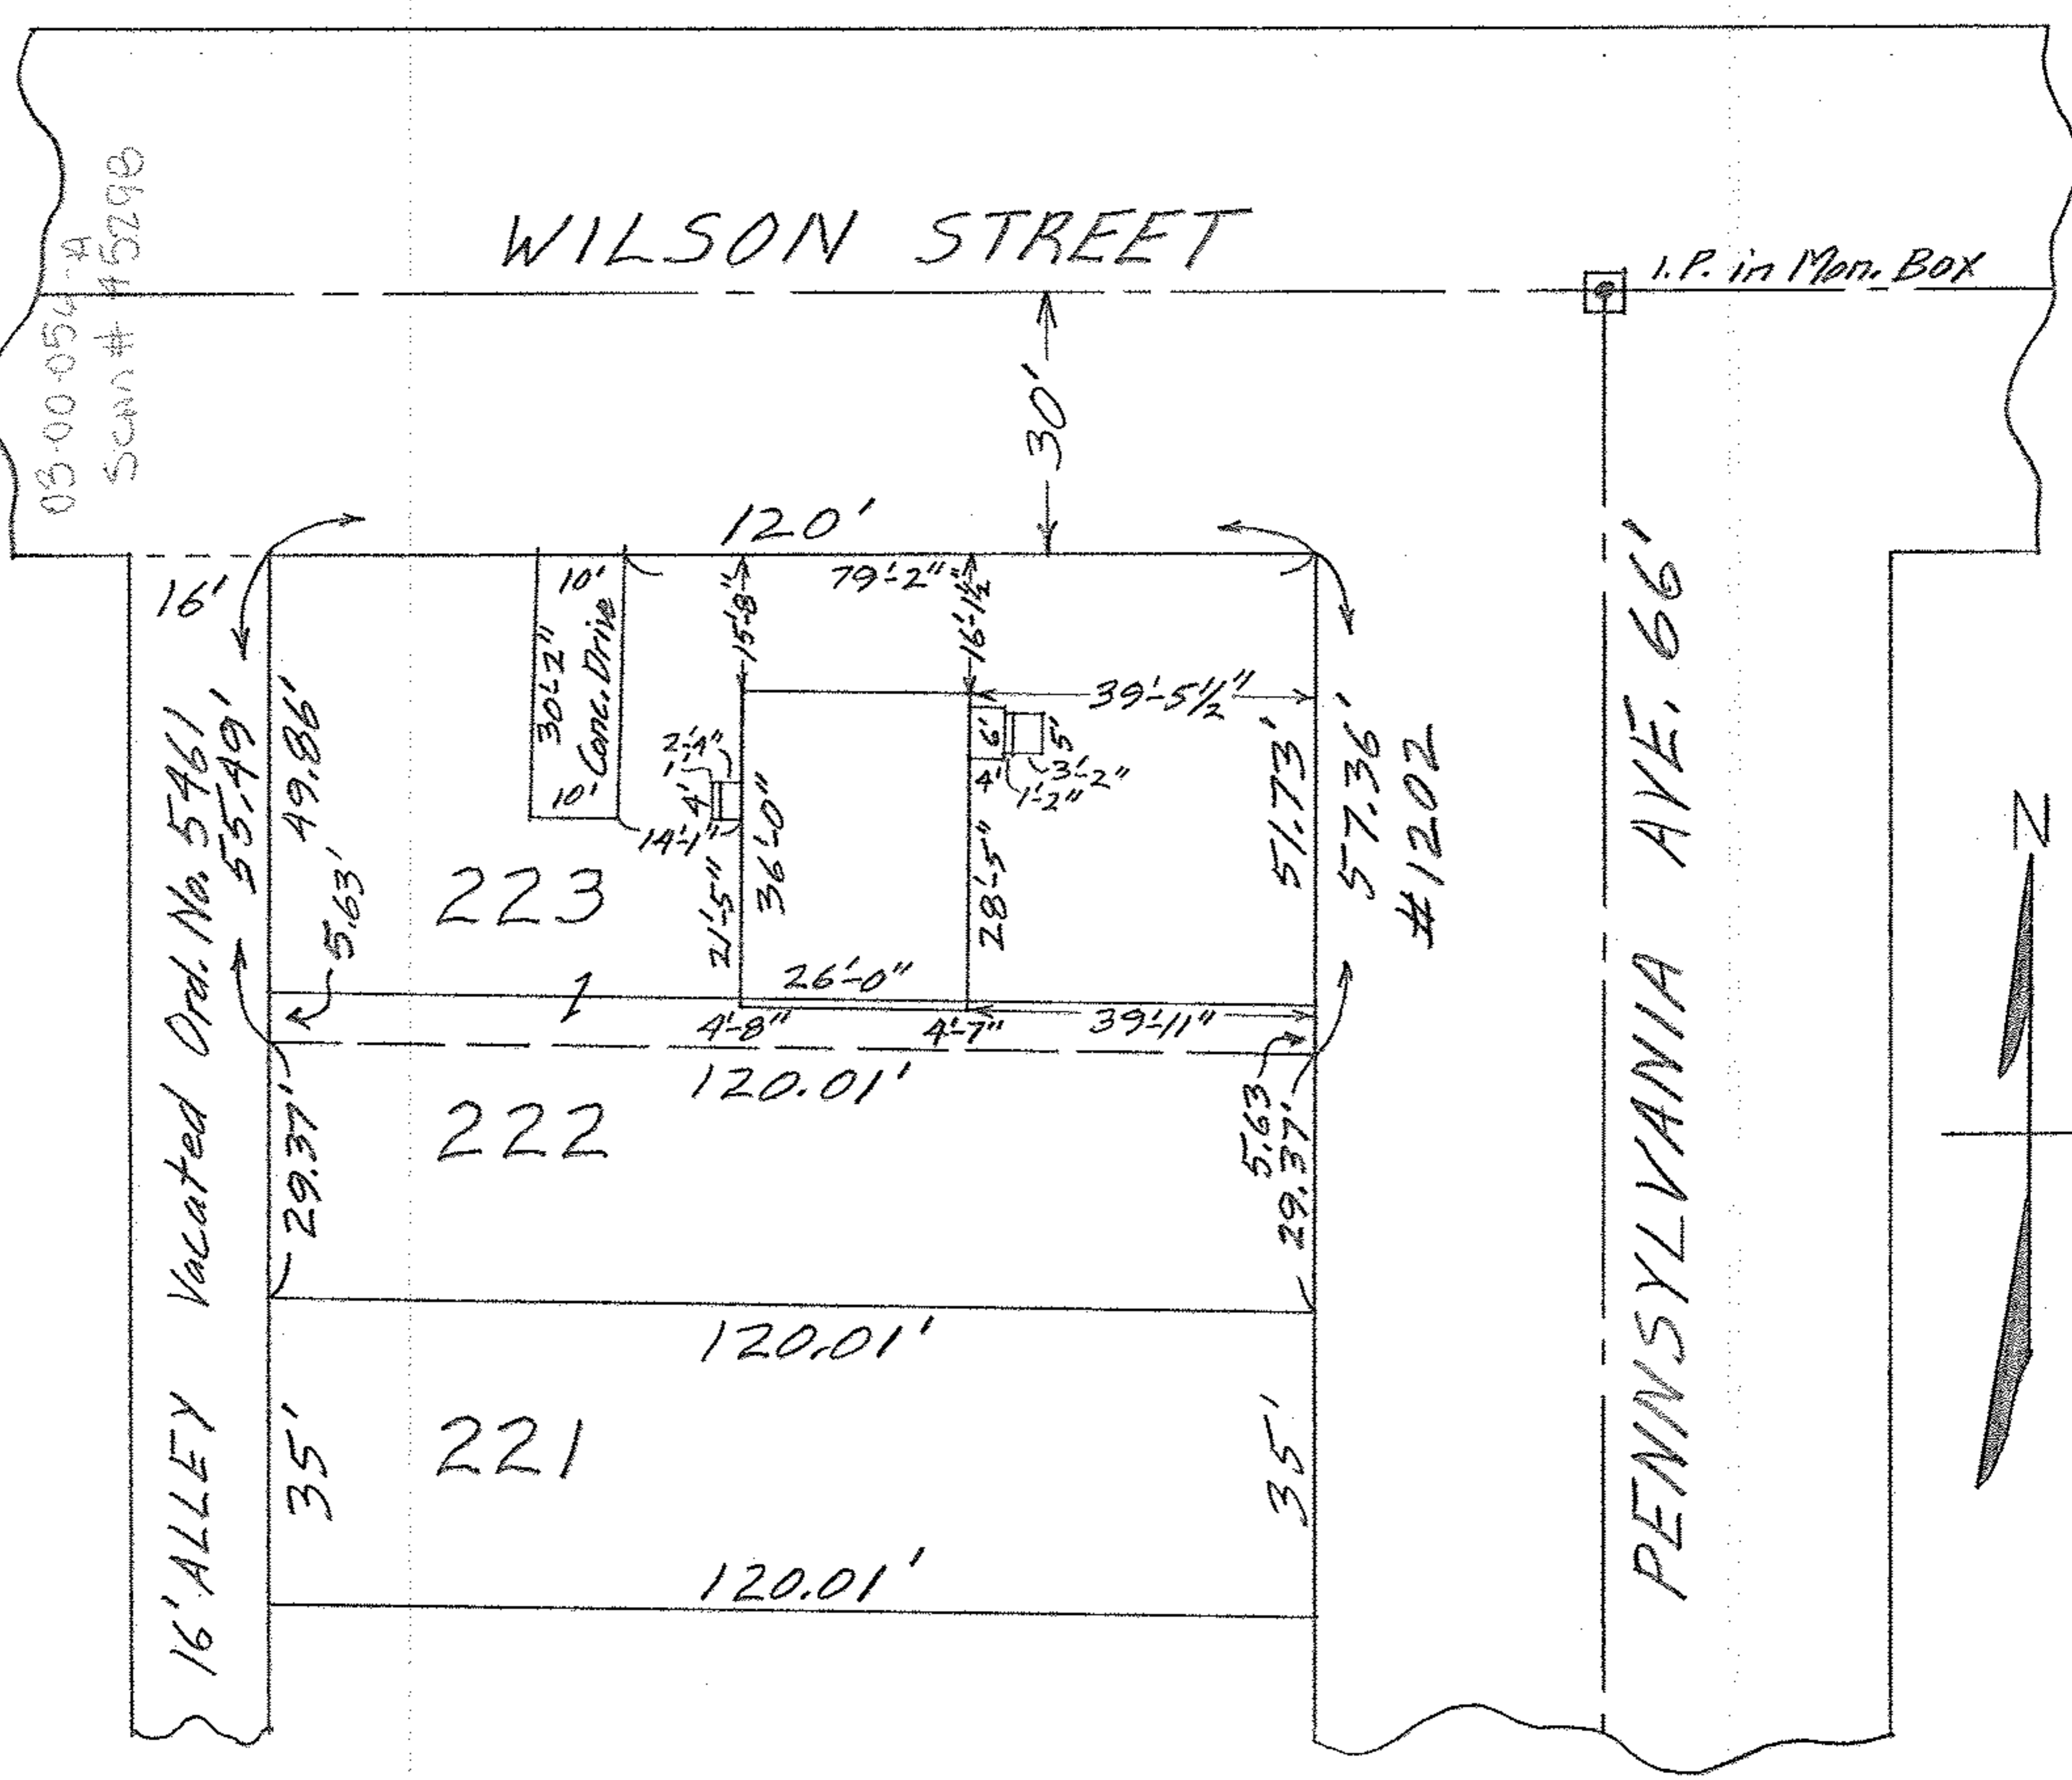

MAP OF SUB-LOT NO. 223 AND NORTHERLY  
 5.63 FEET OF SUB-LOT NO. 222 IN  
 LARKMOOR SUB'N. Vol. 9 Pg. 20 PLATS  
 ORIG. LOT 56 SHEFFIELD TWP.  
 LORAIN CITY - LORAIN COUNTY - OHIO  
 SCALE: 1" = 30' MAY 21-1964 6:00 P.M.  
 Gary E. Penfound REG. SURVEYOR  
 #29004 Donald William Bischoff & Patricia A. Bischoff