
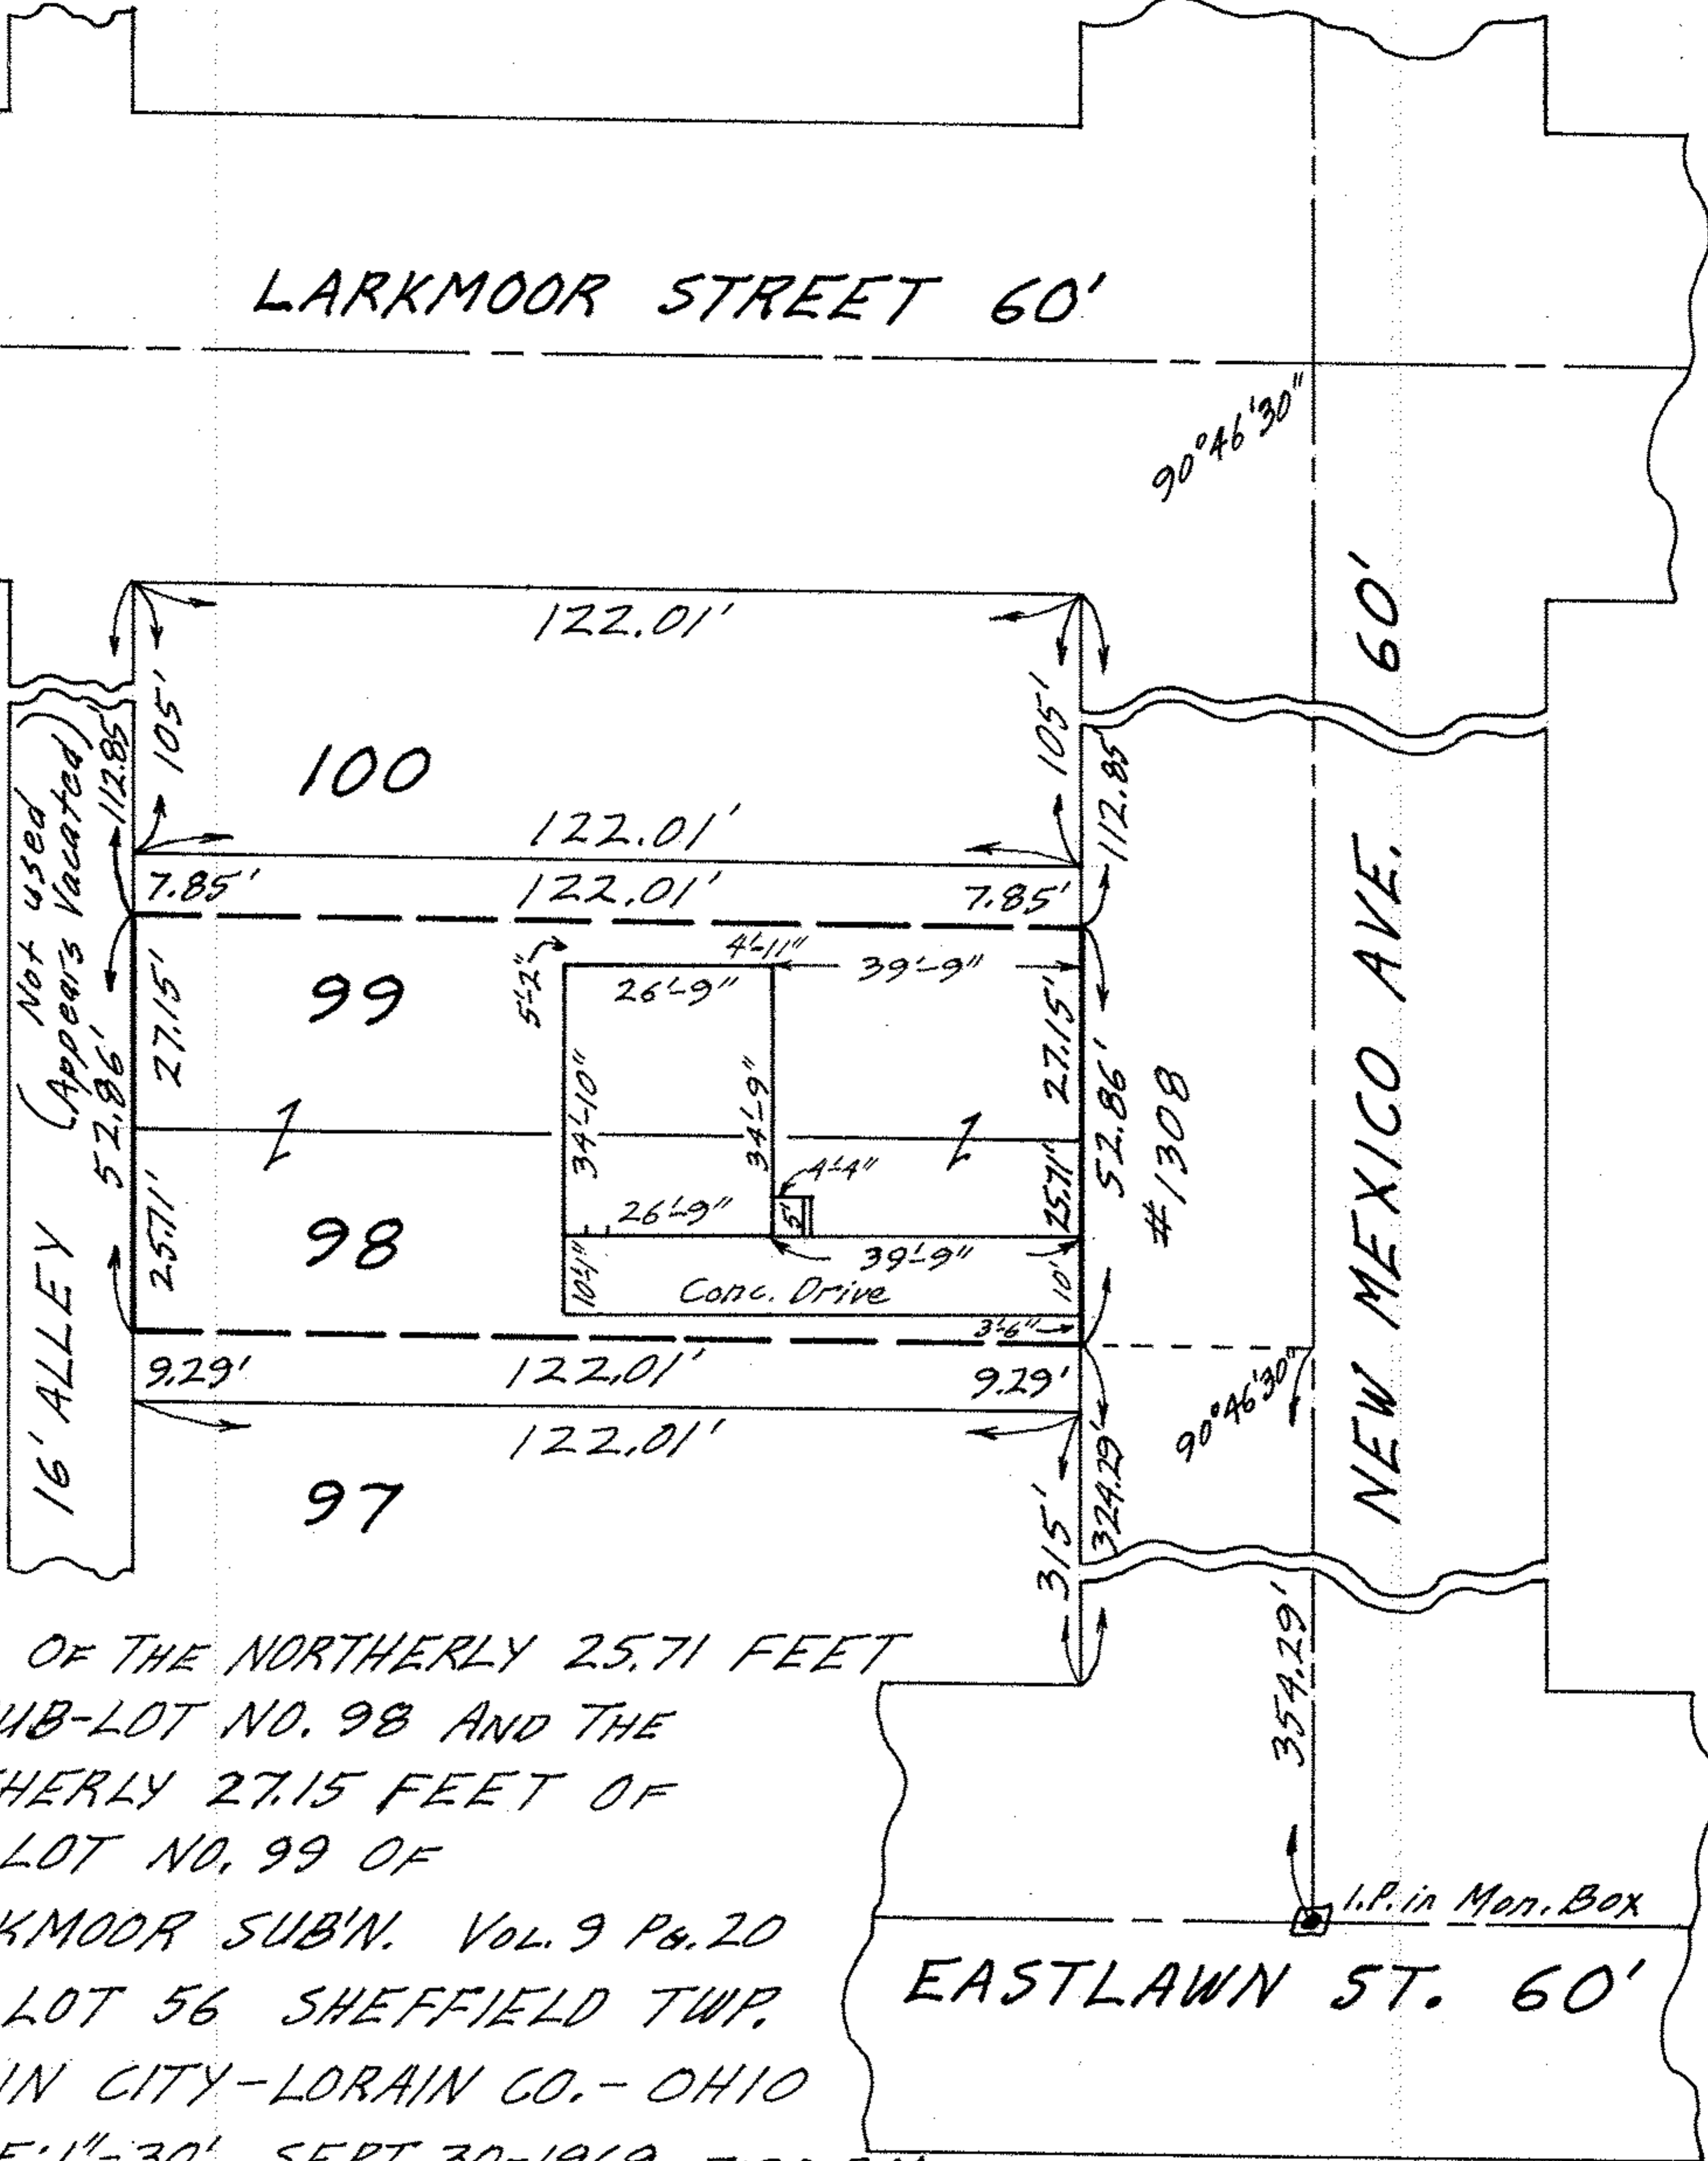


03-00-056-107-014
 03-00-056-A
 SCAN # 45249

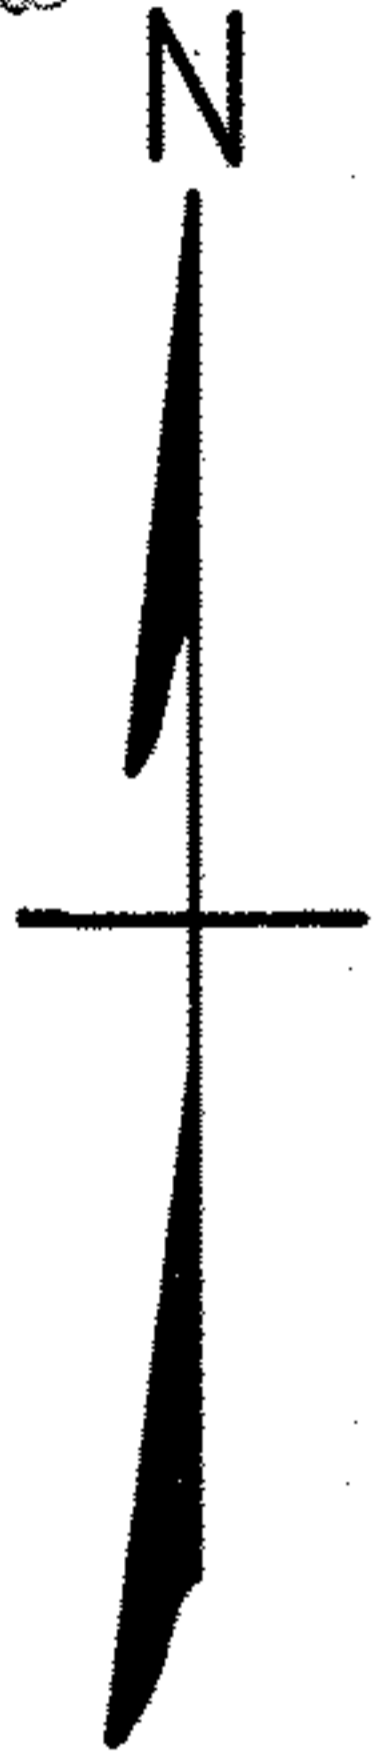

MAP OF THE NORTHERLY 25.71 FEET
 OF SUB-LOT NO. 98 AND THE
 SOUTHERLY 27.15 FEET OF
 SUB-LOT NO. 99 OF
 LARKMOOR SUB'N. Vol. 9 Pg. 20
 ORIG. LOT 56 SHEFFIELD TWP.
 LORAIN CITY-LORAIN CO.- OHIO
 SCALE: 1"=30' SEPT. 30-1969 7:30 P.M.

NOTE: There are no encroachments on the above property.

Gary E. Penfound REG. SURVEYOR NO. 4457

CITY TITLE Co. Order No. E-862-3

Edward D. & Grace H. Jones to John J. & Susan F. Zaborowski