



03-00-056-122-002, 001  
03-00-056-A

SCAN #45302

Mon. Box

RANDALL STREET 60'

NEW MEXICO AVE. 60'

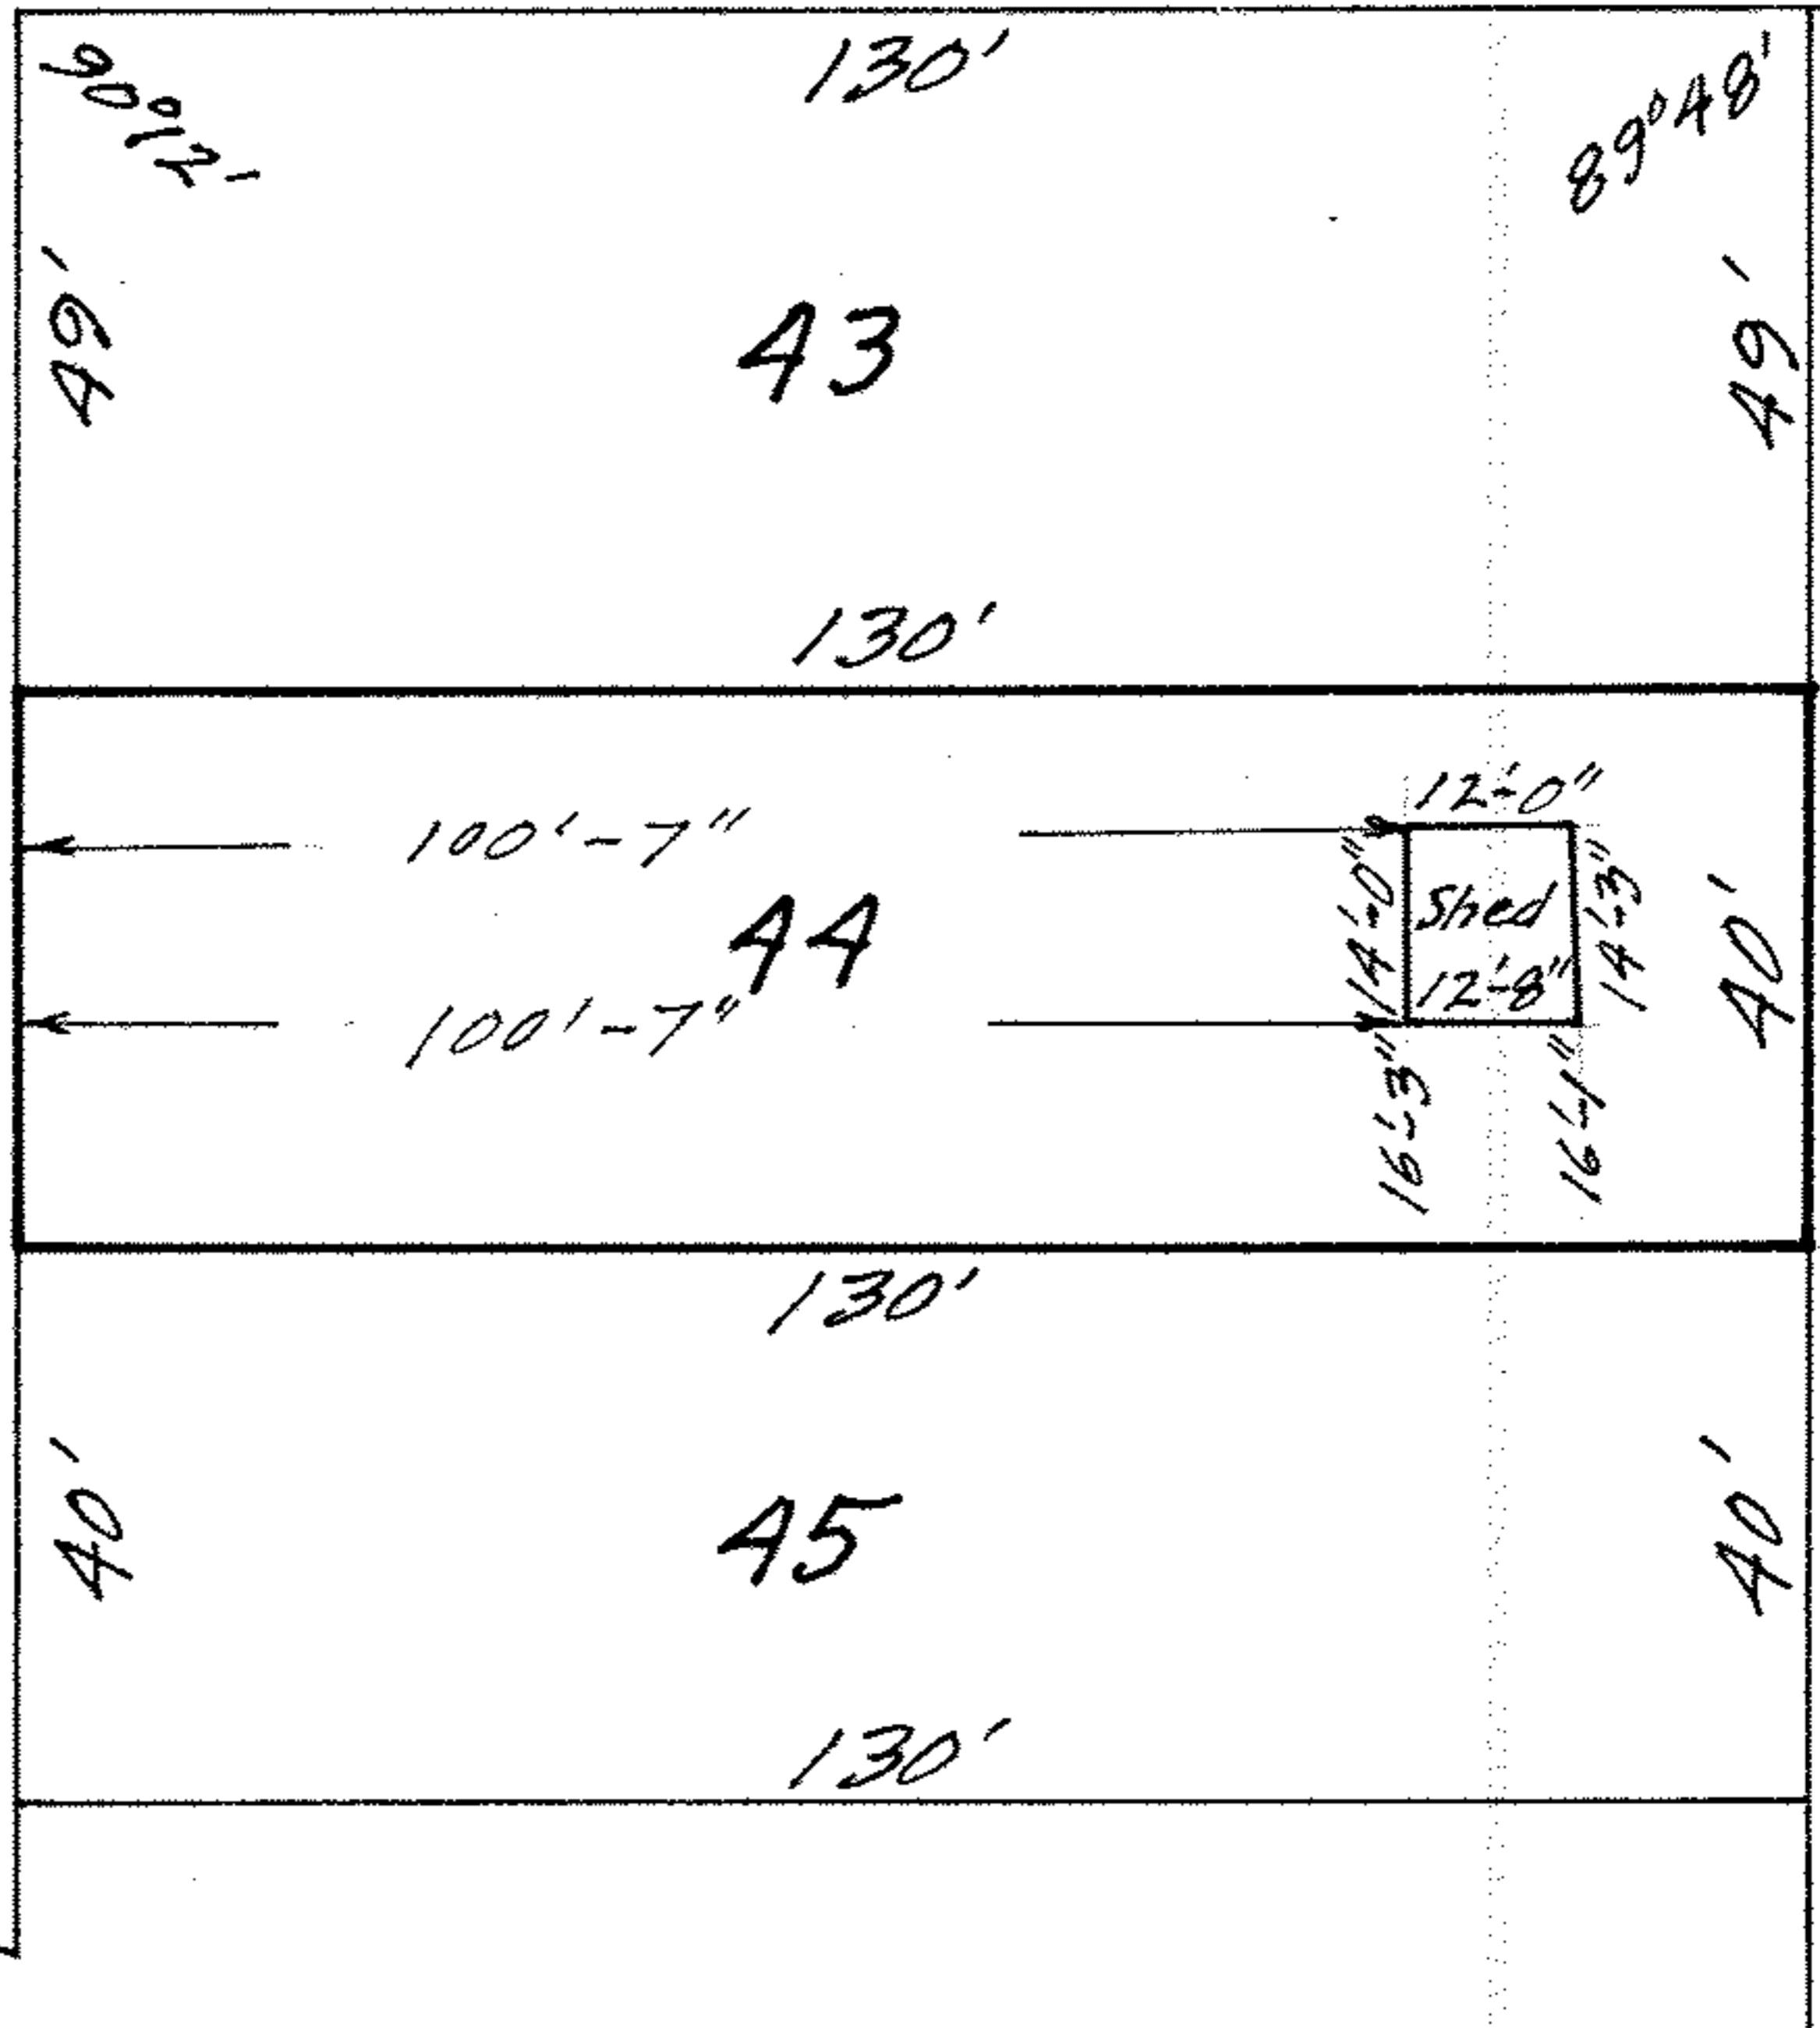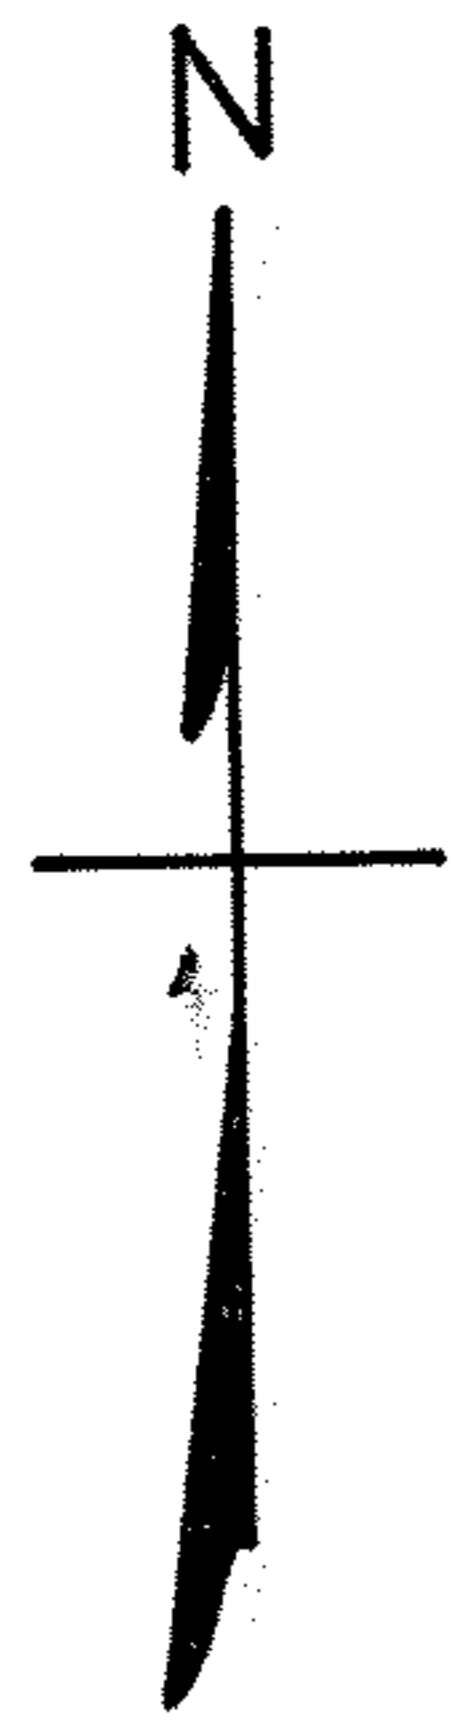

MAP OF SUB-LOT NO. 44

C. J. CREHORE'S FIRST ALL'T. Vol. 9 Pg. 1  
 ORIG. LOT 56 SHEFFIELD TOWNSHIP  
 LORAIN CITY - LORAIN COUNTY - OHIO  
 SCALE: 1" = 30' JULY 31-1969 5:30 P.M.  
 Gary E. Penfound REG. SURVEYOR

Frank & Rosamond Calabrese