


03-00-056-123-009, 010
03-00-056-A
SCAN #45303

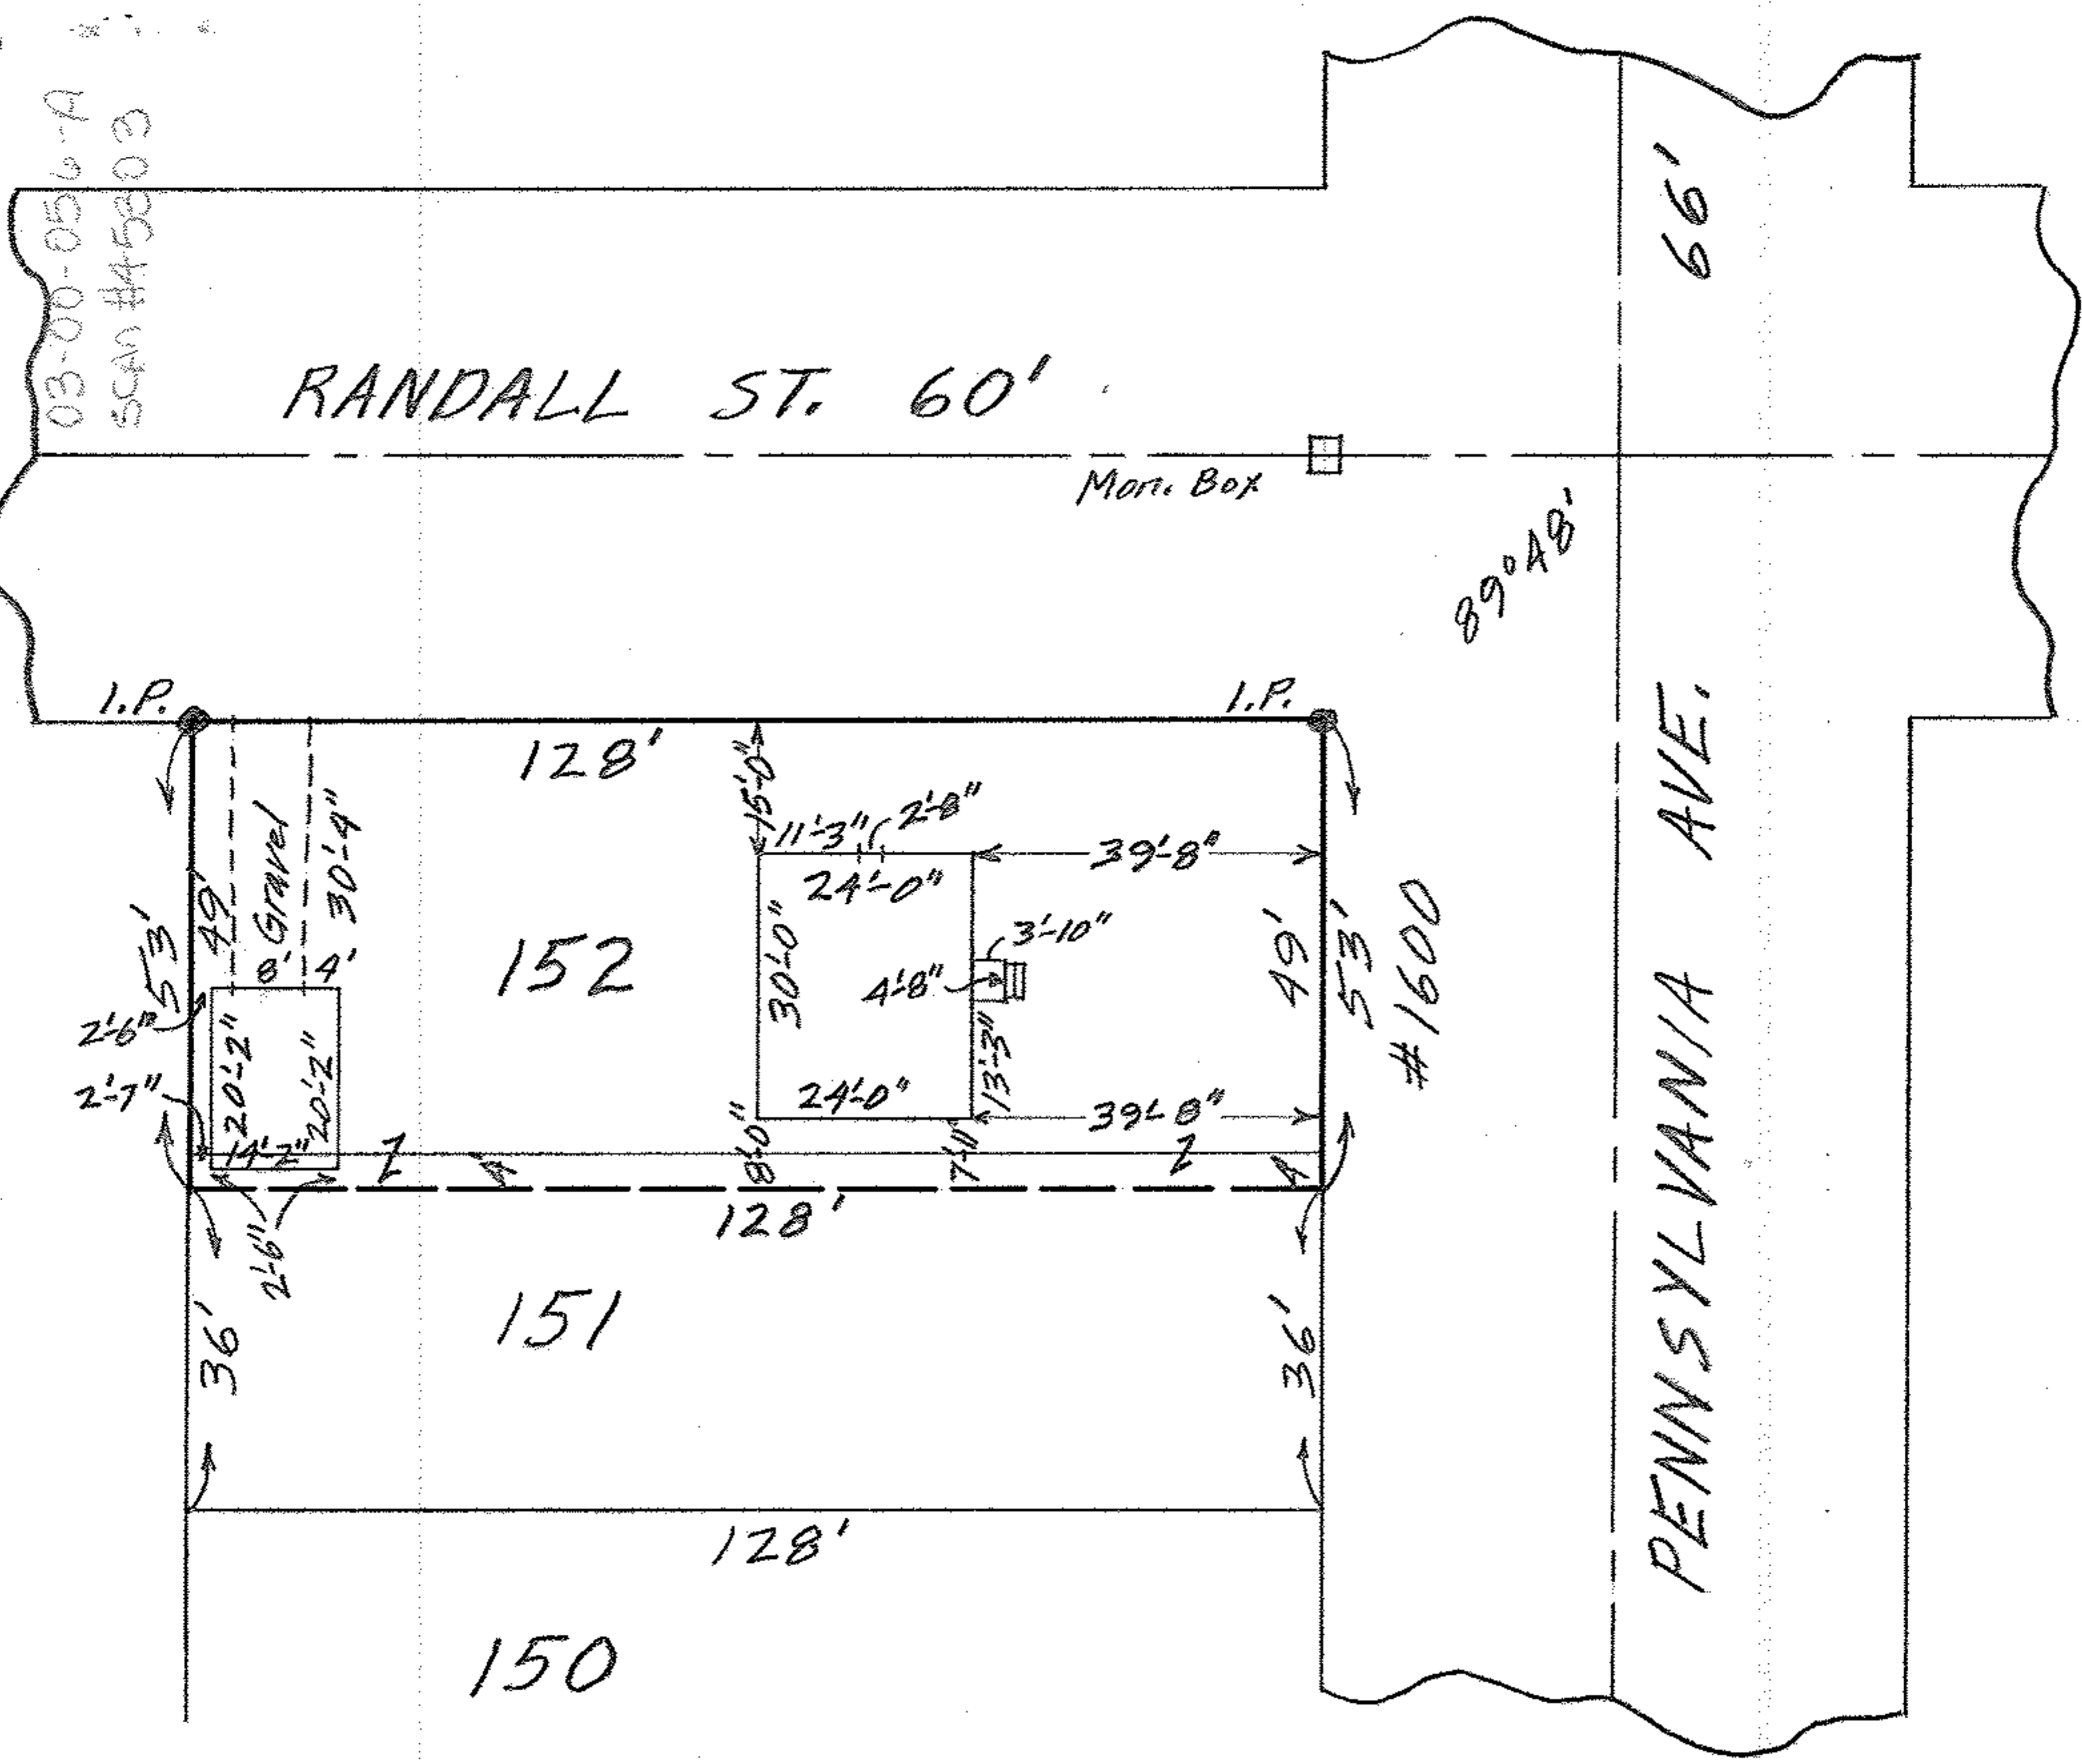

MAP OF SUB-LOT NO. 152 AND THE
 NORTHERLY 4 FEET OF SUB-LOT NO. 151
 C. J. CREHORE'S THIRD ALL'T. Vol. 9 Pg. 18
 ORIG. LOT NO. 56 SHEFFIELD TWP.
 LORAIN CITY - LORAIN COUNTY - OHIO
 SCALE: 1" = 30' DEC. 2-1965 12:30 P.M.
 Gary E. Penfound REG. SURVEYORS
 for C. E. Penfound

GL-1382 James R. & Sara Stokes

