


03-00-057-103-022
 03-00-057-103-022
 Scan # 45300

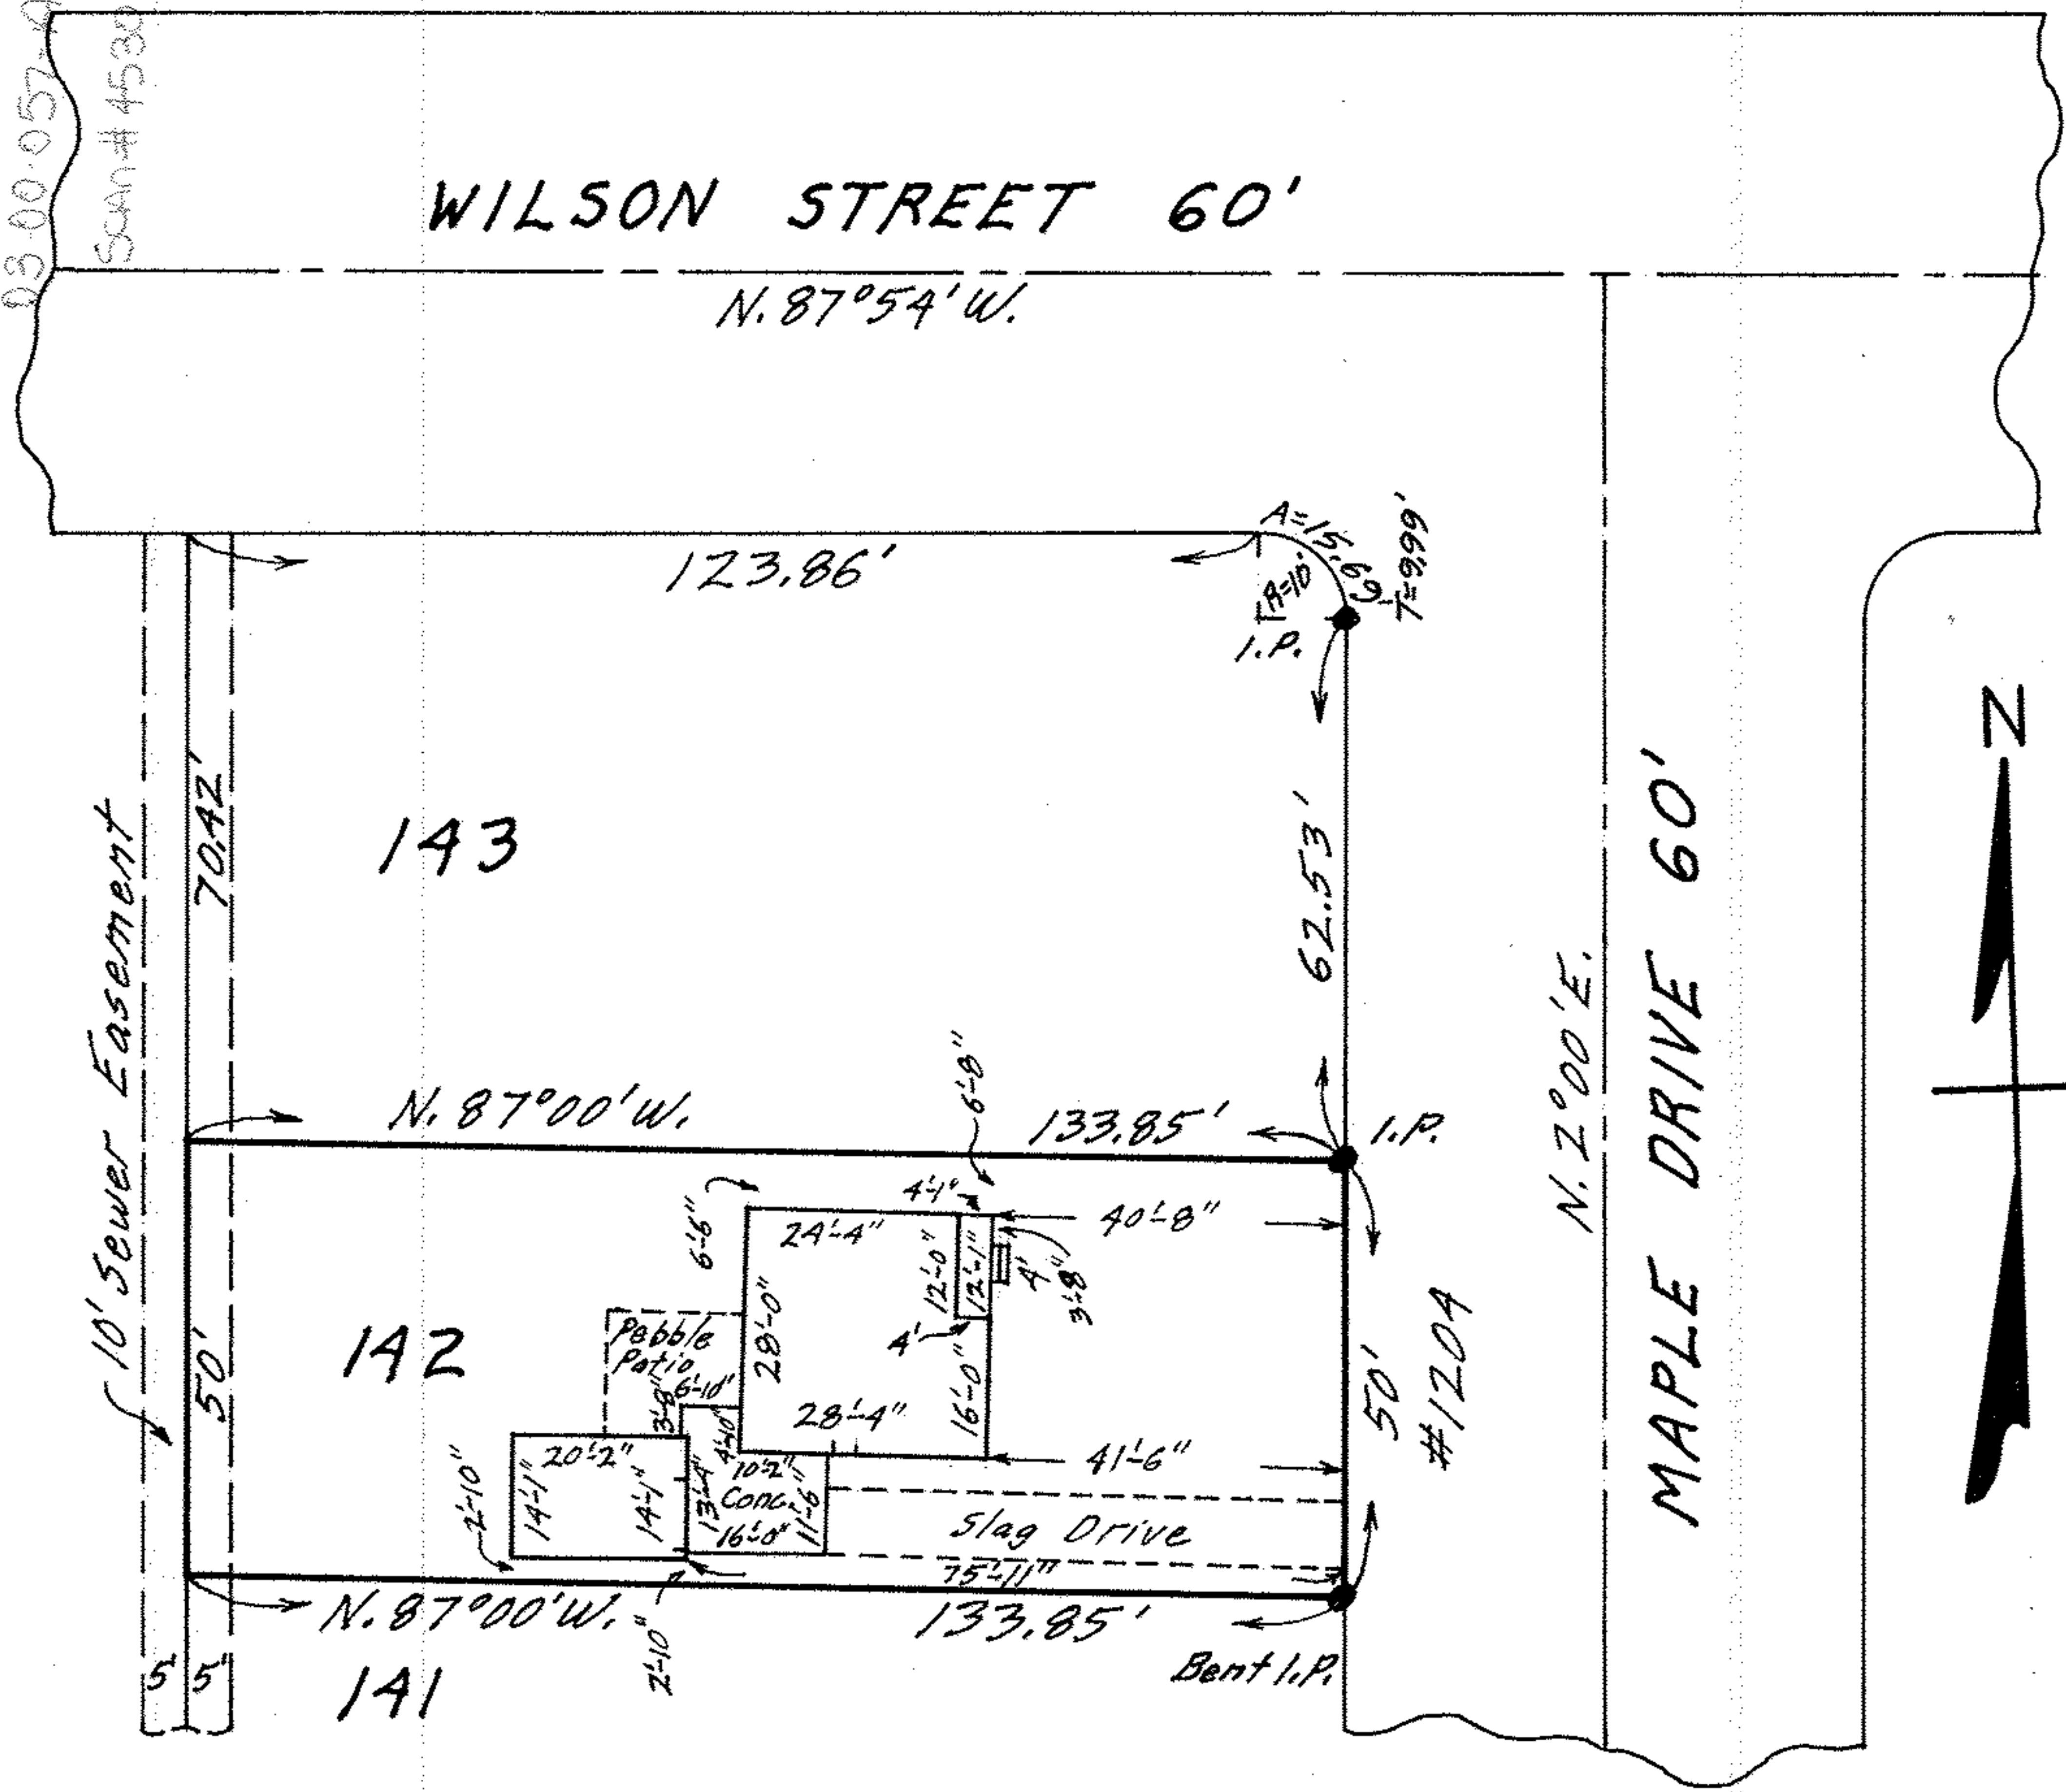

MAP OF SUB-LOT NO. 142
 MAPLE HEIGHTS SUB'N. NO. 3 VOL. 15 PG. 35
 ORIG. LOT NO. 57 SHEFFIELD TOWNSHIP
 LORAIN CITY LORAIN COUNTY OHIO
 SCALE: 1"=30' NOV. 29-1969 12:45 P.M.
 NOTE: There are no encroachments on this property.
 Gary E. Penfound REG. SURVEYOR NO. 4457
 CITY TITLE CO. Order No. E-961-2
 Donald W. & Elizabeth Ann Hurd
 to Ernest G. & Eileen R. Haupt