


03-00-057-103-024
03-00-057-A

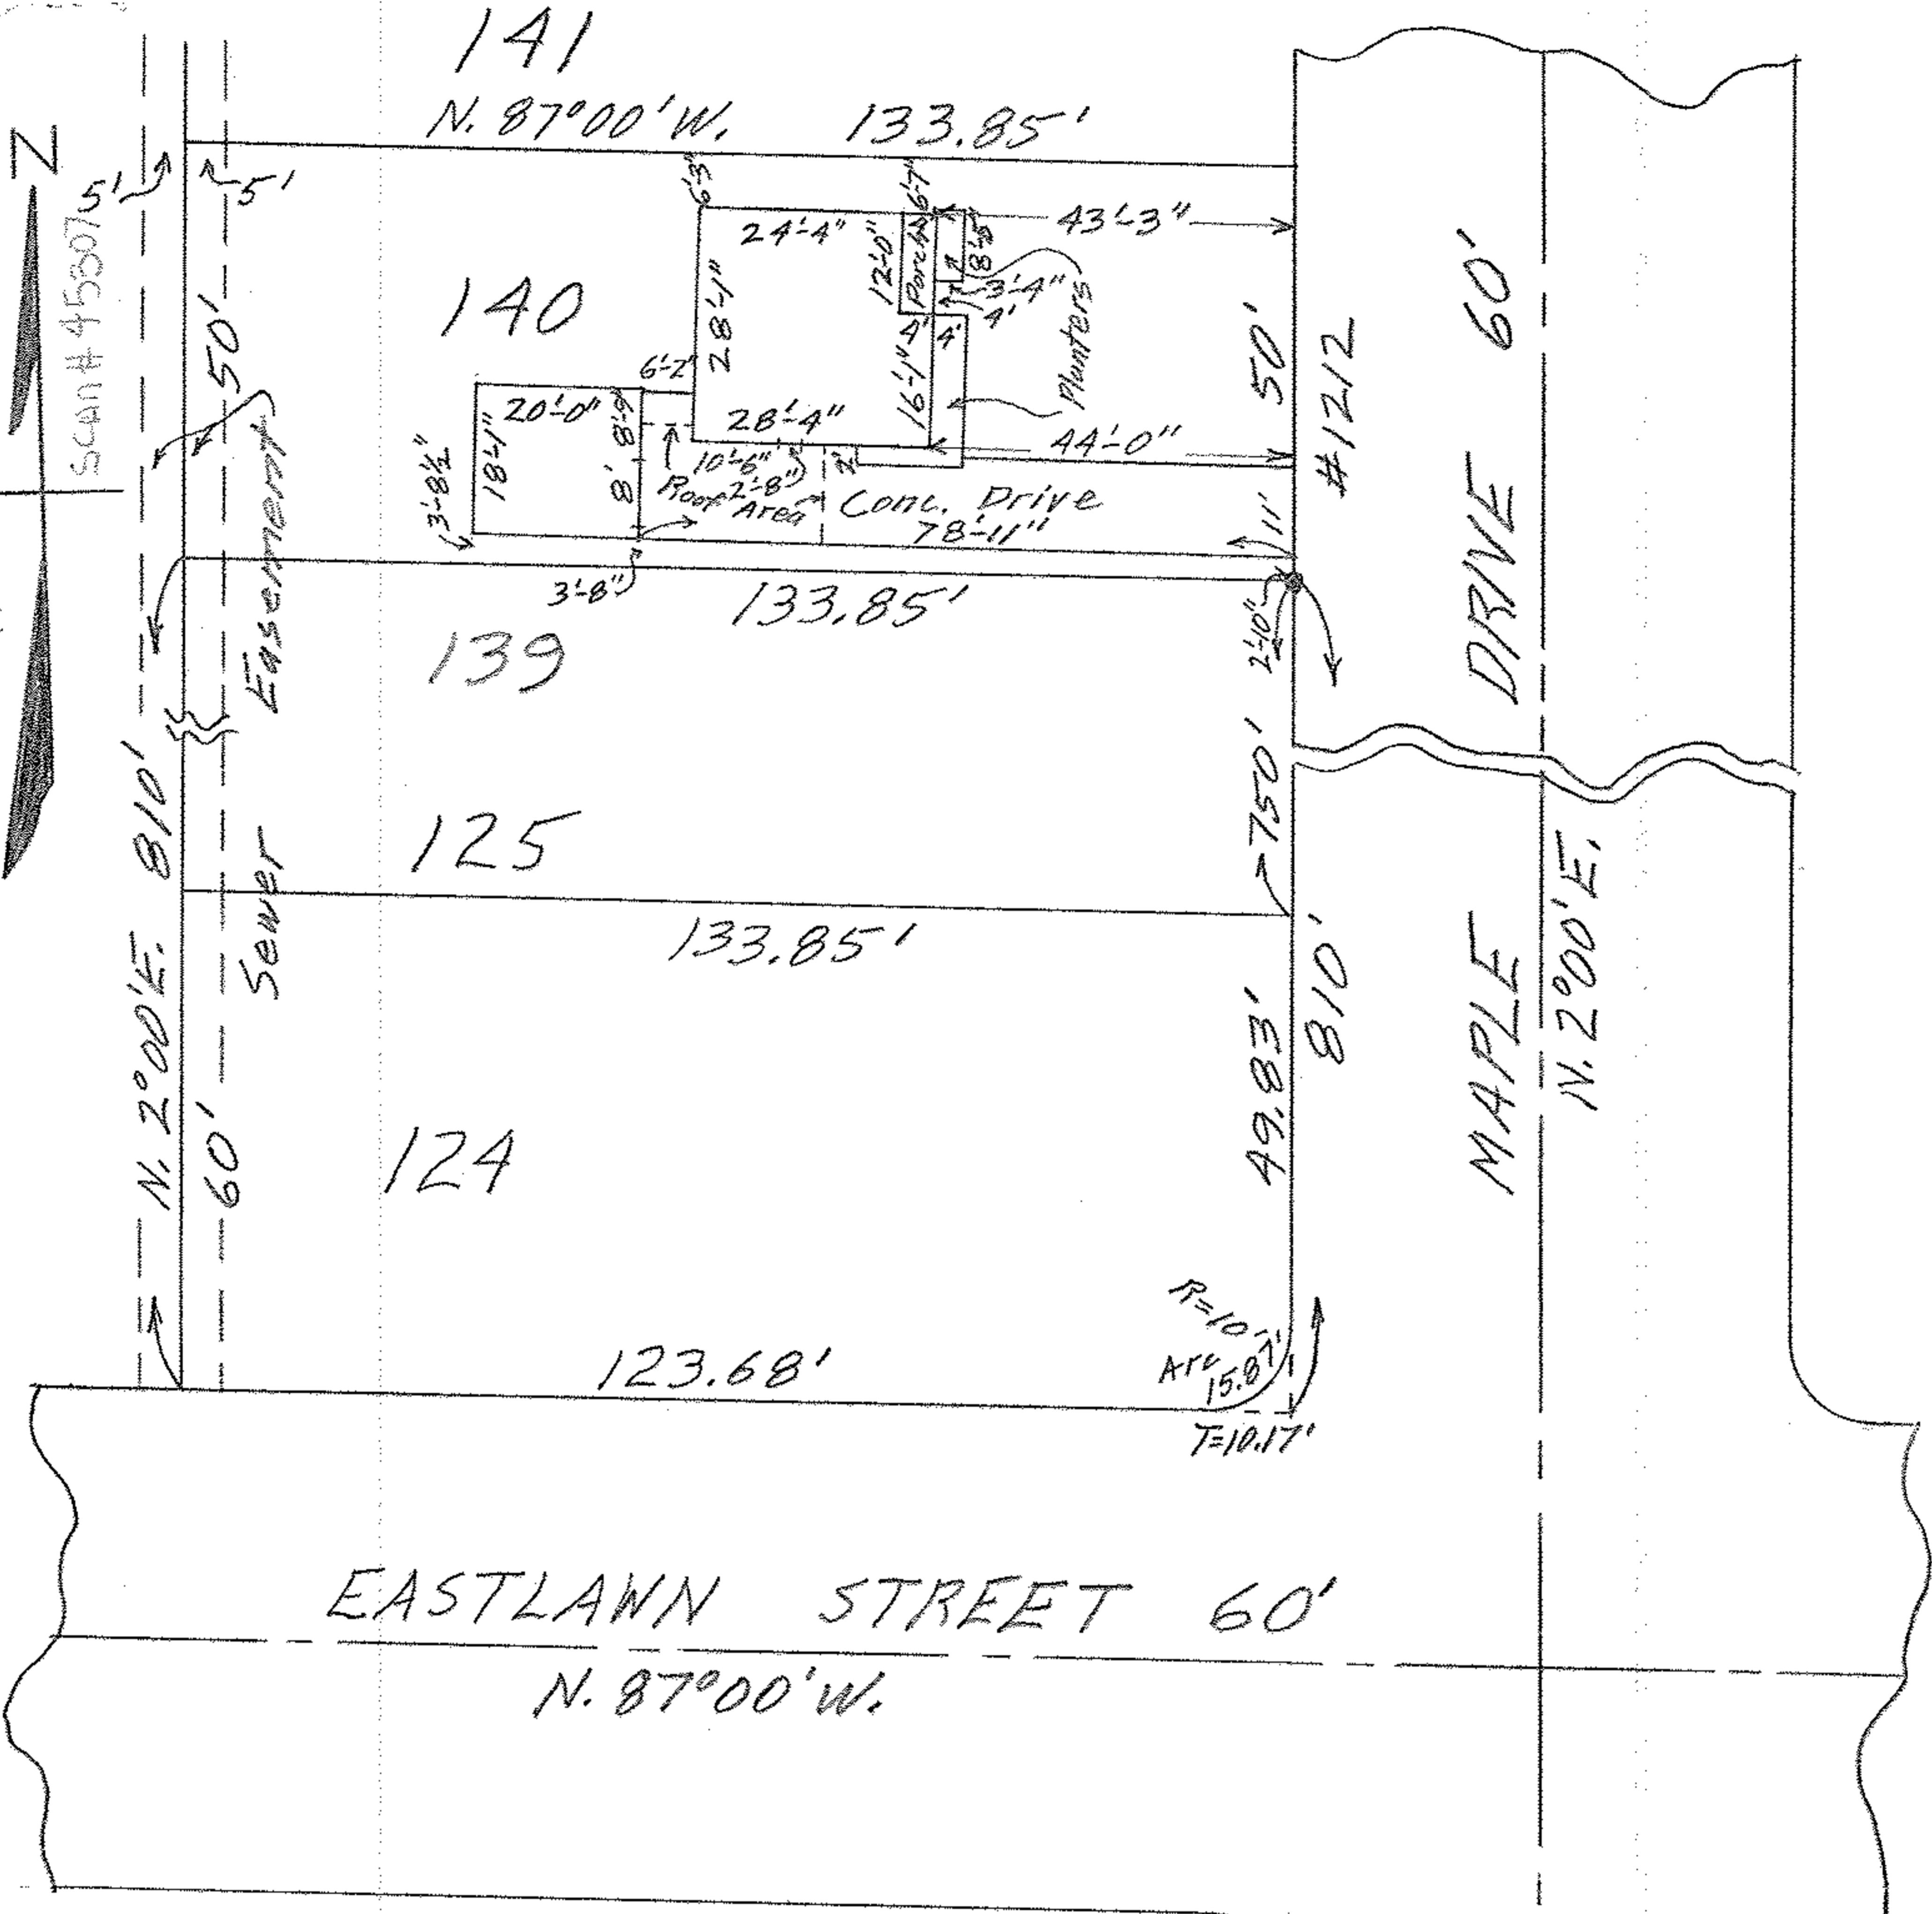

MAP OF SUB-LOT NO. 140
 MAPLE HEIGHTS SUB'N. NO. 3 VOL. 15 PG. 35
 O. L. 57 SHEFFIELD TWP. - LORAIN CITY
 LORAIN COUNTY - OHIO
 SCALE: 1"=30' SEPT. 3-1963 3:00 P.M.
 Mary E. Penfound REG. SURVEYOR
 Paul E. & Mary E. Virtue BH