


03-00-063-000-015  
 03-00-063 Scan # 45308

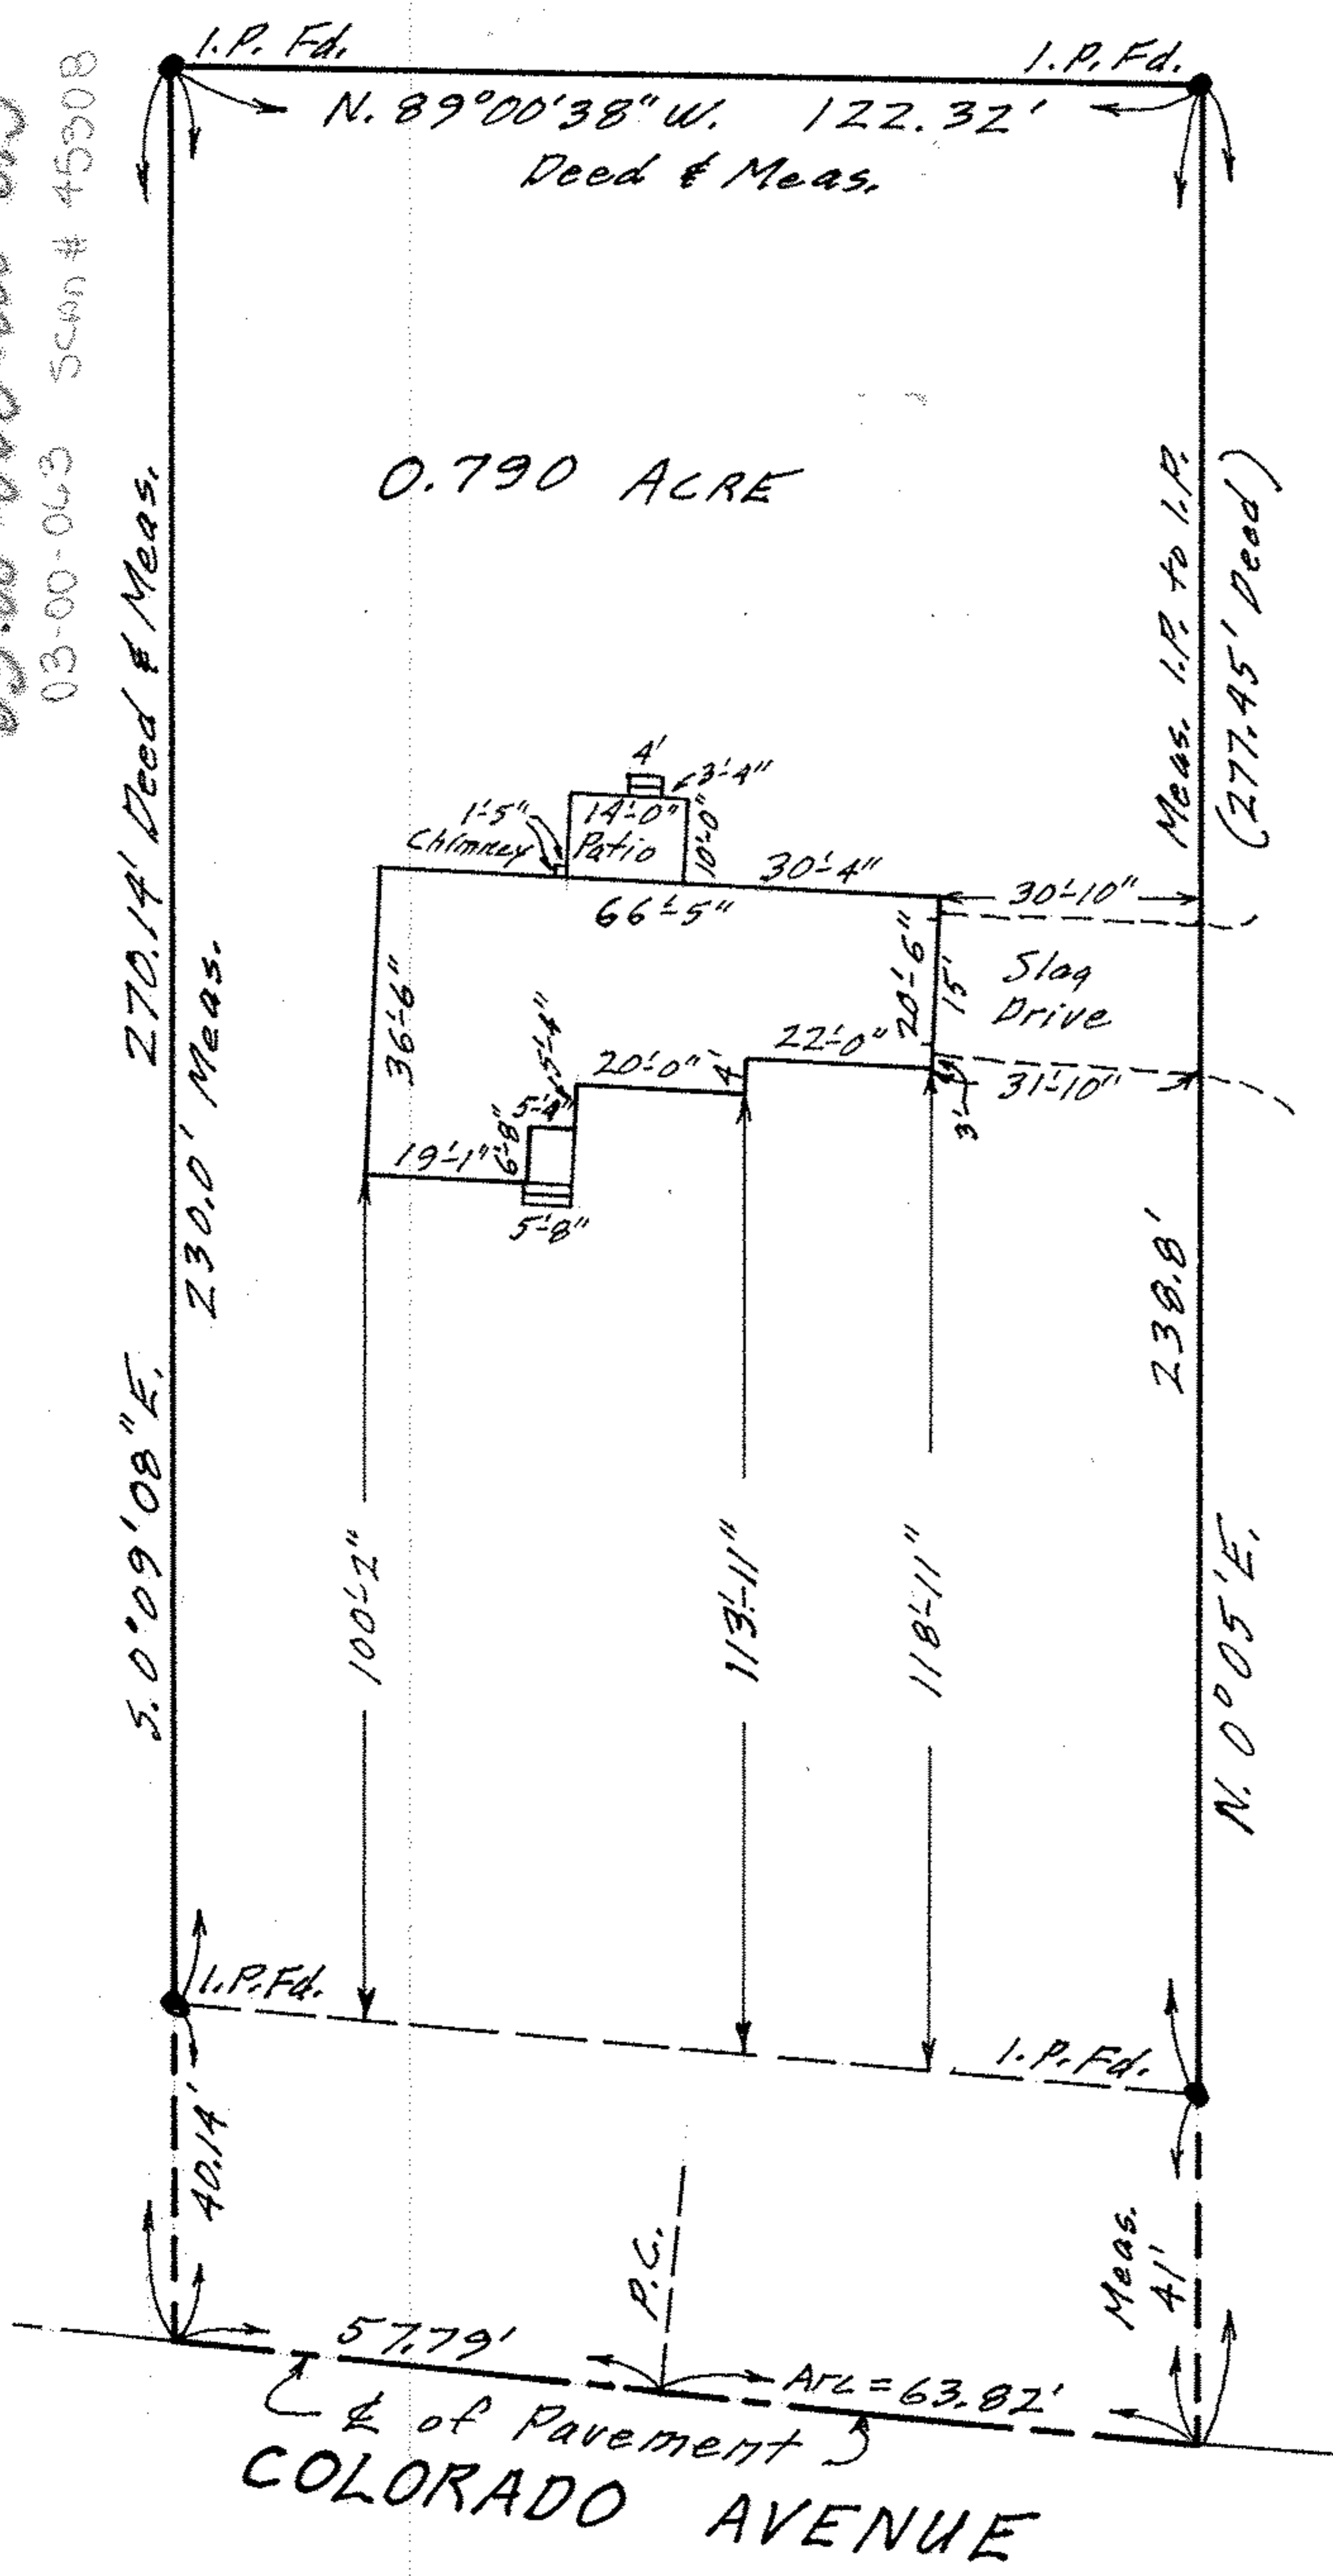

MAP OF PART OF ORIG. LOTS 63 & 64  
 SHEFFIELD TOWNSHIP - SHEFFIELD VILLAGE  
 LORAIN COUNTY OHIO  
 SCALE: 1" = 30' MAR. 19-1968 12:15 P.M.  
 Gary E. Penfound REG. SURVEYOR

John & Emily Fabanich