


03-00-078-103-010  
 03-00-077-A  
 SCND# 45316

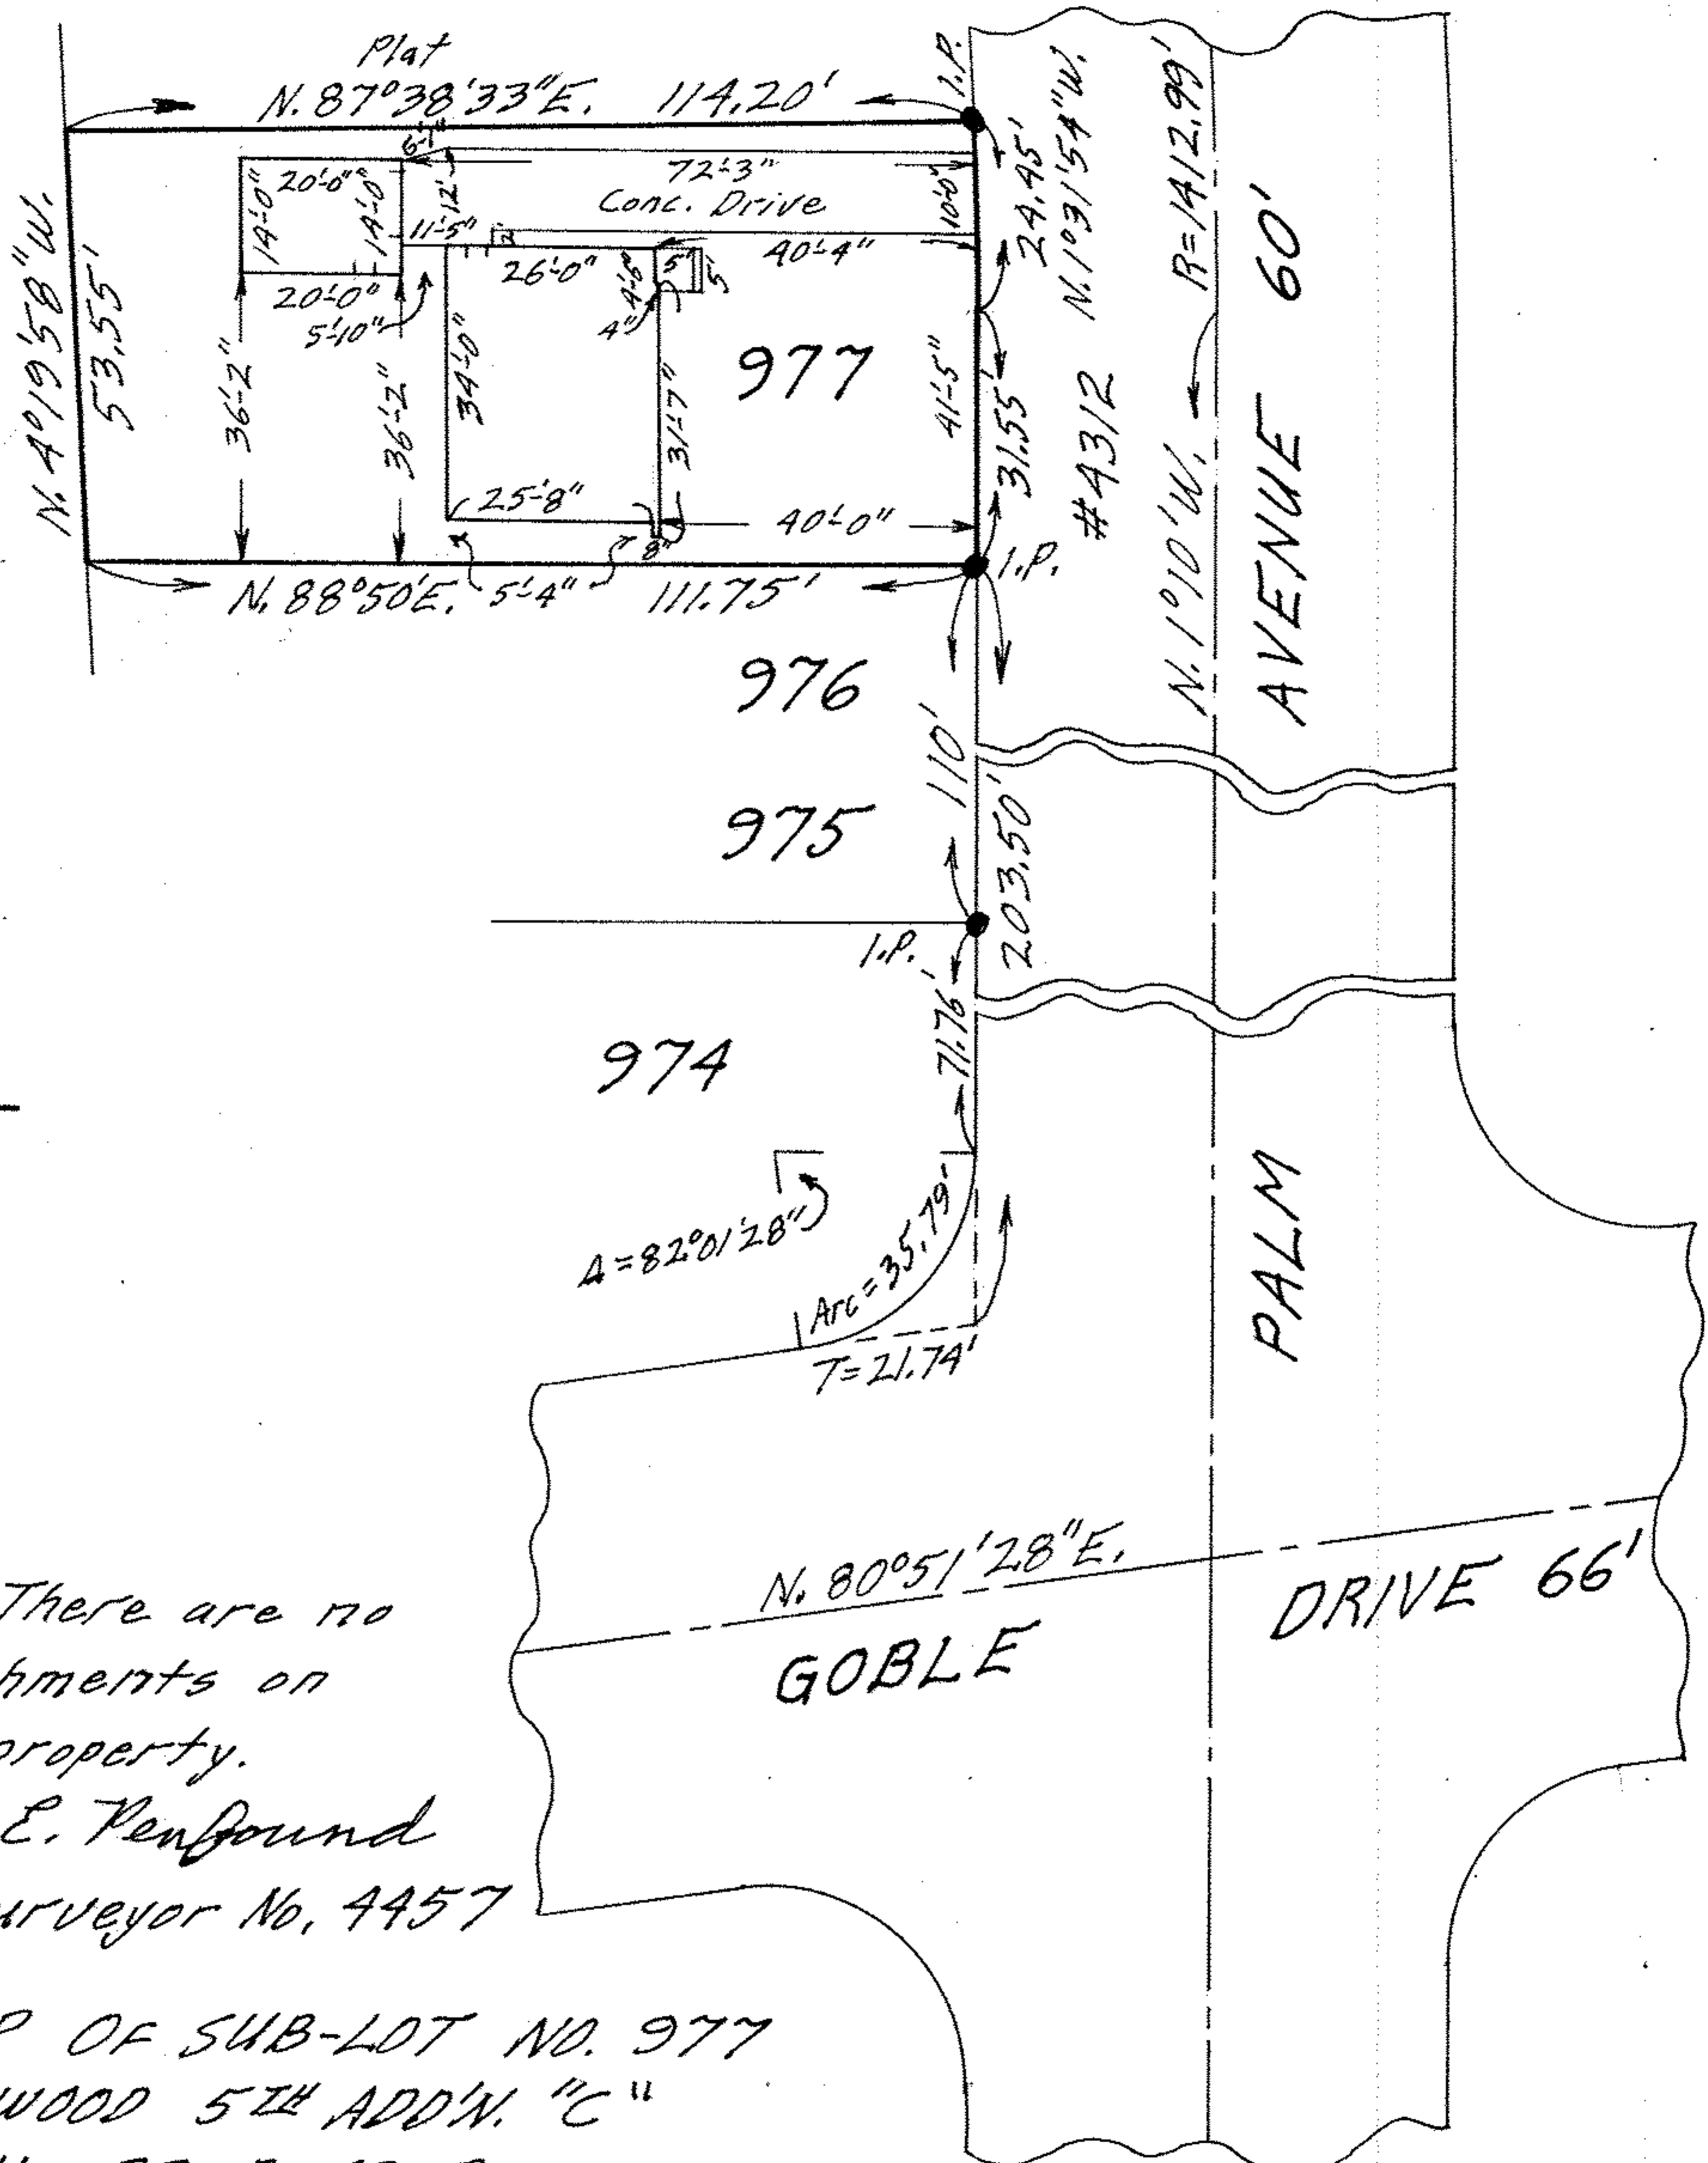

NOTE: There are no encroachments on this property.

Gary E. Penfound  
 Reg. Surveyor No. 4457

MAP OF SUB-LOT NO. 977  
 HOMEWOOD 5TH ADD'N. "C"  
 Vol. 22 Pg. 62 PLATS  
 O.L.'S 78 & 79 SHEFFIELD TWP.  
 LORAIN CITY - LORAIN COUNTY - OHIO  
 SCALE: 1"=30' JAN. 9-1972 1:00 P.M.  
 LOUISVILLE TITLE INS. CO. ORDER No. E-16858