


03-00-079-120-024
 03-00-079-0
 SCAN #45322

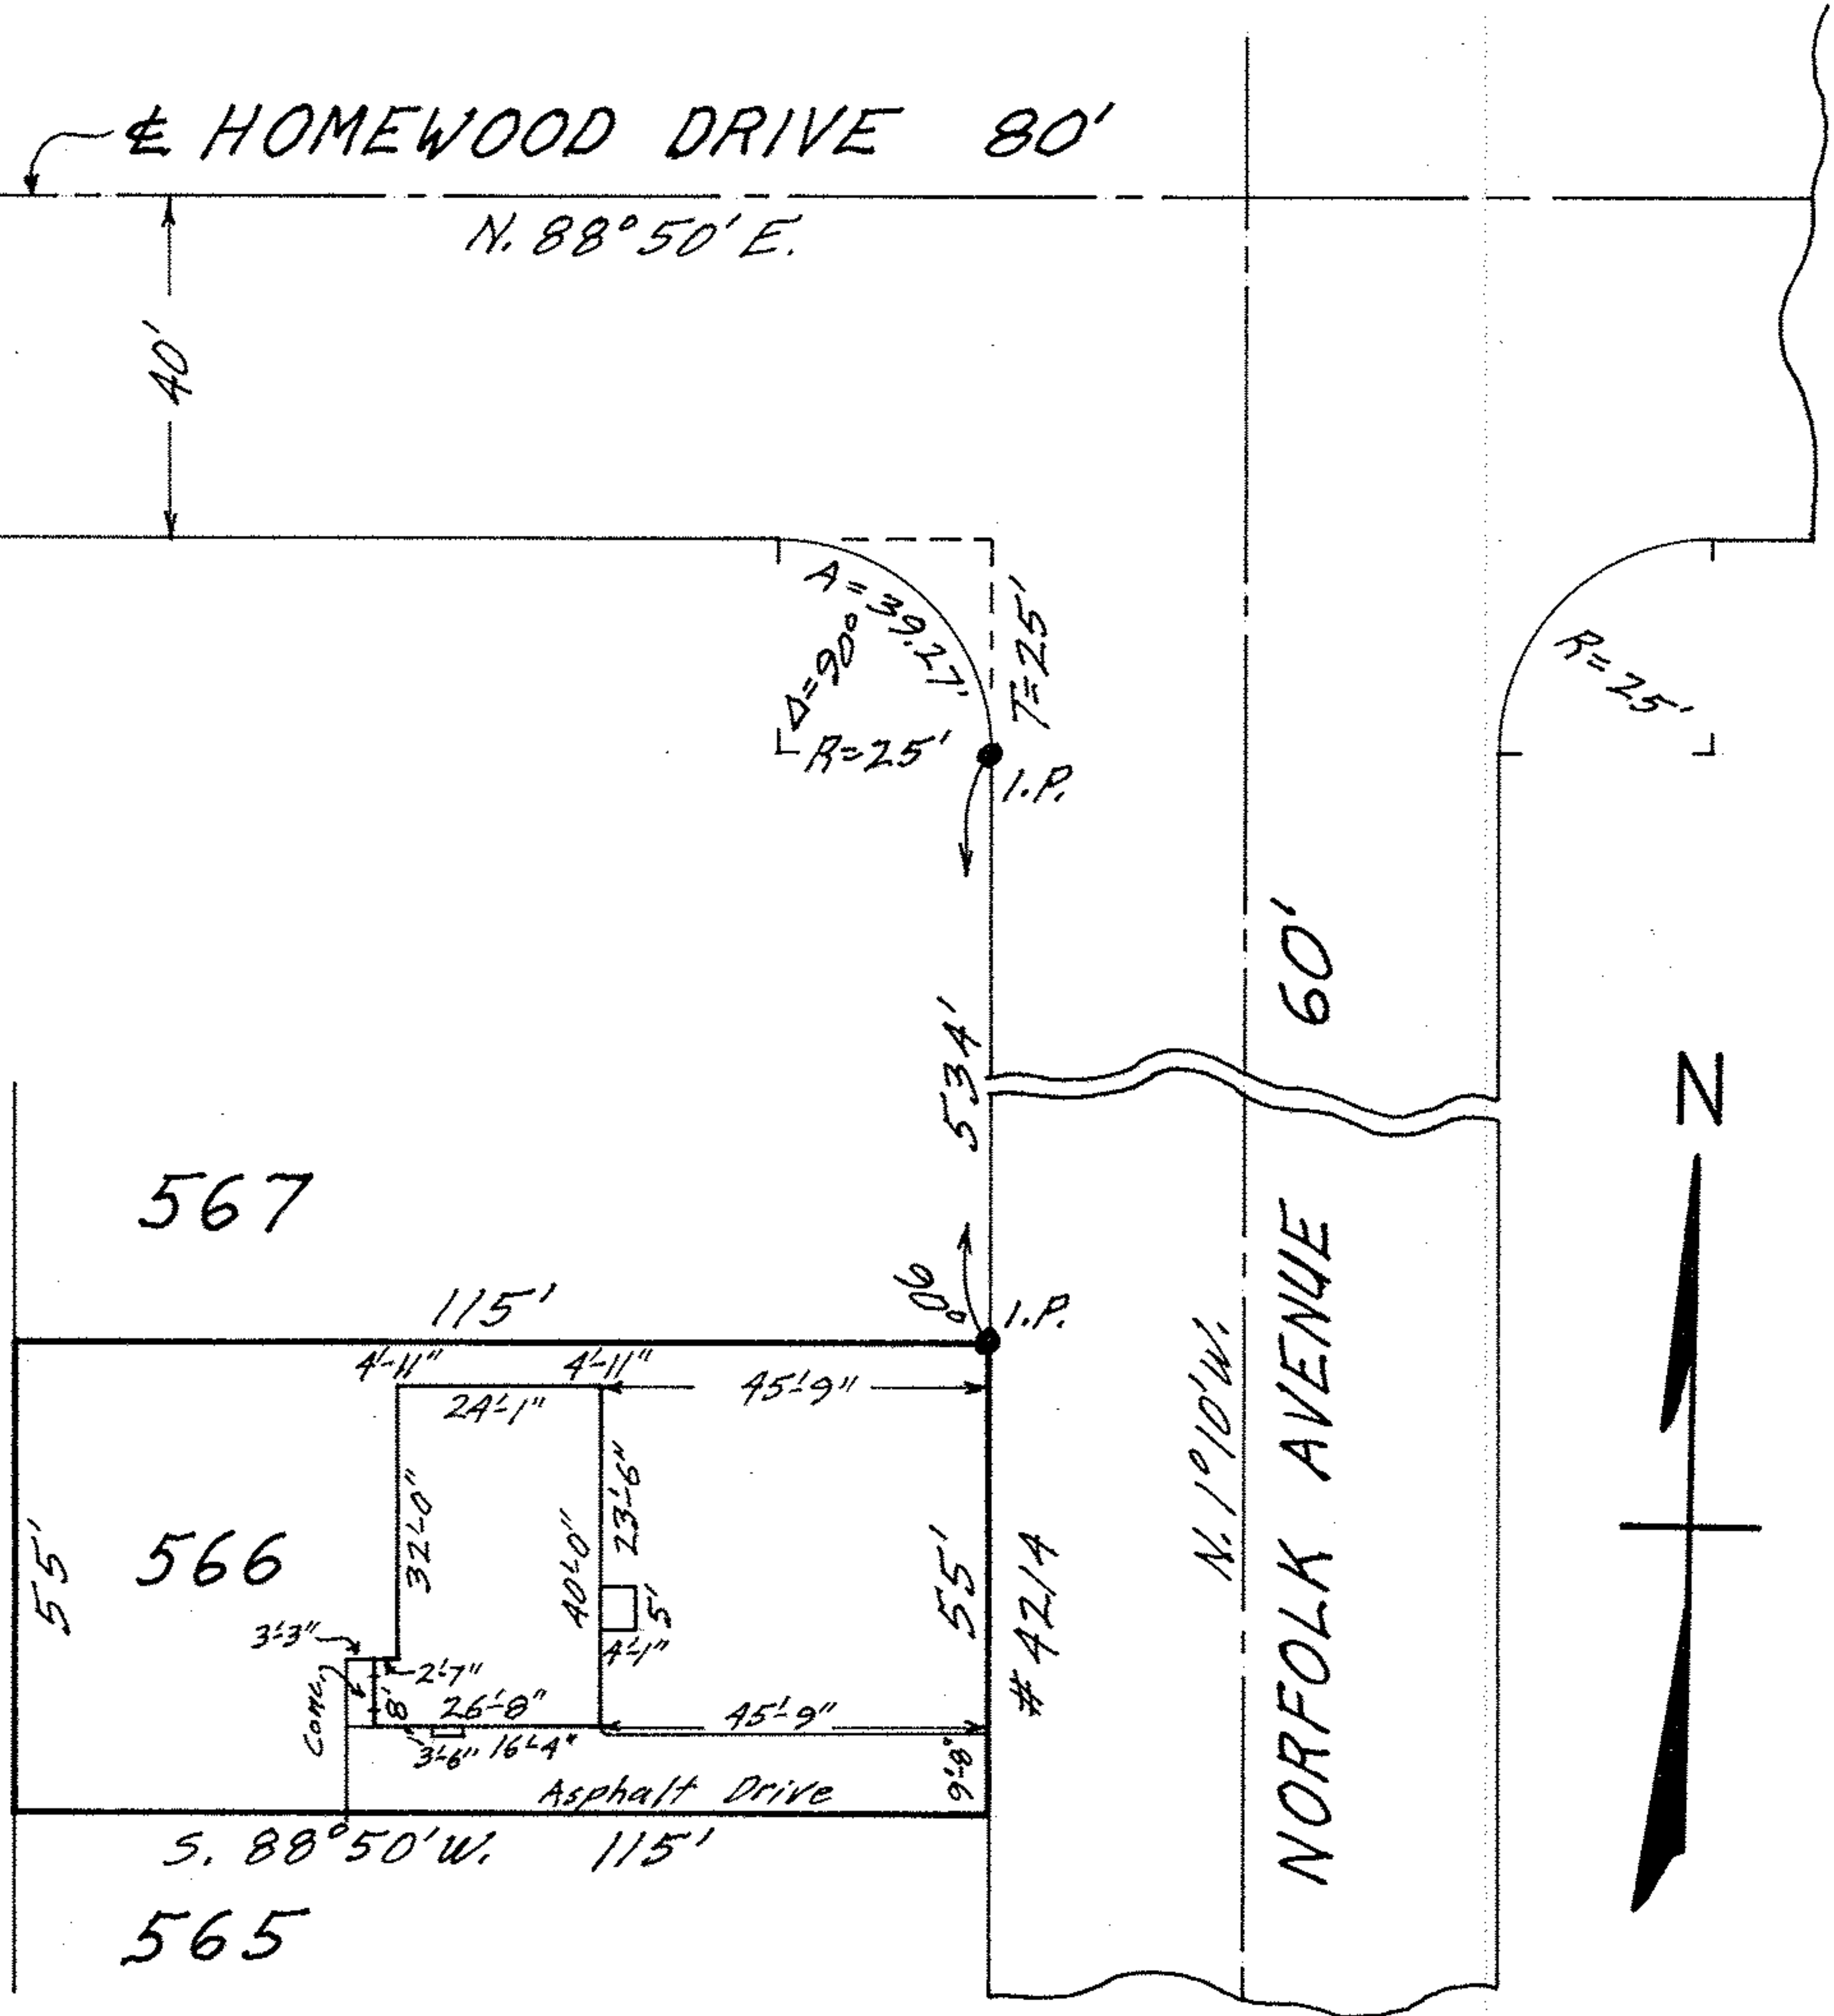

MAP OF SUB-LOT NO. 566
 HOMEWOOD SECOND ADD'N. VOL. 15 Pg. 78
 ORIG. LOT 79 SHEFFIELD TWP. - LORAIN CITY
 LORAIN COUNTY OHIO
 SCALE: 1" = 30' OCT. 20-1966 4:45 P.M.
 Gary E. Penfound REG. SURVEYOR

Robert F. & Marilyn Sue Kayle