


03-00-080-104-023
 03-00-079-A
 SCAN # 45324

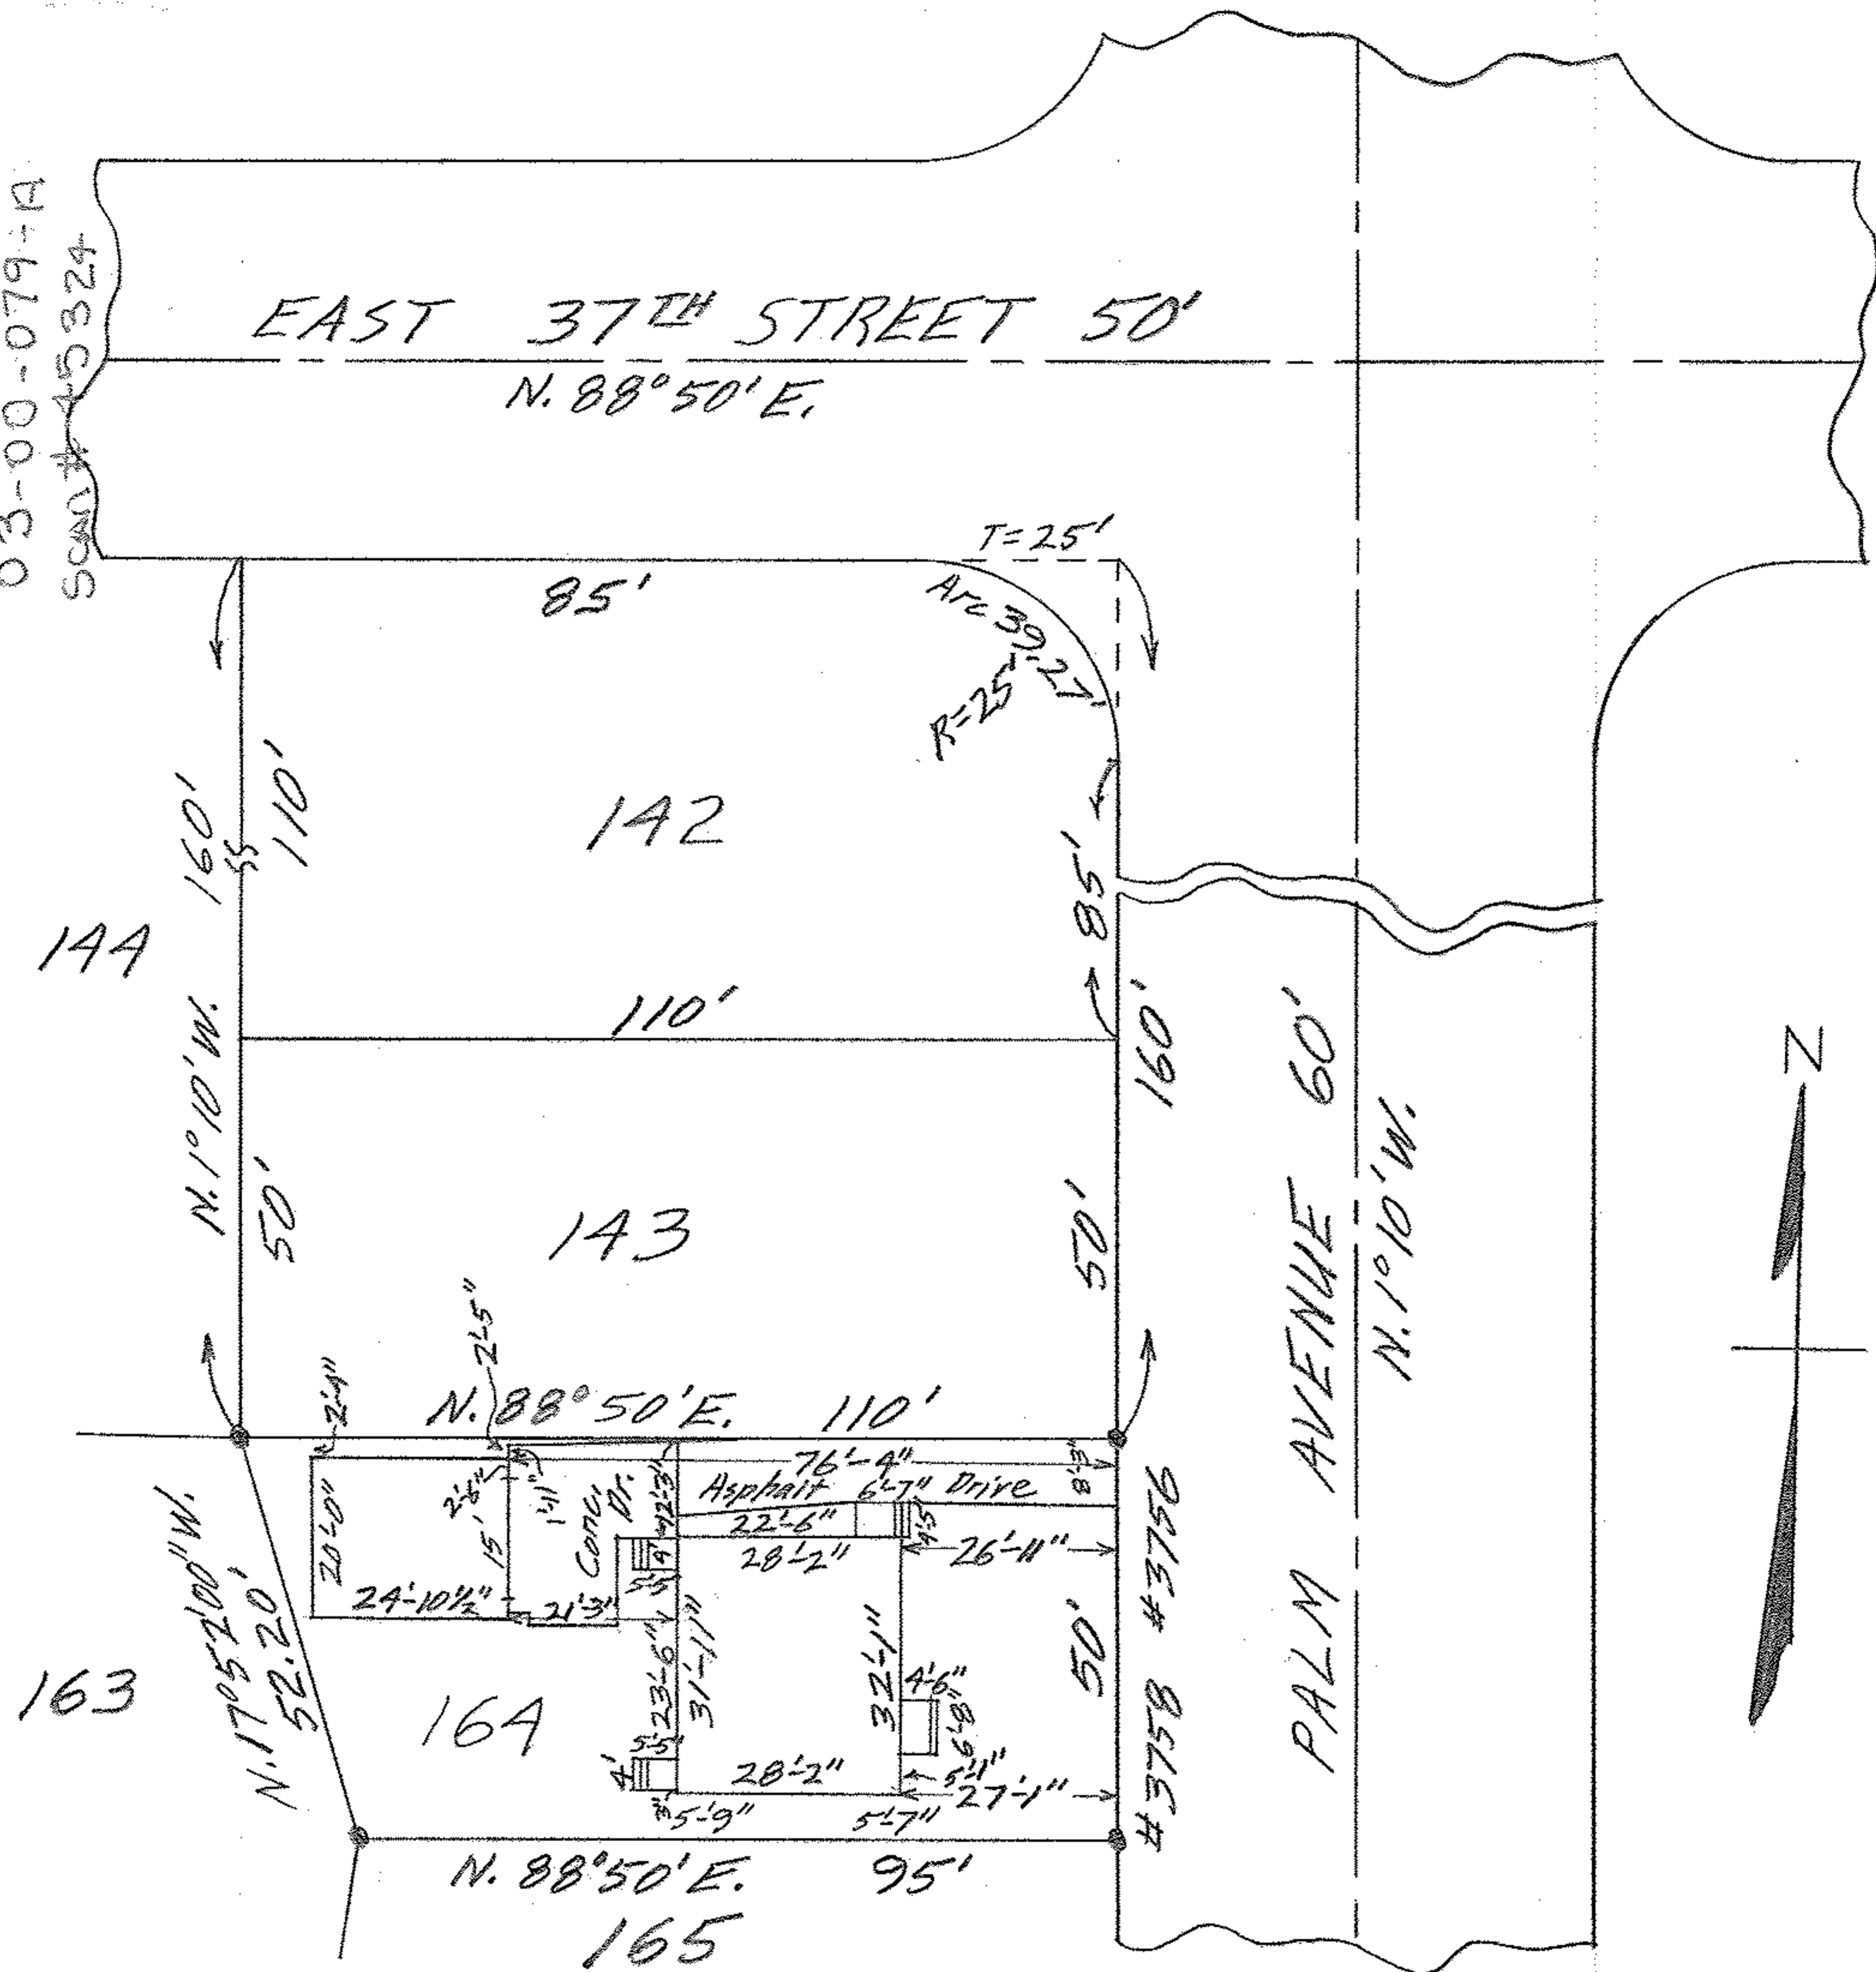

MAP OF SUB-LOT NO. 164
 HOMEWOOD ADD'N. VOL. 14 PGS. 22 & 23 PLATS
 ORIG. LOTS 79-80-81 & 99 SHEFFIELD TWP.
 LORAIN CITY - LORAIN COUNTY - OHIO
 SCALE: 1" = 30' OCT. 24-1963 9:30 A.M.
 Gary E. Penfound REG. SURVEYOR
 John W. & Helen Kosakowski - Parcel No. 1

BH 03-00-080