


03-00-080-106-015  
03-00-079-19

SCAN# 45325

HOMWOOD DRIVE 80'

N. 88° 50' E.

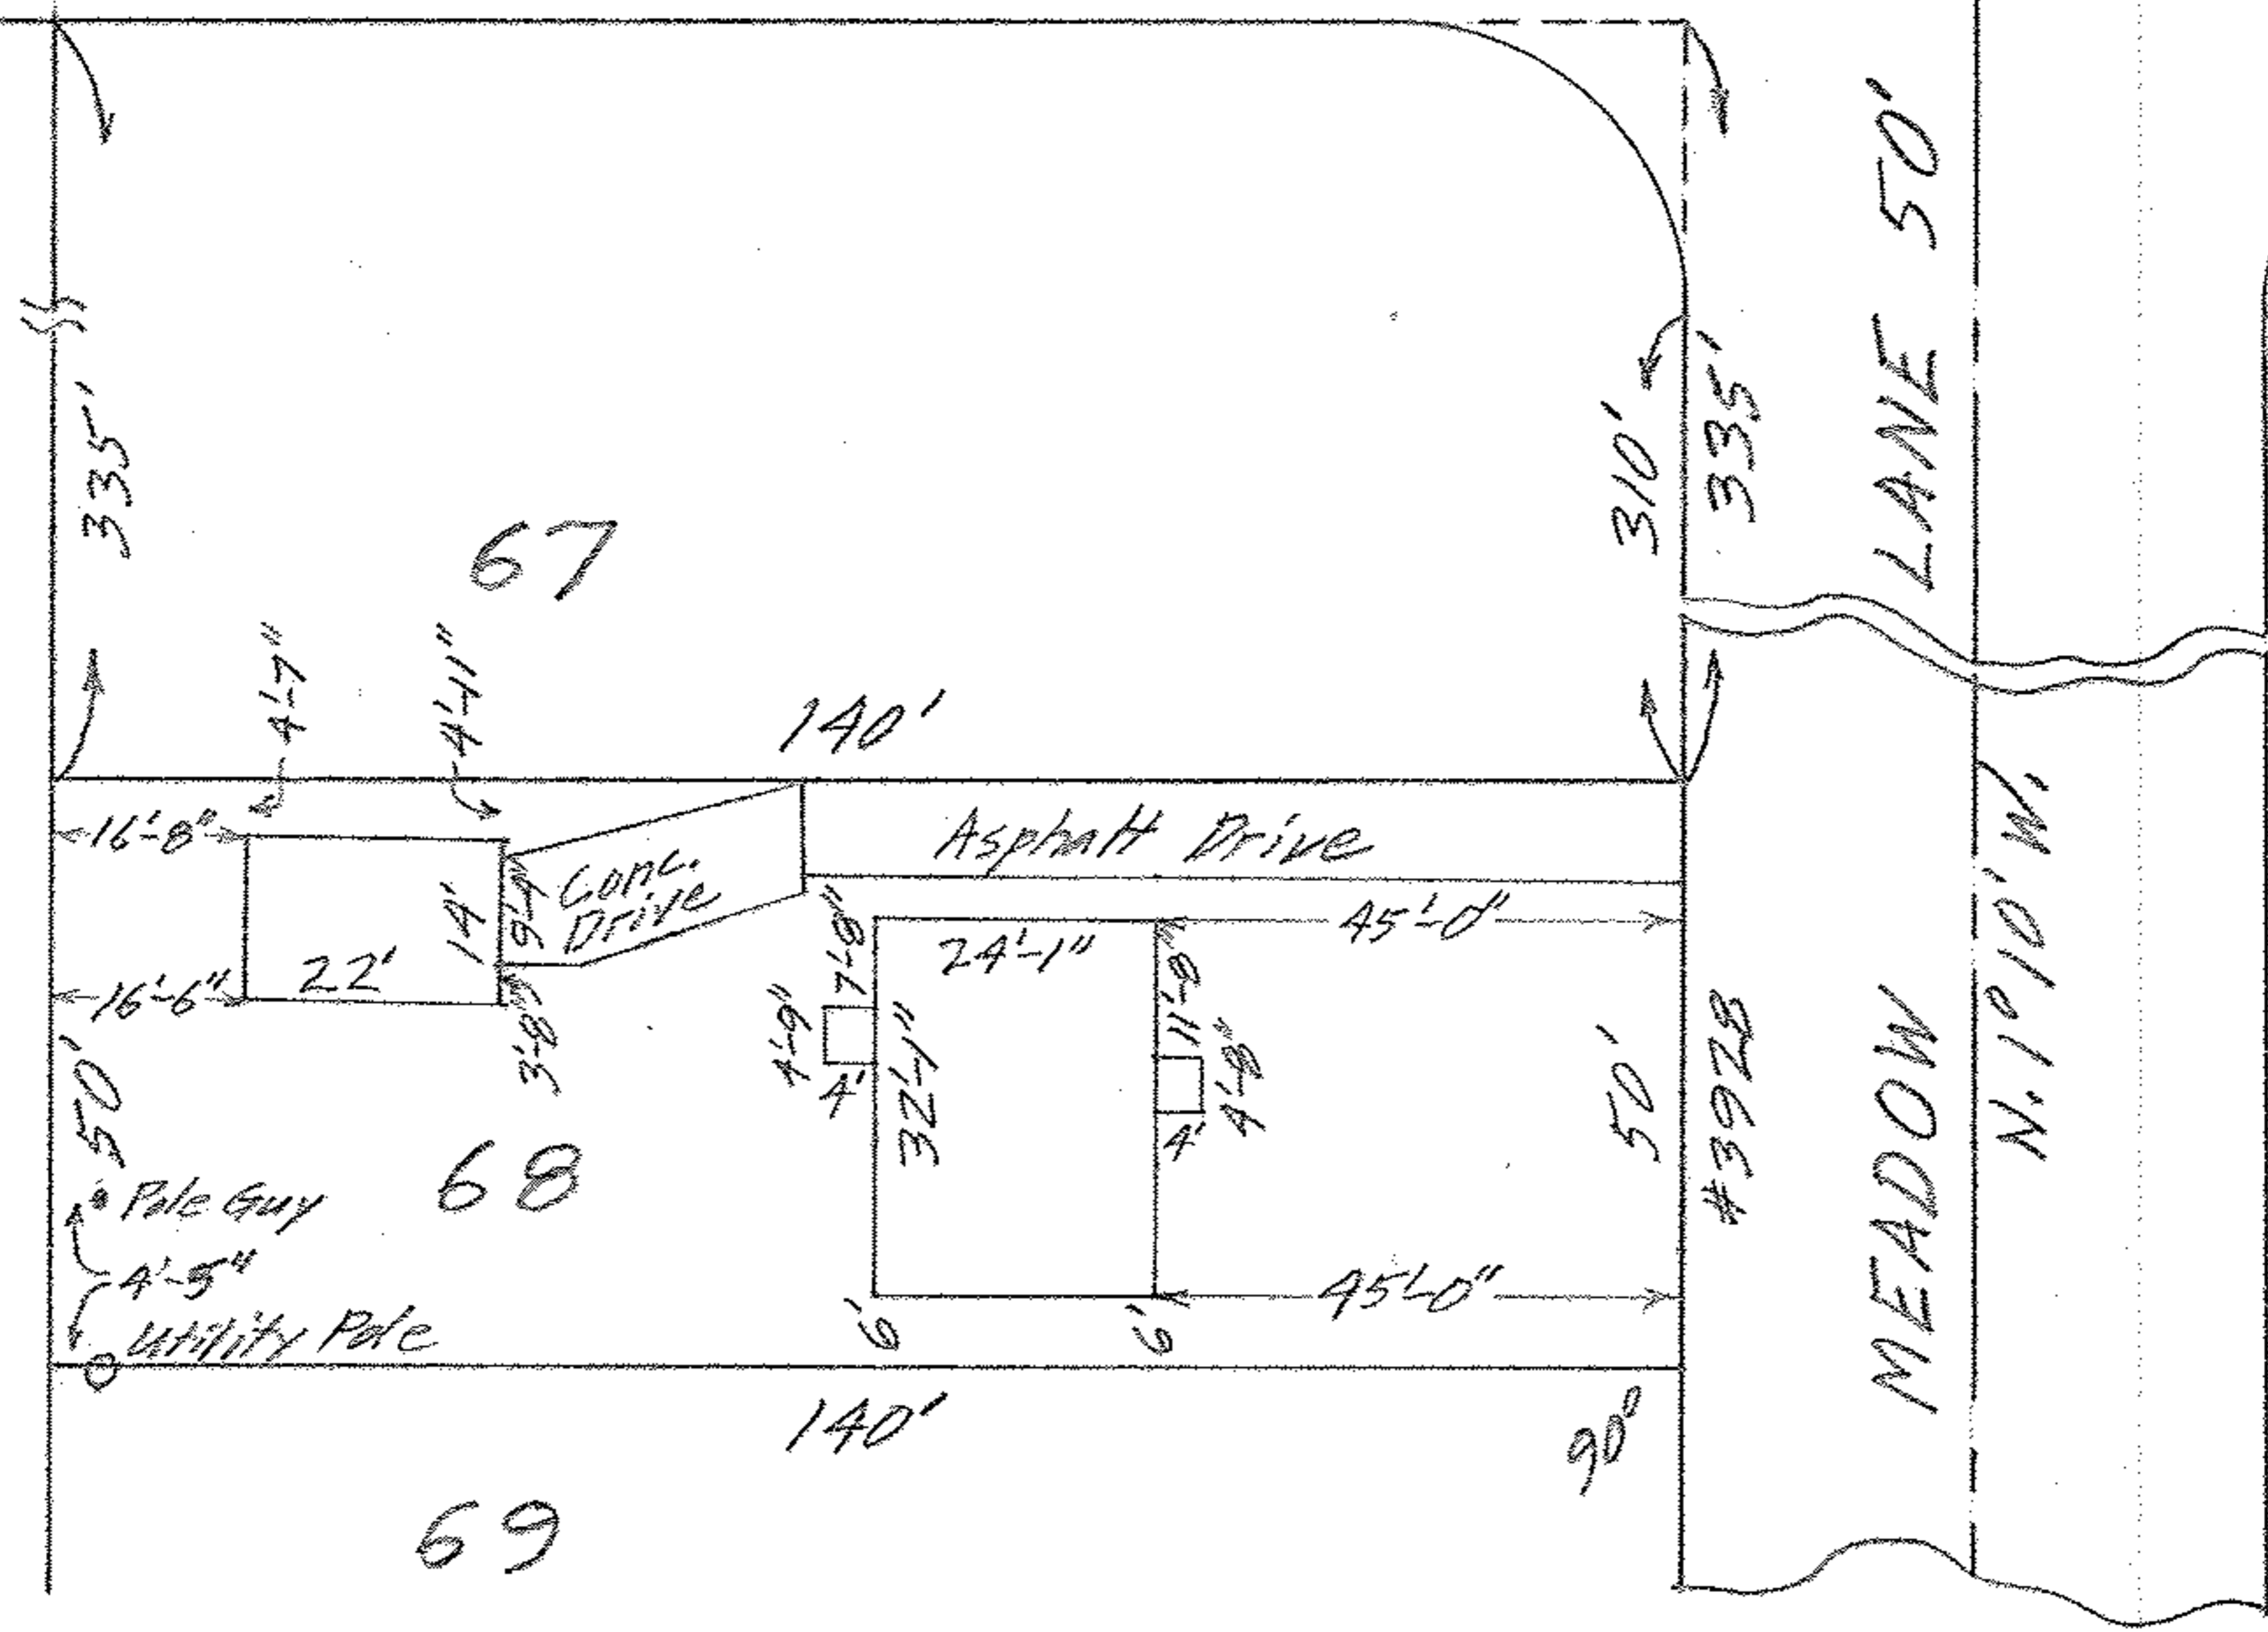

MAP OF SUB-LOT 68

HOMWOOD ADDITION VOL. 19 Pgs. 22 & 23

SHEFFIELD TWP. - LORAIN CITY

LORAIN COUNTY - OHIO

SCALE: 1" = 30' JULY 25-1960 3:30 P.M.

Dwight E. Penfound REG. SURVEYOR

Grover L. & Rebecca L. Young BH

03-00-080