


03-00-094-11-014
03-00-094-B
Sect # 45332

STATE ROUTE 57

GROVE AVENUE 100'

N. 1°10' W.

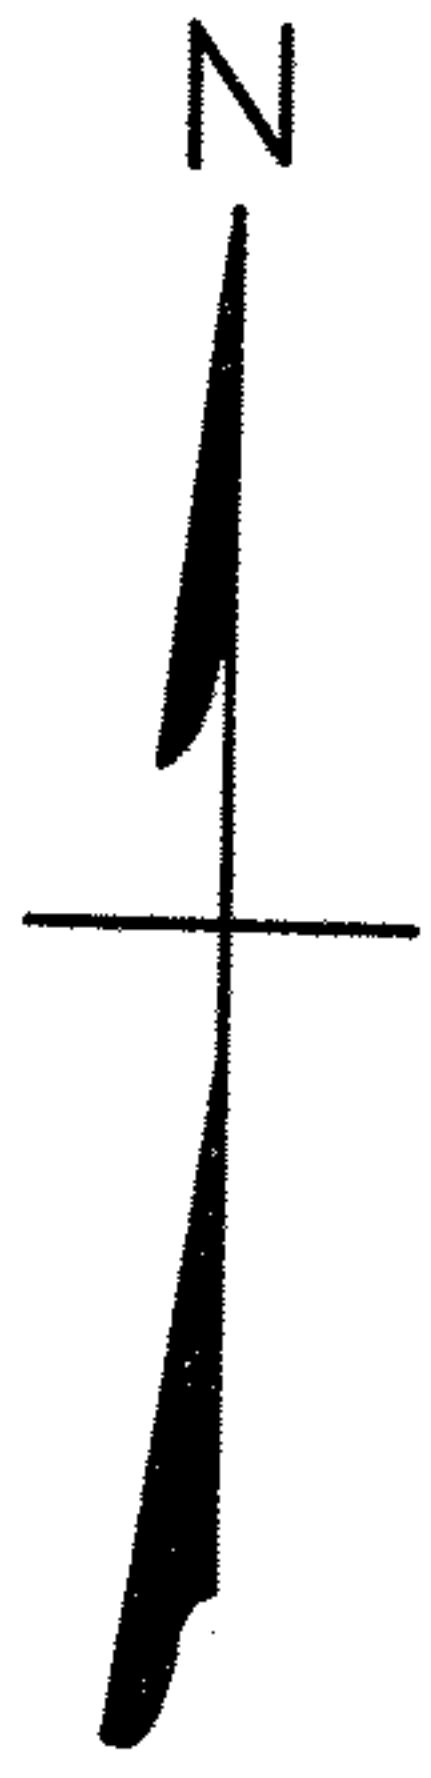

2359

2360

2361

2362

15' ALLEY
Concrete Patio Encroaches
11" into Alley, Conc. Walk
5 1/2' Encroaches 7"

15' ALLEY

50'

I.P.

135'

I.P.

120'

96'-2"

N. 1°10' W.

50'

#2213

N. 88°50' E.

EAST 32ND STREET 60'
(Formerly LOFTIN AVENUE)

MAP OF SUB-LOT NO. 2361 OF SUB'N. NO. 4 OF THE
SHEFFIELD LAND & IMPROVEMENT COMPANY'S PROPERTY
Vol. 6 Pg. 3 PLATS ORIGINAL LOT 9A SHEFFIELD TWP.
LORAIN CITY - LORAIN COUNTY - OHIO
SCALE: 1" = 30' AUG. 16-1970 6:00 P.M.

NOTE: There are no encroachments onto this
property, but concrete patio & walk encroach
into Alley. Gary E. Penfound REG. SURVEYOR NO. 4457
CITY TITLE Co. Order No. E-1254-5 Dugovich to Gonzalez

03-00-094