

03-00-095-109-007-011

03-00-095-B


Scan # 45336

EAST 28TH STREET 80'

(Formerly TENTH AVENUE) S. 88° 50' W.

SENECA AVE. 80'

S. 1° 10' E.

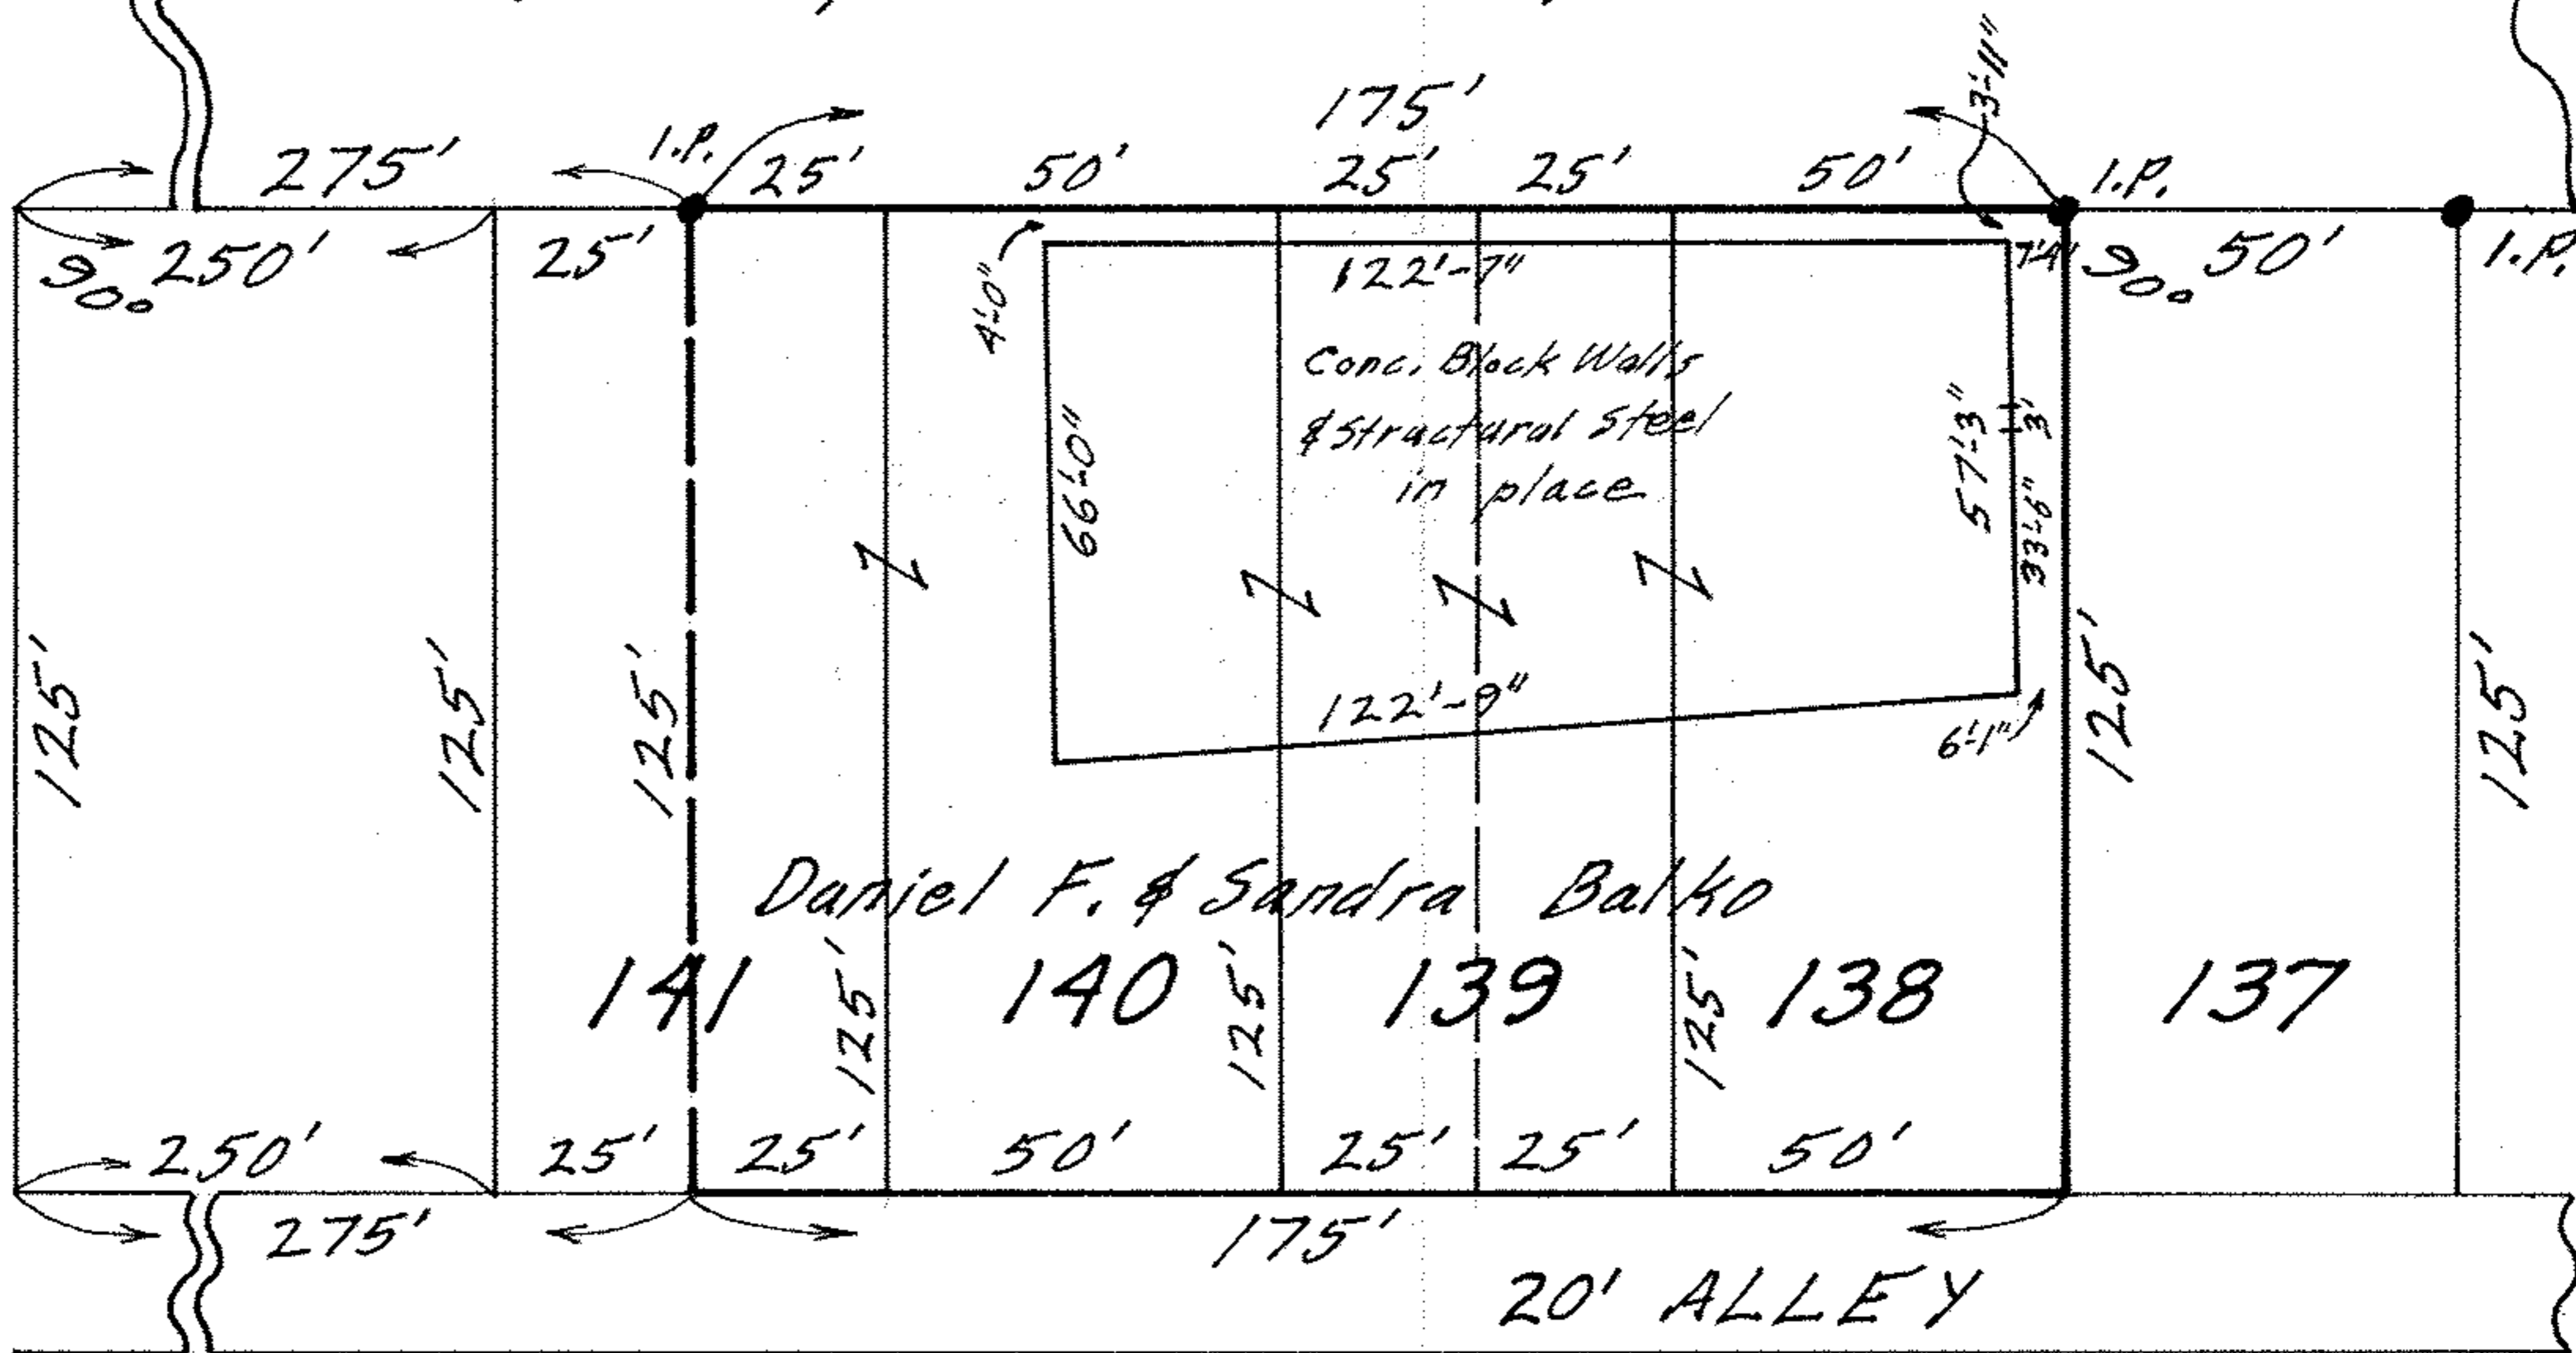

MAP OF SUB-LOTS 138, 139, 140 AND EASTERLY
 ONE-HALF OF SUB-LOT 141 OF THE SHEFFIELD
 LAND COMPANY'S FIRST SUB'D. VOL. 4 Pgs. 23 & 24
 SHEFFIELD TWP. - LORAIN CITY - LORAIN CO. - OHIO
 SCALE: 1" = 40' APRIL 26 - 1969 6:30 P.M.
 Gary E. Penfound REG. SURVEYOR

03-00-095