

03-00-095-110-005


03-00-095-6  
Scan # 45337

EAST 30<sup>TH</sup> ST. 80'  
N. 88° 50' E.

#1916



5.1° 10' E.  
SENECA AVE. 80'

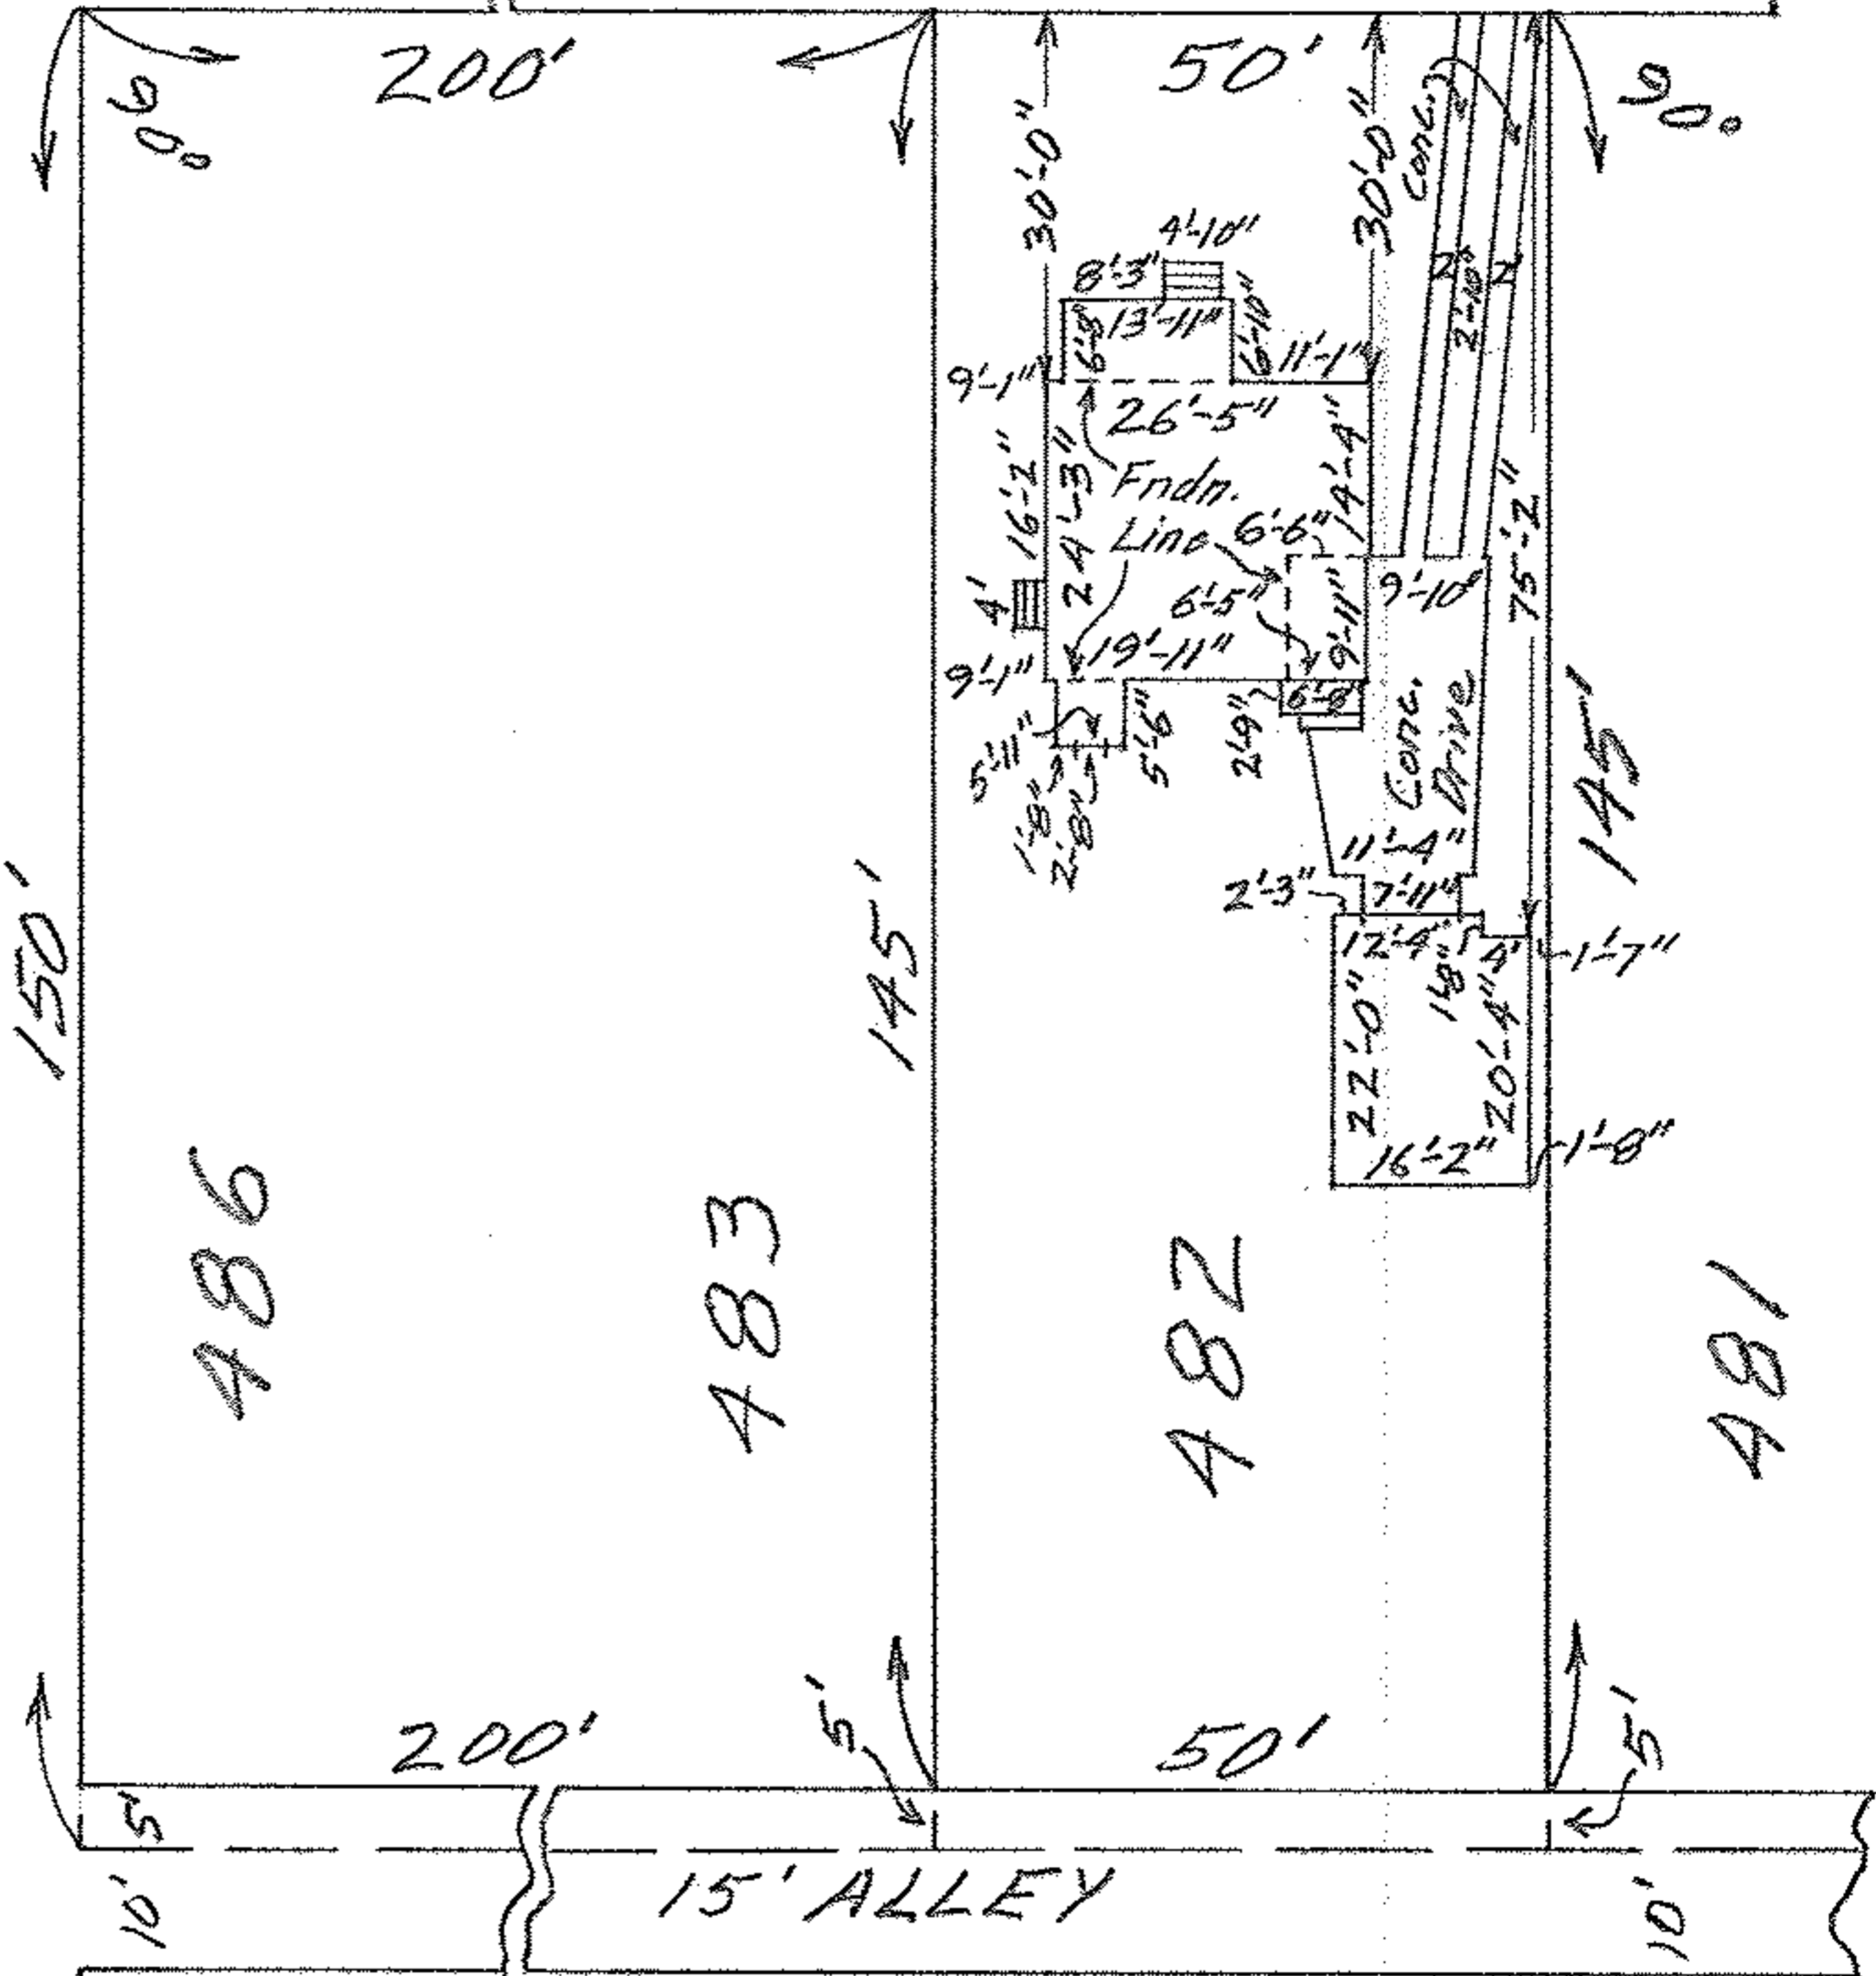

MAP OF SUB-LOT NO. 482

THE SHEFFIELD LAND CO.'S SUB'D. NO. 1  
VOL. 4 PGS. 23-24 PLATS

LORAIN CITY - LORAIN COUNTY - OHIO

SCALE: 1" = 30'      OCT. 9-1963 5:30 P.M.

Gary E. Perfound REG. SURVEYOR

Jose S. & Carmen J. Gonzalez

W W

03-00-095